
HAROLD H. KOLB

REGISTERED PROFESSIONAL LAND SURVEYOR
LAKE GENEVA, WISCONSIN

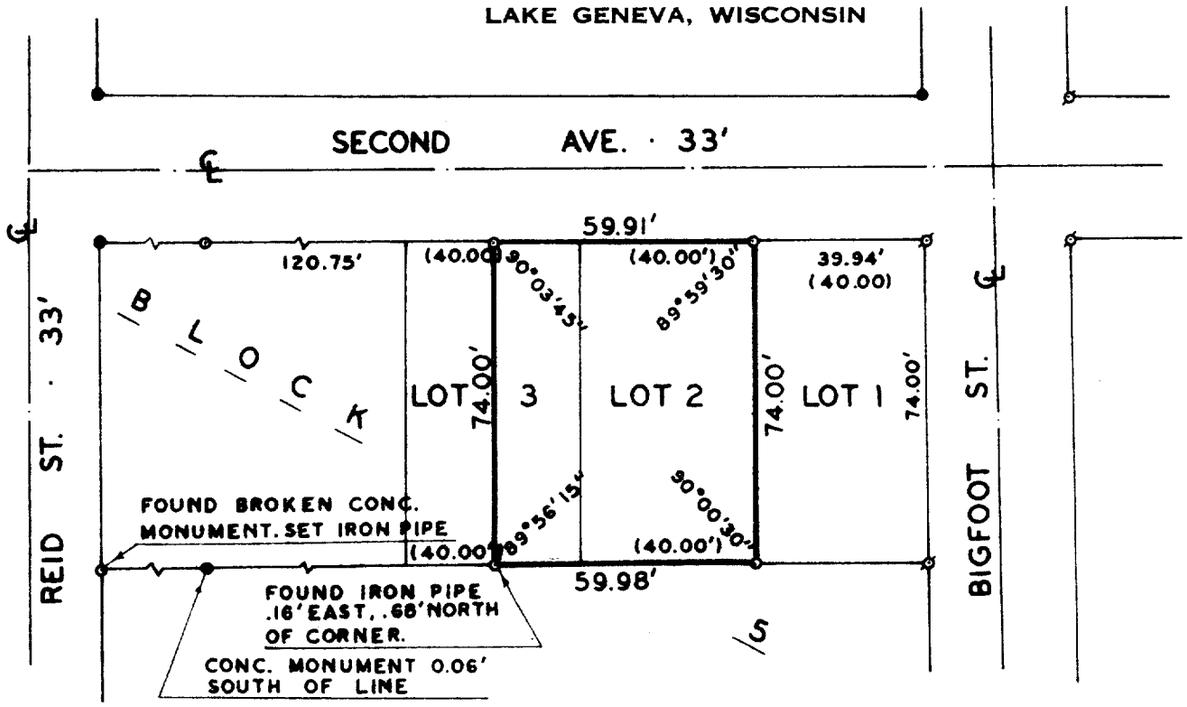

PLAT OF SURVEY OF

LOT 2 AND THE EAST 1/2 OF LOT 3, BLOCK 5, D.A. REIDS ADDITION TO REIDS PARK, VILLAGE OF FONTANA-ON-GENEVA LAKE, WALWORTH COUNTY, WISCONSIN.

OWNER: WILLIAM PAVIN

ACCURACY: DISTANCE ± 0.01'
ANGLES ± 05"
ERROR OF CLOSURE LESS THAN 1/3000

N

SCALE · 1" = 40'

LEGEND

- ϕ — IRON PIPE FOUND
- O — IRON PIPE PLACED
- ● — CONCRETE MONUMENT FOUND
- x — SPIKE
- ( ) — AS PLATTED

WISCONSIN HAROLD H. KOLB S-187 LAKE GENEVA, WIS LAND SURVEYOR

I. HAROLD H. KOLB, DO HEREBY CERTIFY THAT I HAVE SURVEYED THE PROPERTY HEREON DESCRIBED ACCORDING TO THE OFFICIAL RECORDS, AND THAT THE PLAT HEREON IS A CORRECT REPRESENTATION OF THE LOT LINES.

Harold H. Kolb

HAROLD H. KOLB
WISCONSIN REGISTERED LAND SURVEYOR, S-187
DATE Dec 23, 1975

SRA-31

5-419

BRUNING 40-105 1M-6-71