
PLAT OF SURVEY

OF

UNIT 149 OF ABBEY SPRINGS

A parcel of land located in the Southwest ¼ of the Southwest ¼ of Section 18, Town 1 North Range 17 East, Village of Fontana-on-Geneva Lake, Walworth County, Wisconsin, being more particularly described as follows:

Beginning at the South-East corner of Unit 150 of Abbey Springs; thence N4°-25'E, 141.34 feet; thence S88°-54'E, 80.00 feet; thence S4°-25'W, 145.37 feet; thence N76°-36'W, 21.15 feet; thence N89°-21'-30"W, 59.06 feet to the point of beginning, containing 0.2597 acres more or less.

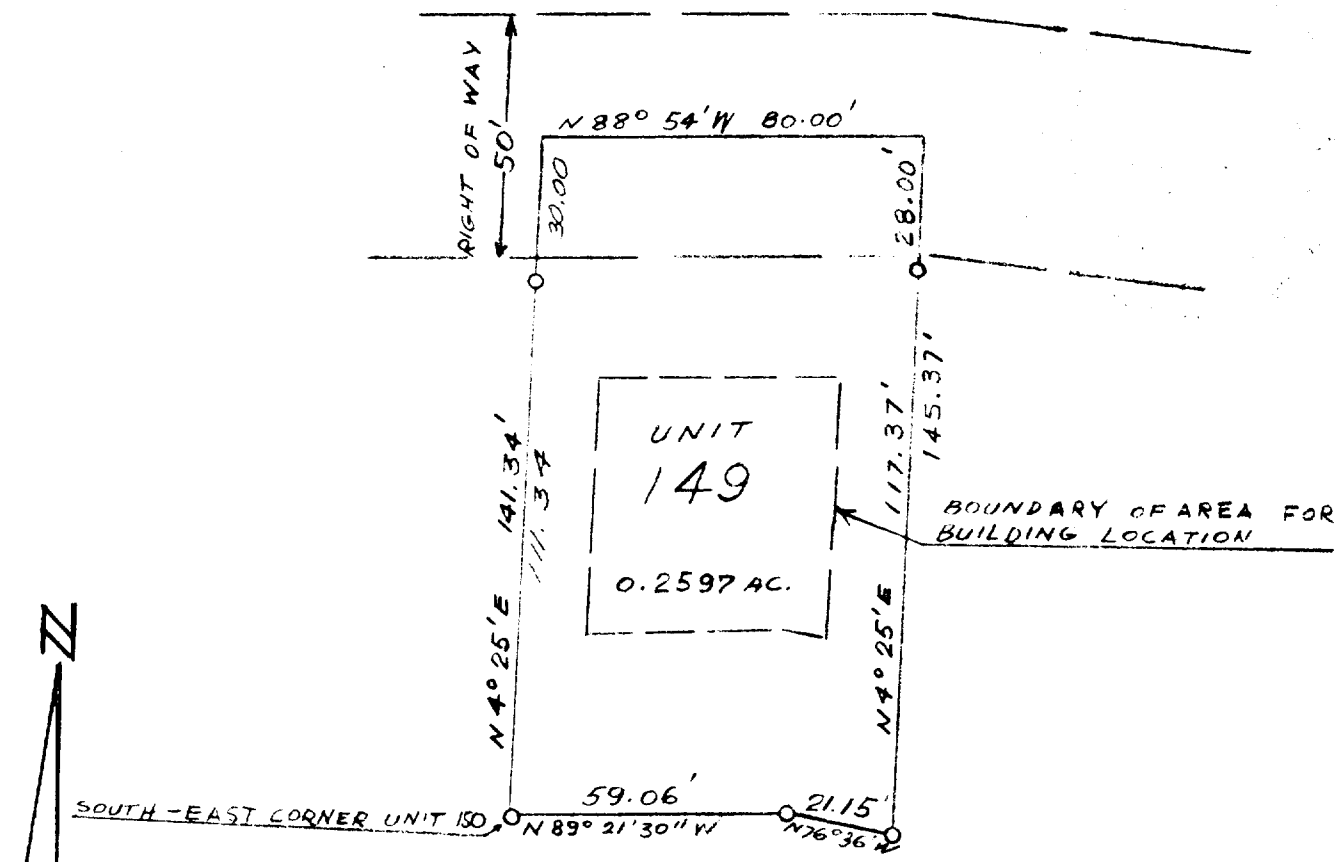

LEGEND

○ — Iron Pipe

● — Concrete Monument

Scale 1" = 40'

SURVEY AND PLAT BY

JENSEN & JOHNSON, INC.

CIVIL ENGINEERS AND SURVEYORS

Elkhorn, Wisconsin

WE CERTIFY: That we have surveyed the above described property and that the plat shown hereon is an accurate survey and a true representation thereof and correctly shows the exterior boundary lines and all divisions of said property.

Date July 1972

LLOYD L. JENSEN,

Wisconsin Registered Land Surveyor, No. S-211

SCDB4-149

5-459.149

PLAT 175H