
HAROLD H. KOLB

REGISTERED PROFESSIONAL LAND SURVEYOR
LAKE GENEVA, WISCONSIN

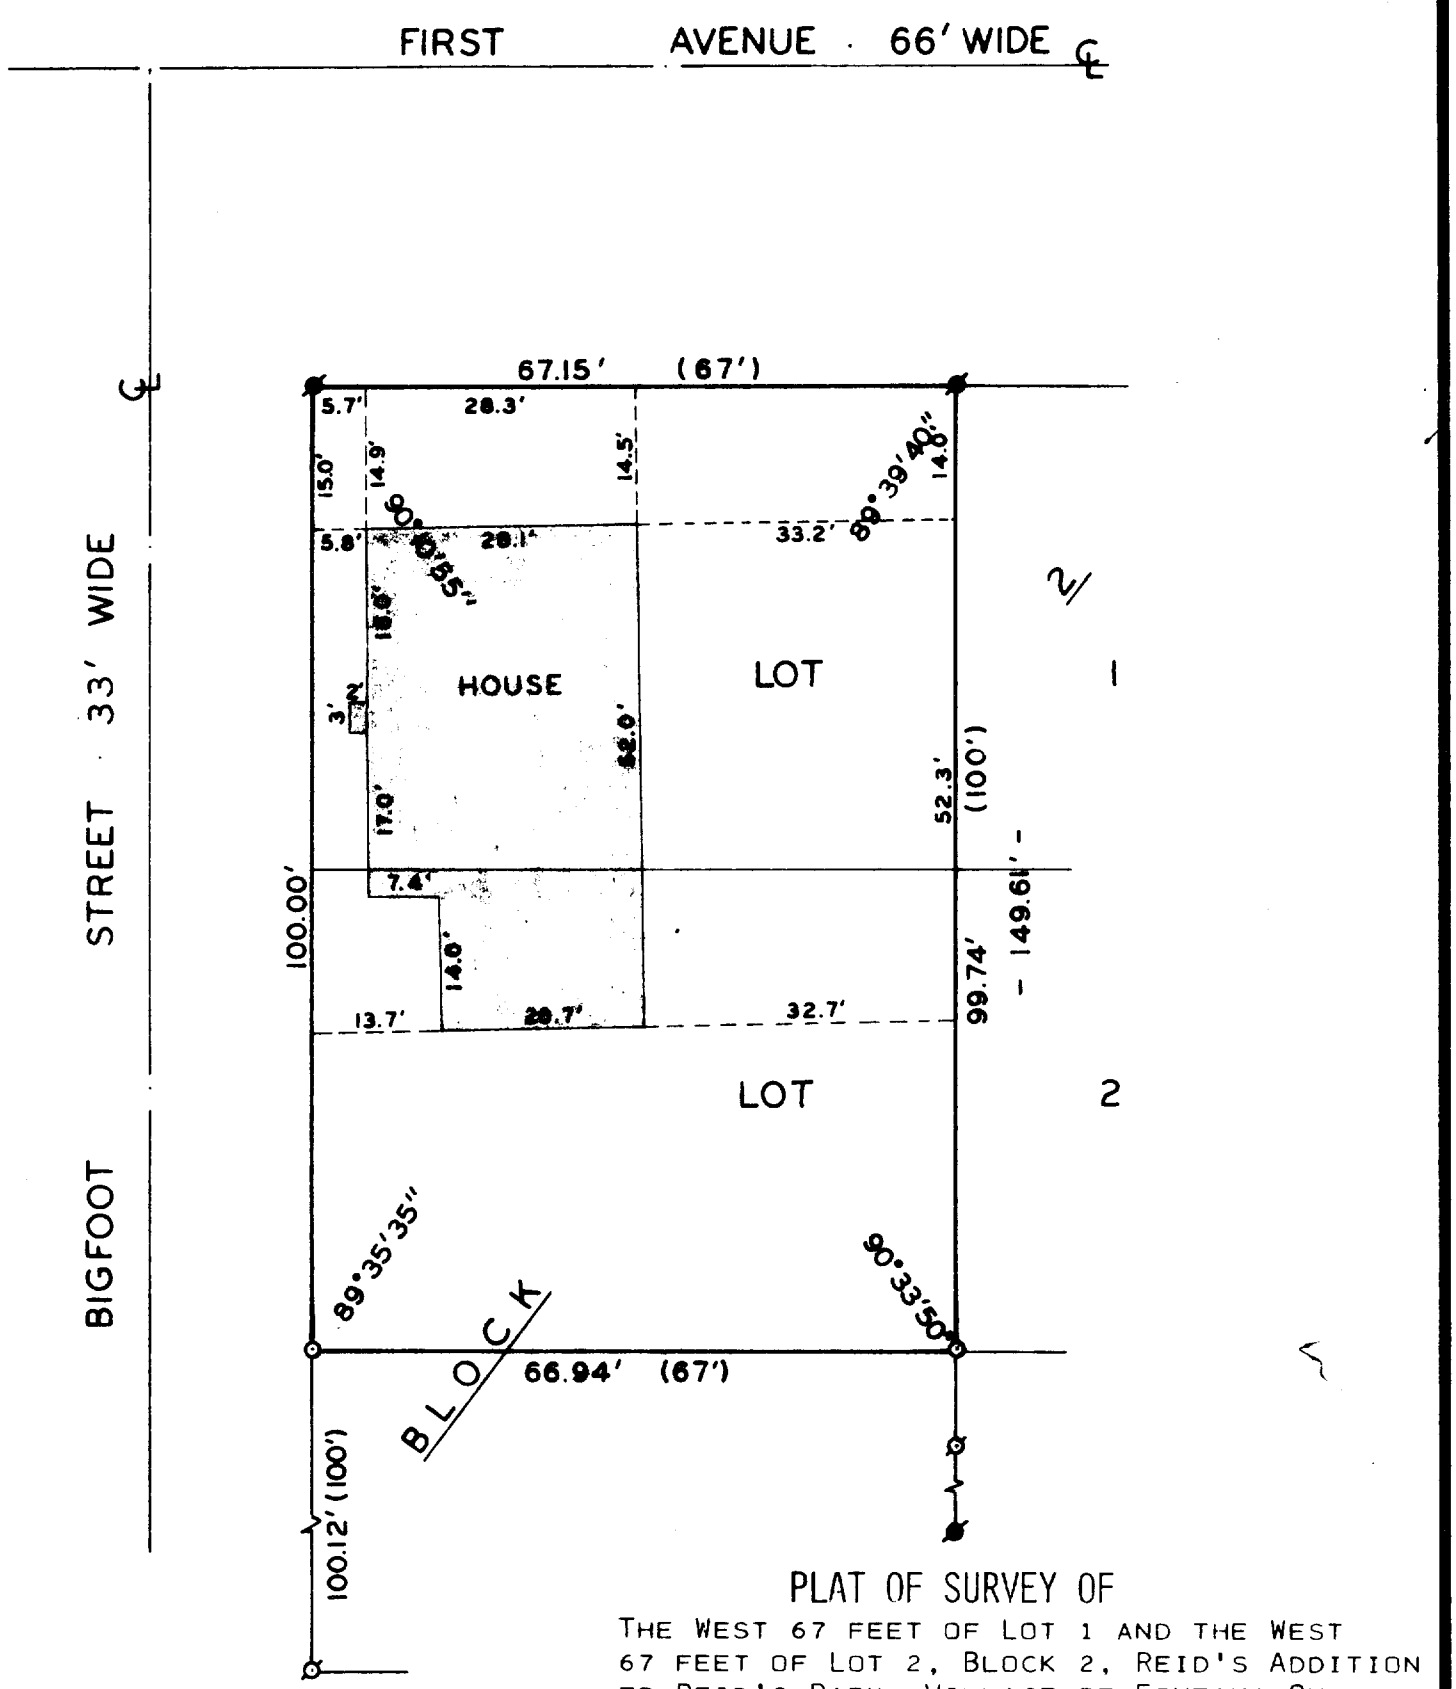

PLAT OF SURVEY OF

THE WEST 67 FEET OF LOT 1 AND THE WEST 67 FEET OF LOT 2, BLOCK 2, REID'S ADDITION TO REID'S PARK, VILLAGE OF FONTANA-ON-GENEVA LAKE, WALWORTH COUNTY, WISCONSIN.

ORDERED BY: FRED A. JACOBSEN

ACCURACY: DISTANCES ± 0.01'
ANGLES ± 05"
ERROR OF CLOSURE--LESS THAN ONE PART IN 3000

WISCONSIN HAROLD H KOLB S-187 LAKE GENEVA WIS LAND SURVEYOR

N

SCALE · 1"= 20'

LEGEND

O — IRON PIPE PLACED ⌀-Iron Pipe Found
● — CONCRETE MONUMENT Found
( ) _ AS DESCRIBED

Harold H. Kolb
HAROLD H. KOLB
WISCONSIN REGISTERED LAND SURVEYOR, S-187
DATE March 25, 1977

5-469

BRUNING 40-105 1M-6-71 SRA - 9