
HOME OFFICE
116 E. CHESTNUT STREET
BURLINGTON, WISCONSIN 53105
PHONE: 414-763-2652
414-763-7834

ROBERS & BOYD, INC.
CONSULTING ENGINEERS
LAND SURVEYORS

BRANCH OFFICE
809 - 43RD STREET
KENOSHA, WISCONSIN 53140
PHONE: 414-658-4488

PLAT OF SURVEY AND BUILDING LOCATION FOR FLORENCE DRAKE OF

Lot 4 and 5 of Block 1, Assessors Plat #1 of C. L. Douglass Addition, Village of Fontana-on-Geneva Lake, Walworth County, Wisconsin.

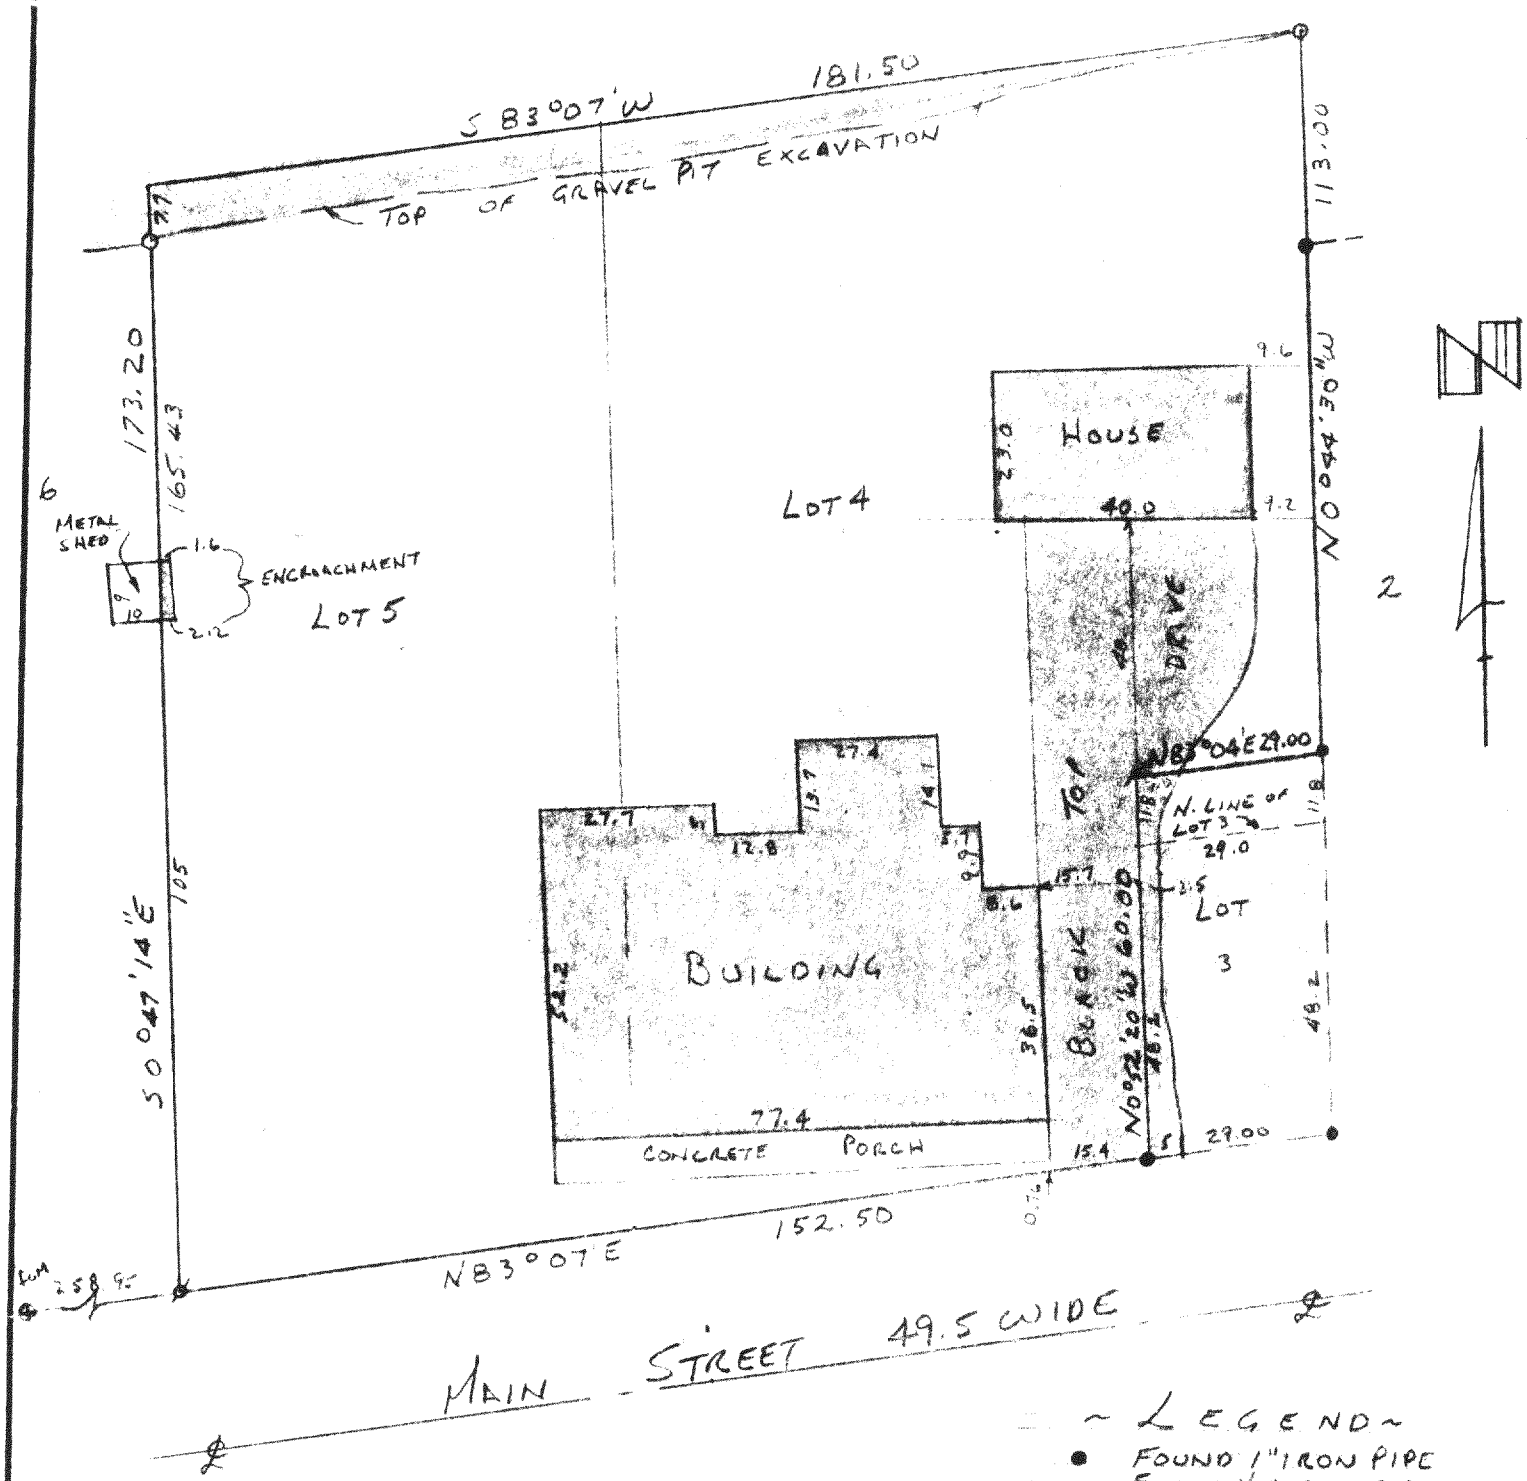

~ LEGEND ~

- ● FOUND 1" IRON PIPE
- • FOUND ½" IRON PIPE
- ✗ FOUND RAILROAD SPIKE
- ○ SET 1" IRON PIPE
- ⌀ SET RAILROAD SPIKE

WISCONSIN
KENNETH R. REESMAN
S-1351
BURLINGTON WIS.
LAND SURVEYOR

"I CERTIFY THAT I HAVE SURVEYED THE ABOVE DESCRIBED PROPERTY AND THAT THE ABOVE PLAT IS AN ACCURATE SURVEY AND A TRUE REPRESENTATION THEREOF AND CORRECTLY SHOWS THE EXTERIOR BOUNDARY LINES AND LOCATION OF BUILDINGS AND OTHER IMPROVEMENTS ON SAID PROPERTY AND THE CORRECT MEASUREMENTS THEREOF."

Kenneth R. Reesman
WISCONSIN REGISTERED LAND SURVEYOR

9/12/77
DATE

5-480
77194
JOB NUMBER

ST FVHR

K & E 10-7155 250