
44-12

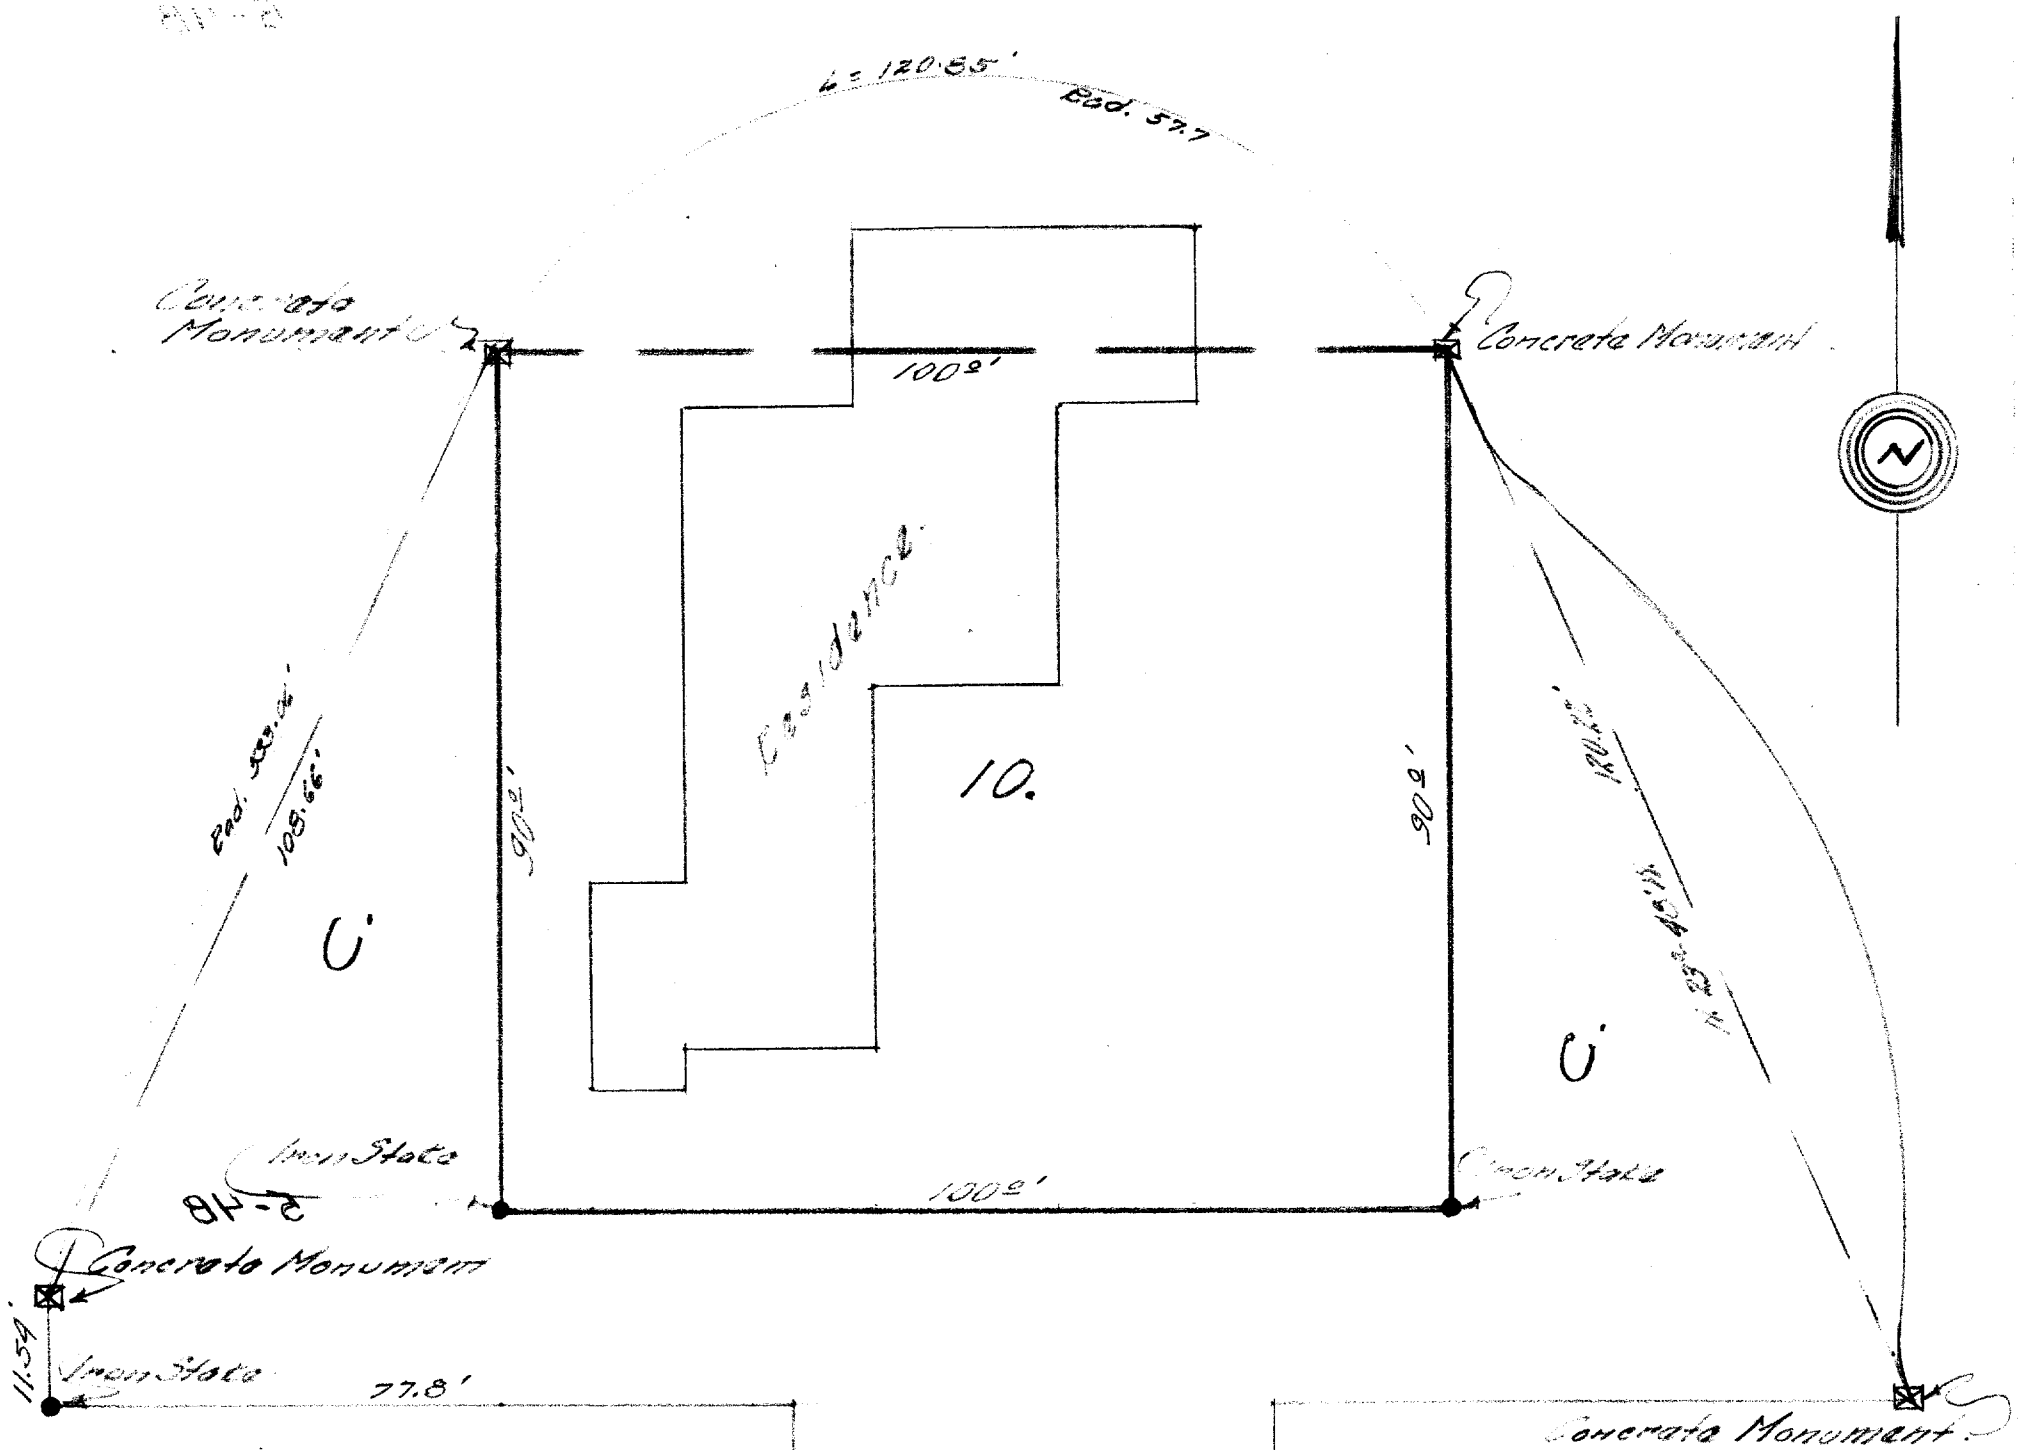

DESCRIPTION:

Lot 10 Club Unique Subdivision of a portion of the N.E.¼ of the S.E.¼ of Section 14, Township 1 North, Range 16 East of the 4th P.M.; Walworth County Wis.

CERTIFICATE:

I he reby certify that I have on this thetwenty first day of June 1944 surveyed the above described property, according to the official records on file in the Office of the Recorder of Deeds in and for Walworth County Wisconsin,and find that no encroachments exist, and that the distances and coursesshown above are identical with the distances and bearings measured at the site on this day.

Signed this 22nd day of June 1944

Joseph M. Biagi

Joseph M. Biagi
Elkhorn Wisconsin.

SURVEY
of
Lot 10 Club Unique
a
Subdivision
of

N.E.¼ of the S.E.¼ of Section 14
T,1.N; R.16.E.; of the 4thP.M.
Walworth County Wisconsin.
for

Arthur B. Jensen
Fontana Wisconsin.

SCB-10

5-4B