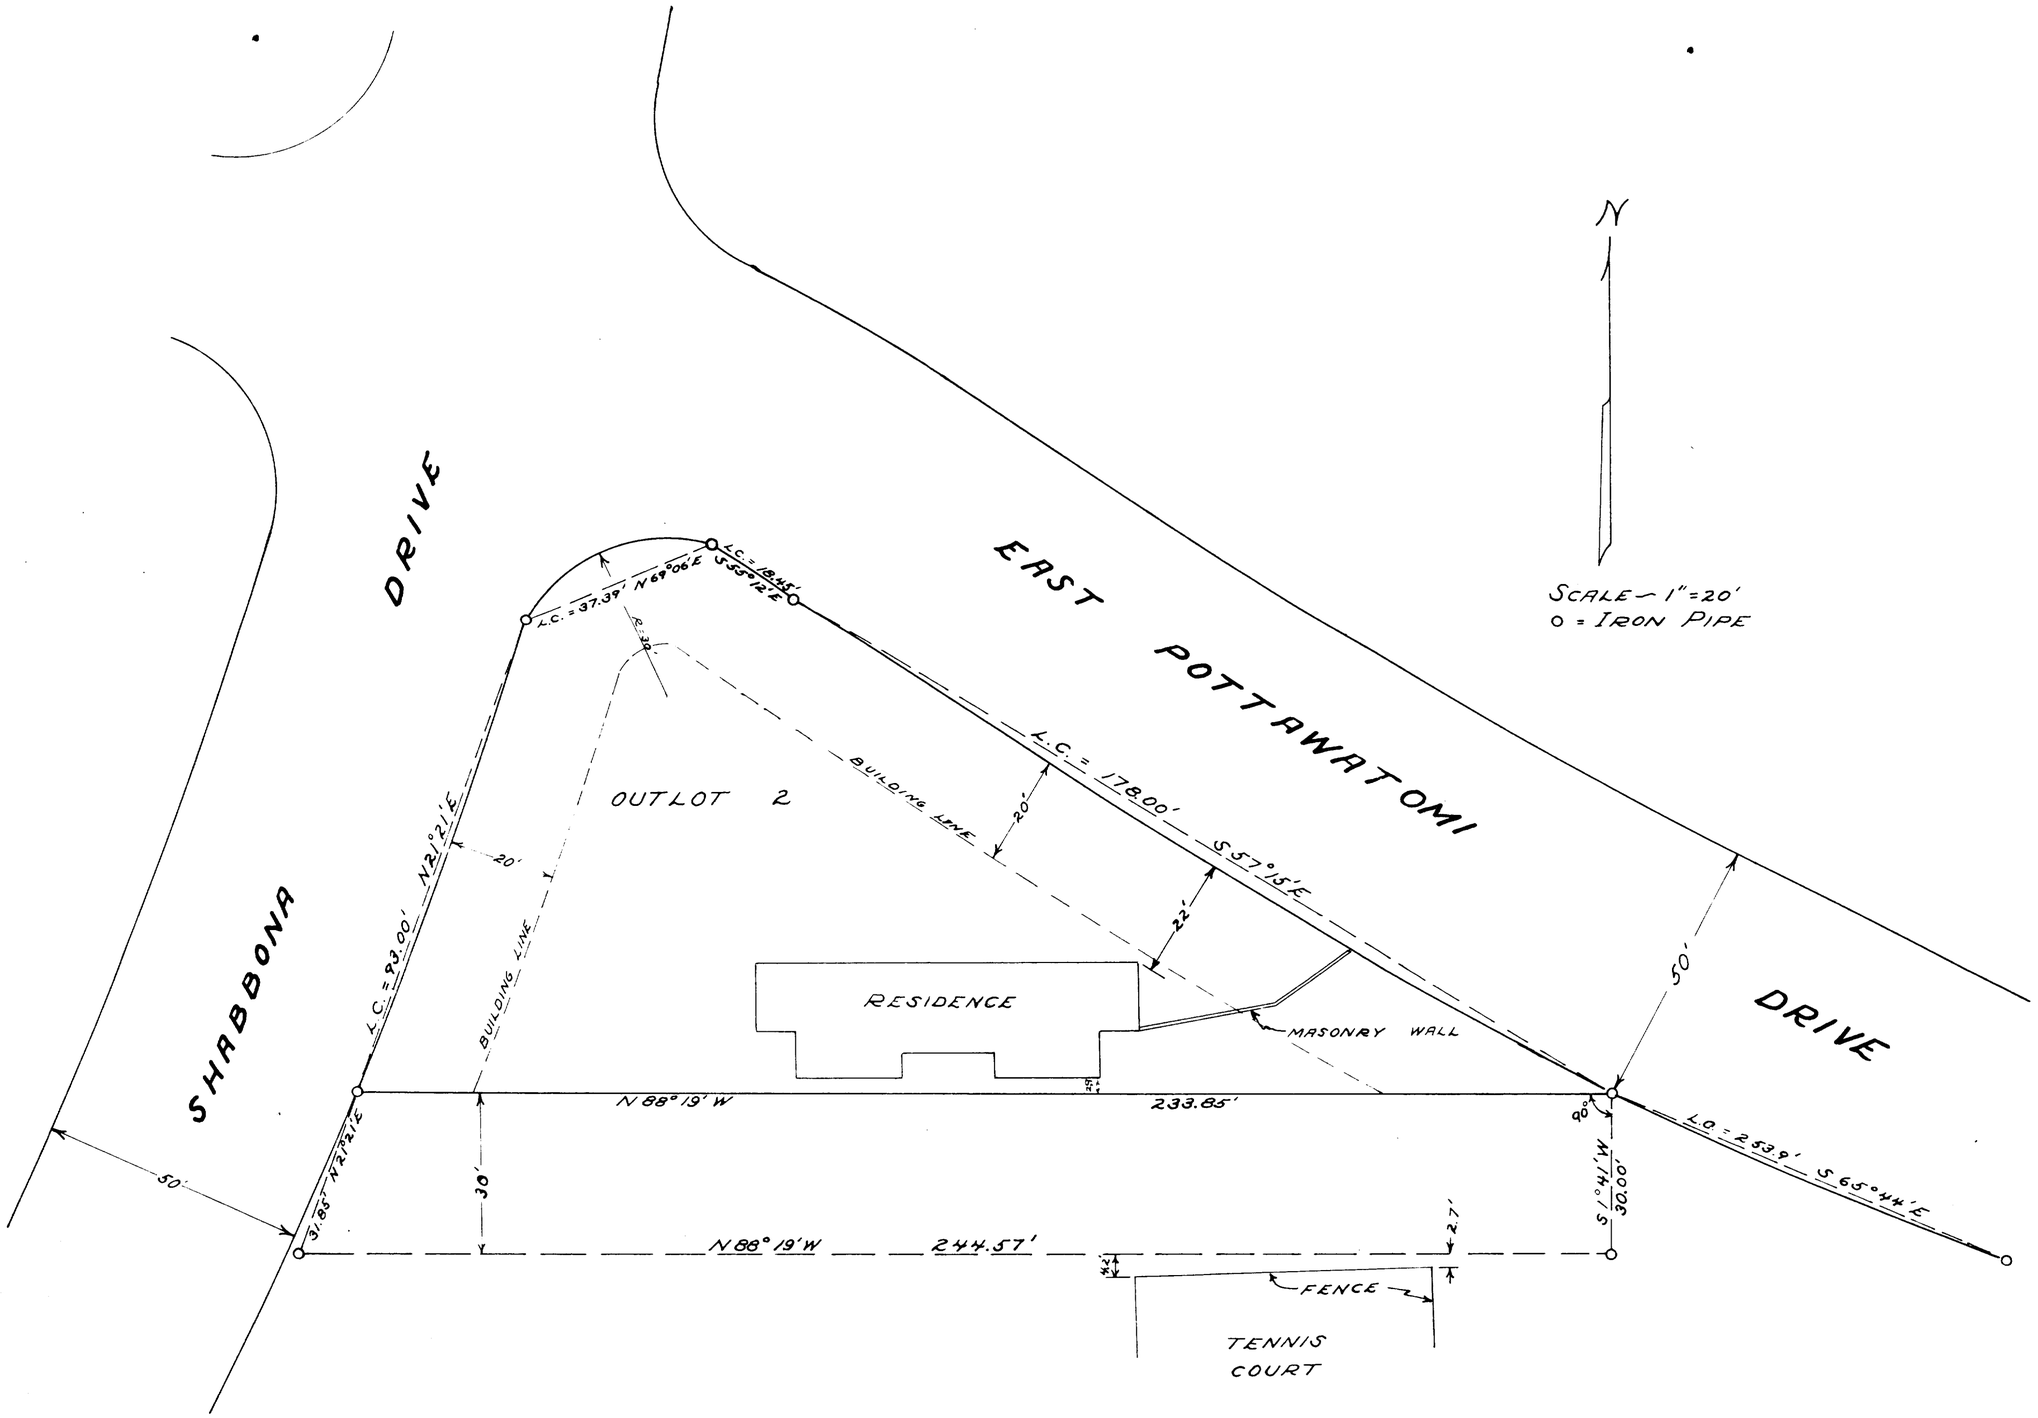

PLAT of SURVEY

OUTLOT 2 OF UNIT 3 OF COUNTRY CLUB ESTATES IN FONTANA-ON-GENEVA LAKE, WALWORTH COUNTY, WISCONSIN, AND A STRIP OF LAND 30 FEET WIDE ADJOINING SAID OUTLOT 2 ON THE SOUTH.

JANUARY 31, 1949

H. E. Johnson
SURVEYOR

SC03-52

5-50J