


DUNHAM SURVEYING, S.C.
SURVEYING & SUBDIVIDING
DELAVAN, WISCONSIN 53115

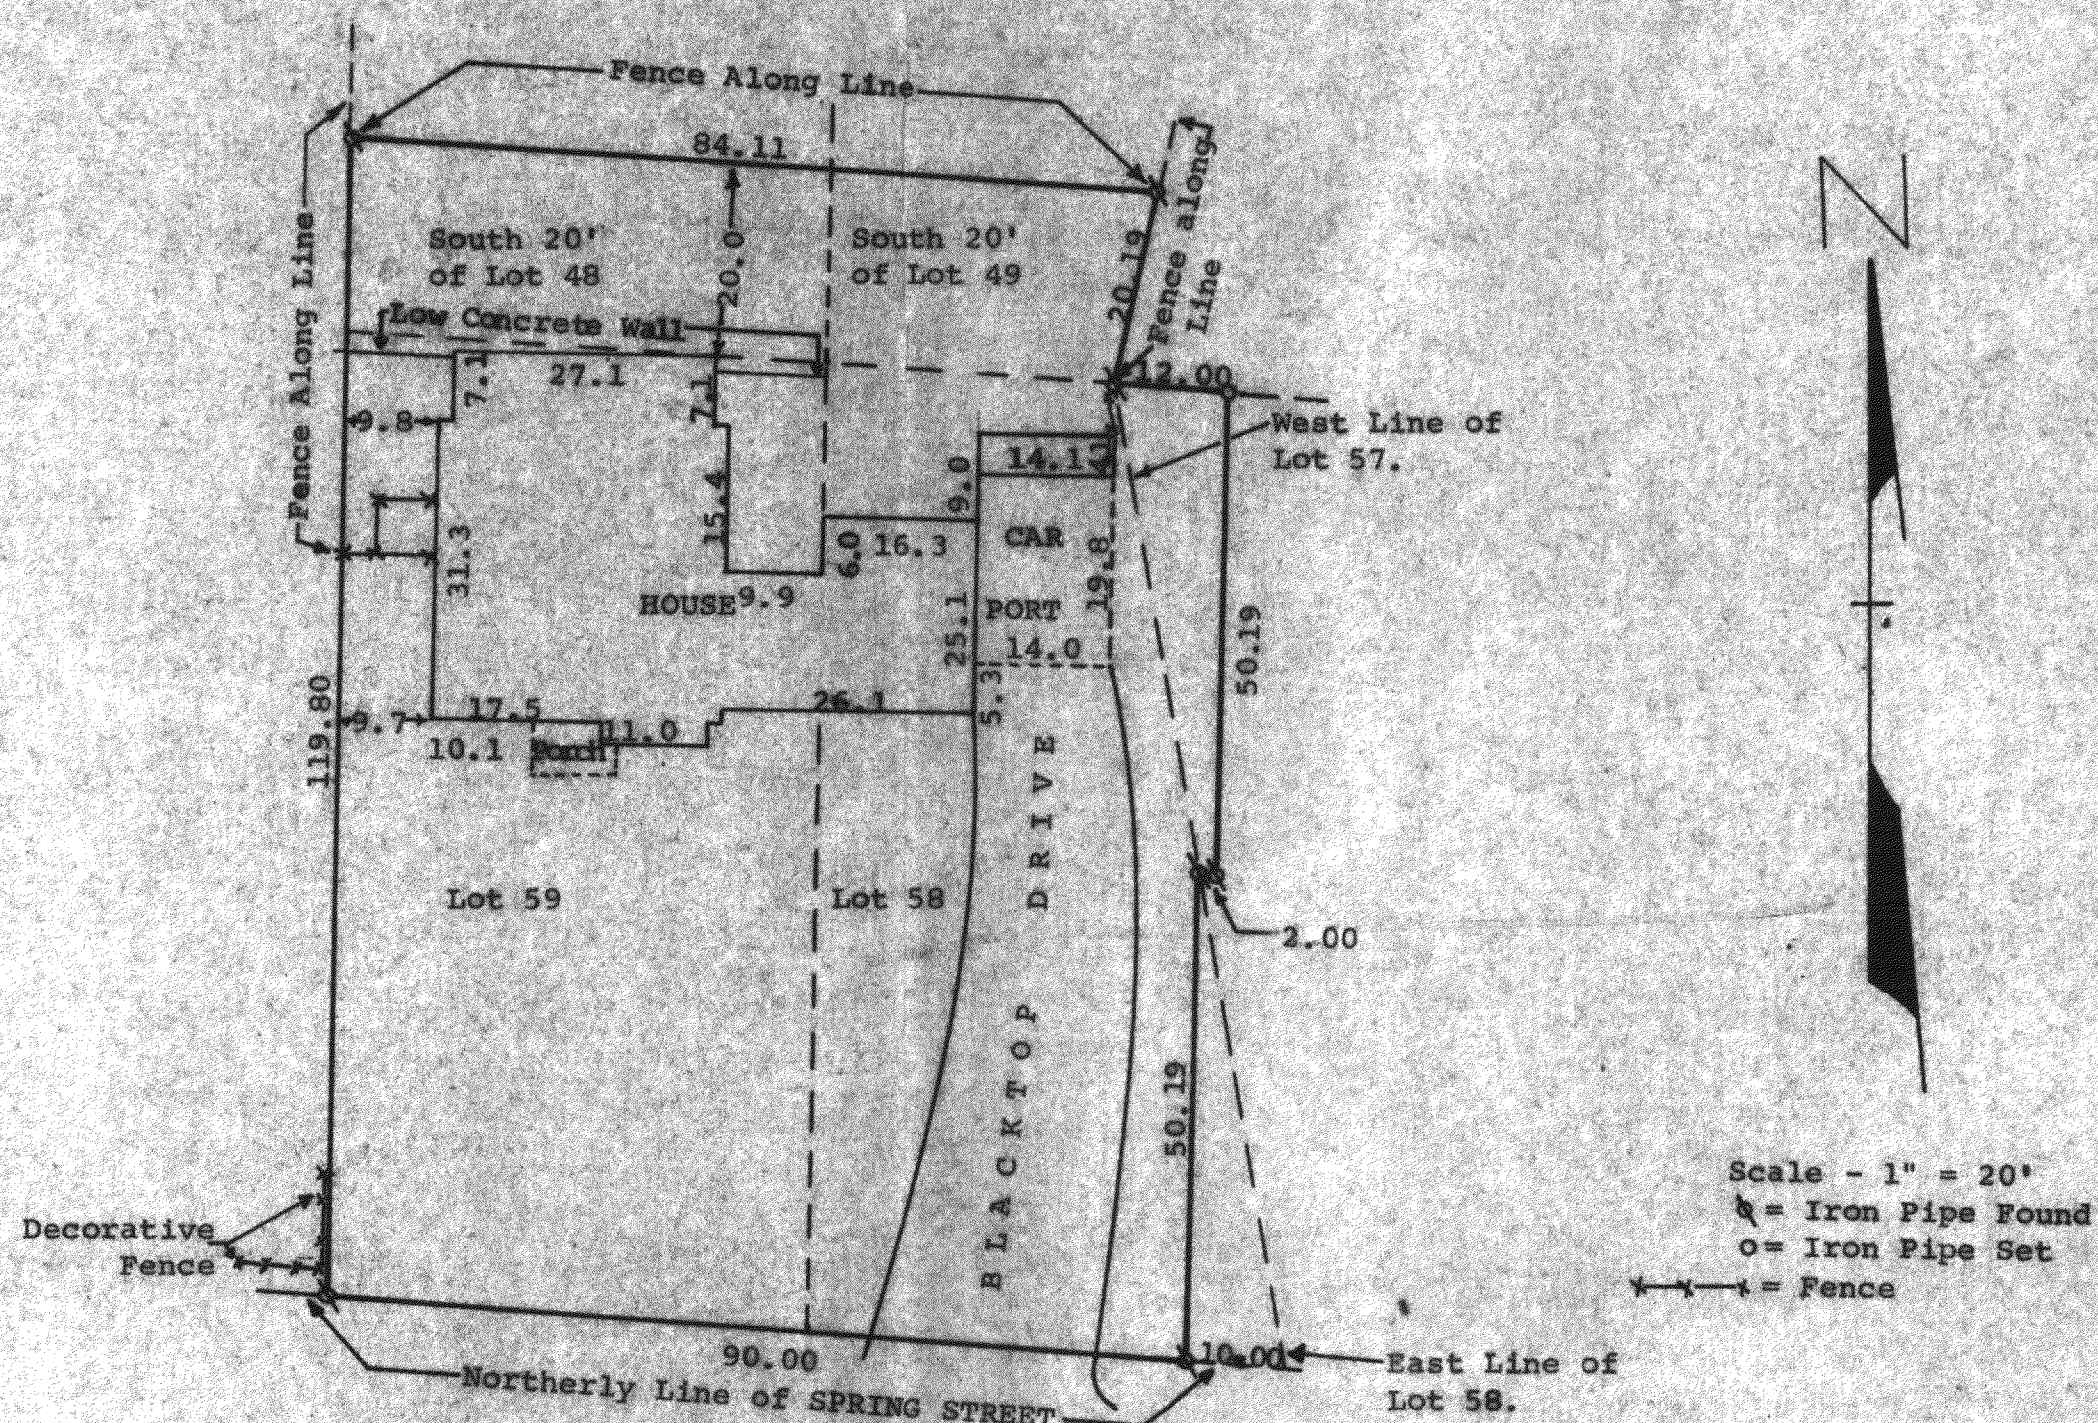

STATE OF WISCONSIN)
COUNTY OF WALWORTH)

I, James M. Dunham, Surveyor, certify that I have surveyed the property described as follows:

The following parcels of land located in Buena Vista, a subdivision located in the Village of Fontana, Walworth County, Wisconsin described as follows: Lot 59, ALSO the South 20.00 feet of Lots 48 and 49, ALSO a part of Lot 57 described as follows: Beginning at the Northwest corner of said Lot 57, thence East along the North line of said Lot 57, 12.00 feet, thence Southerly parallel with the West line of Lot 58 in said Buena Vista, 50.19 feet, thence Westerly parallel with the North line of said Lot 57, 2.00 feet to a point on the West line of said Lot 57, located midway between the NW corner & the SW corner of said Lot 57; thence Northerly along the west line of said Lot 57 to the place of beginning, ALSO Lot 58 excepting the following described parcel: Beginning at the Southeast corner of said Lot 58; thence Westerly along the South line of said Lot 58, 10.00 feet; thence Northerly 50.19 feet to a point on the East line of said Lot 58 located midway between the Northeast corner and the Southeast corner of said Lot 58; thence Southerly along the Easterly line of said Lot 58 to the place of beginning,

and the above map is a true representation thereof and shows the size and location of the property, its exterior boundaries, the location and dimensions of all structures thereon, fences, apparent easements and roadways and visible encroachments, if any.

This survey is made for the property, and also those who purchase, mortgage, or guarantee the title thereto within one (1) year from date hereof; and as to them I warrant the accuracy of said survey and map.

November 14, 1978

James M. Dunham
James M. Dunham, Surveyor

