
HAROLD H. KOLB

REGISTERED PROFESSIONAL LAND SURVEYOR
LAKE GENEVA, WISCONSIN

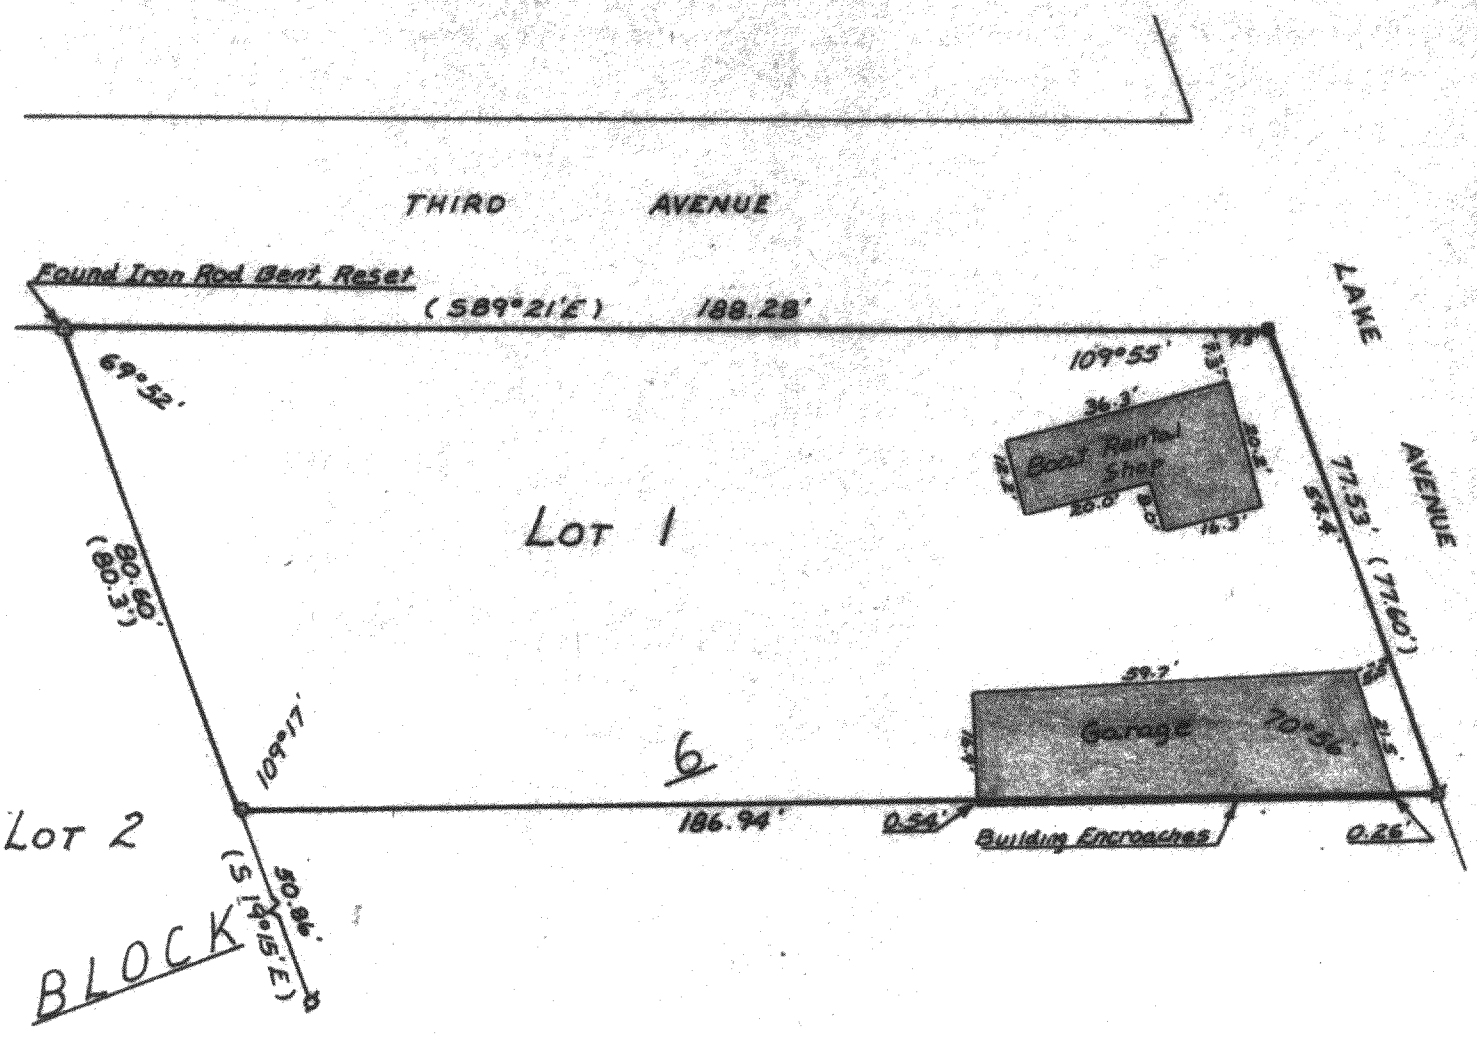

PLAT OF SURVEY OF

PART OF LOT 1, BLOCK 6 OF D.A. REIDS ADDITION TO REIDS PARK, VILLAGE OF FONTANA-ON-GENEVA LAKE, WALWORTH COUNTY, WISCONSIN AS DESCRIBED IN VOLUME 146, PAGE 488 OF RECORDS.

ORDERED BY: GORDY'S LAKE FRONT MARINE
FONTANA ON LAKE GENEVA
FONTANA, WI 53125

WISCONSIN
HAROLD H. KOLB
S-187
LAKE GENEVA, WIS.
LAND SURVEYOR

I, HAROLD H. KOLB, DO HEREBY CERTIFY THAT I HAVE SURVEYED THE PROPERTY HEREON DESCRIBED ACCORDING TO THE OFFICIAL RECORDS, AND THAT THE PLAT HEREON IS A CORRECT REPRESENTATION OF THE LOT LINES.

N

SCALE · 1" = 30'

Harold H. Kolb
HAROLD H. KOLB
WISCONSIN REGISTERED LAND SURVEYOR, S-187
DATE Sept. 12, 1978

LEGEND

- O — IRON PIPE PLACED, 1" x 24" 1.13 LB./LIN. FT.
- ● — CONCRETE MONUMENT, 5" DIA. x 30"
- ⌀ — IRON PIPE FOUND ( ) - AS PLATTED
- Δ - IRON ROD

BRUNING 40-108 1M-6-71 SRA-38

5-517