


DUNHAM SURVEYING, S.C.
SURVEYING & SUBDIVIDING
DELAVER, WISCONSIN 53115

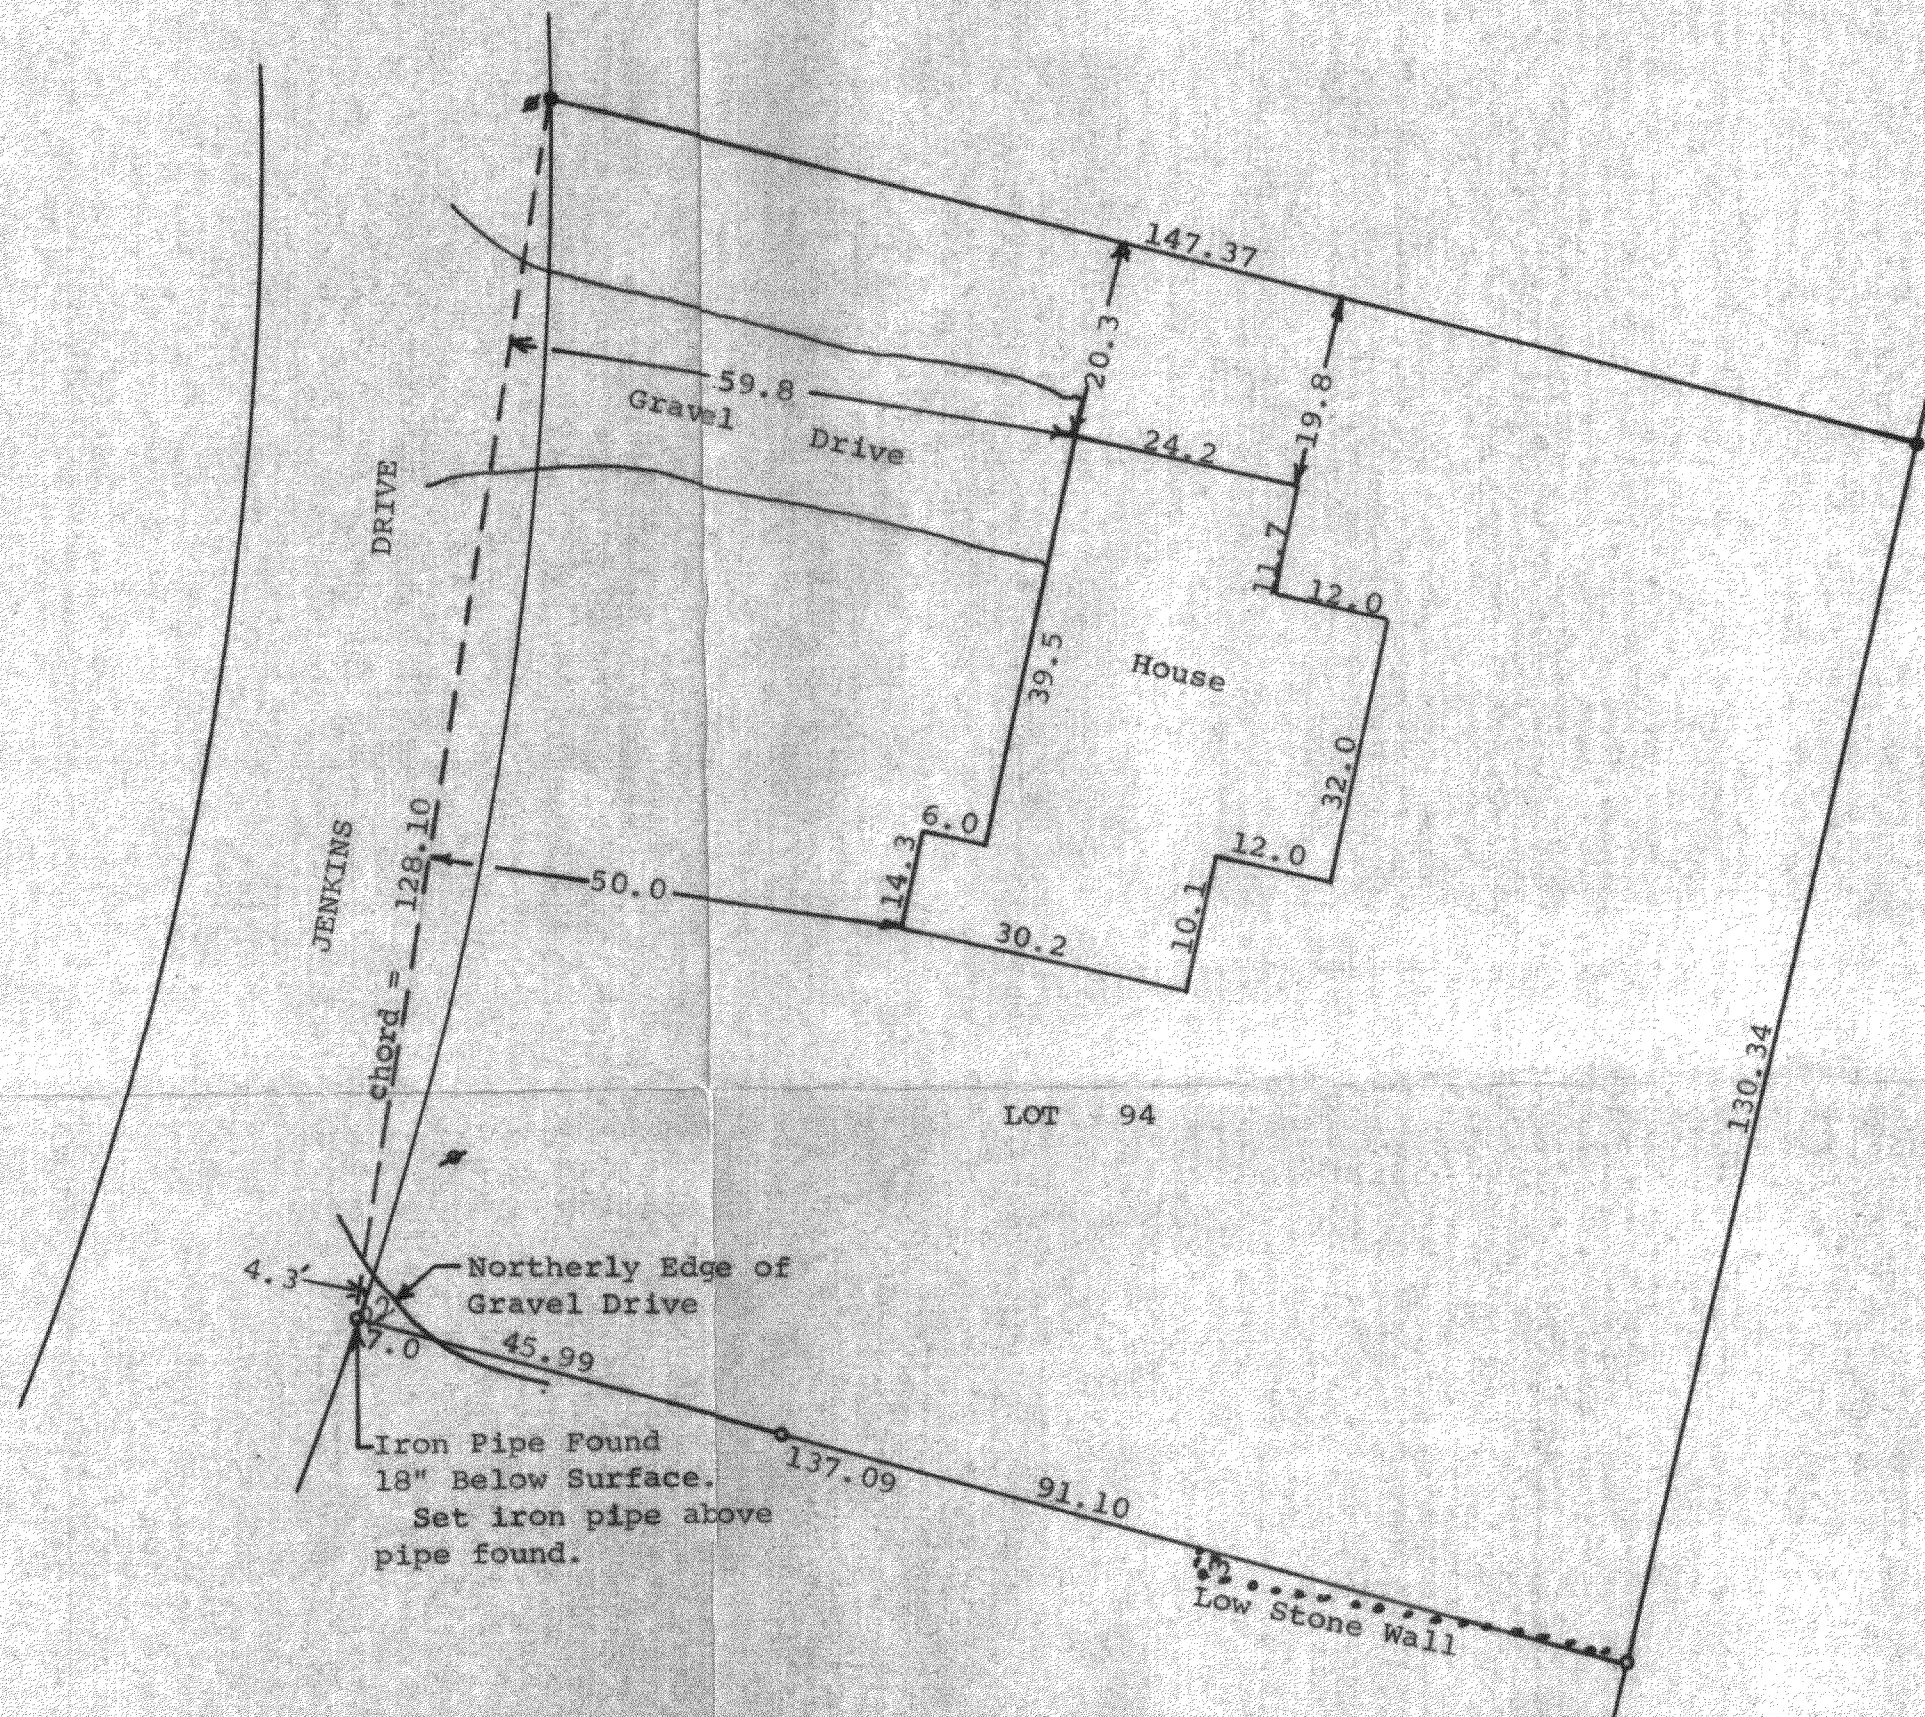

Scale - 1" = 20'
 • = Iron Pipe Found
 • = Concrete Monument Found
 / = Utility Pole



STATE OF WISCONSIN) SS
 COUNTY OF WALWORTH)

I, George T. Dunham, Surveyor, certify that I have surveyed the property described as follows:

Lot 94 in Country Club Estates Unit No. 2, located in the Village of Pontana, Walworth County, Wisconsin, and the above map is a true representation thereof and shows the size and location of the property, its exterior boundaries, the location and dimensions of all structures thereon, fences, apparent easements and roadways and visible encroachments, if any.

April 19, 1978

Revised April 22, 1978

George T. Dunham
 George T. Dunham, Surveyor

