
HAROLD H. KOLB

REGISTERED PROFESSIONAL LAND SURVEYOR
LAKE GENEVA, WISCONSIN

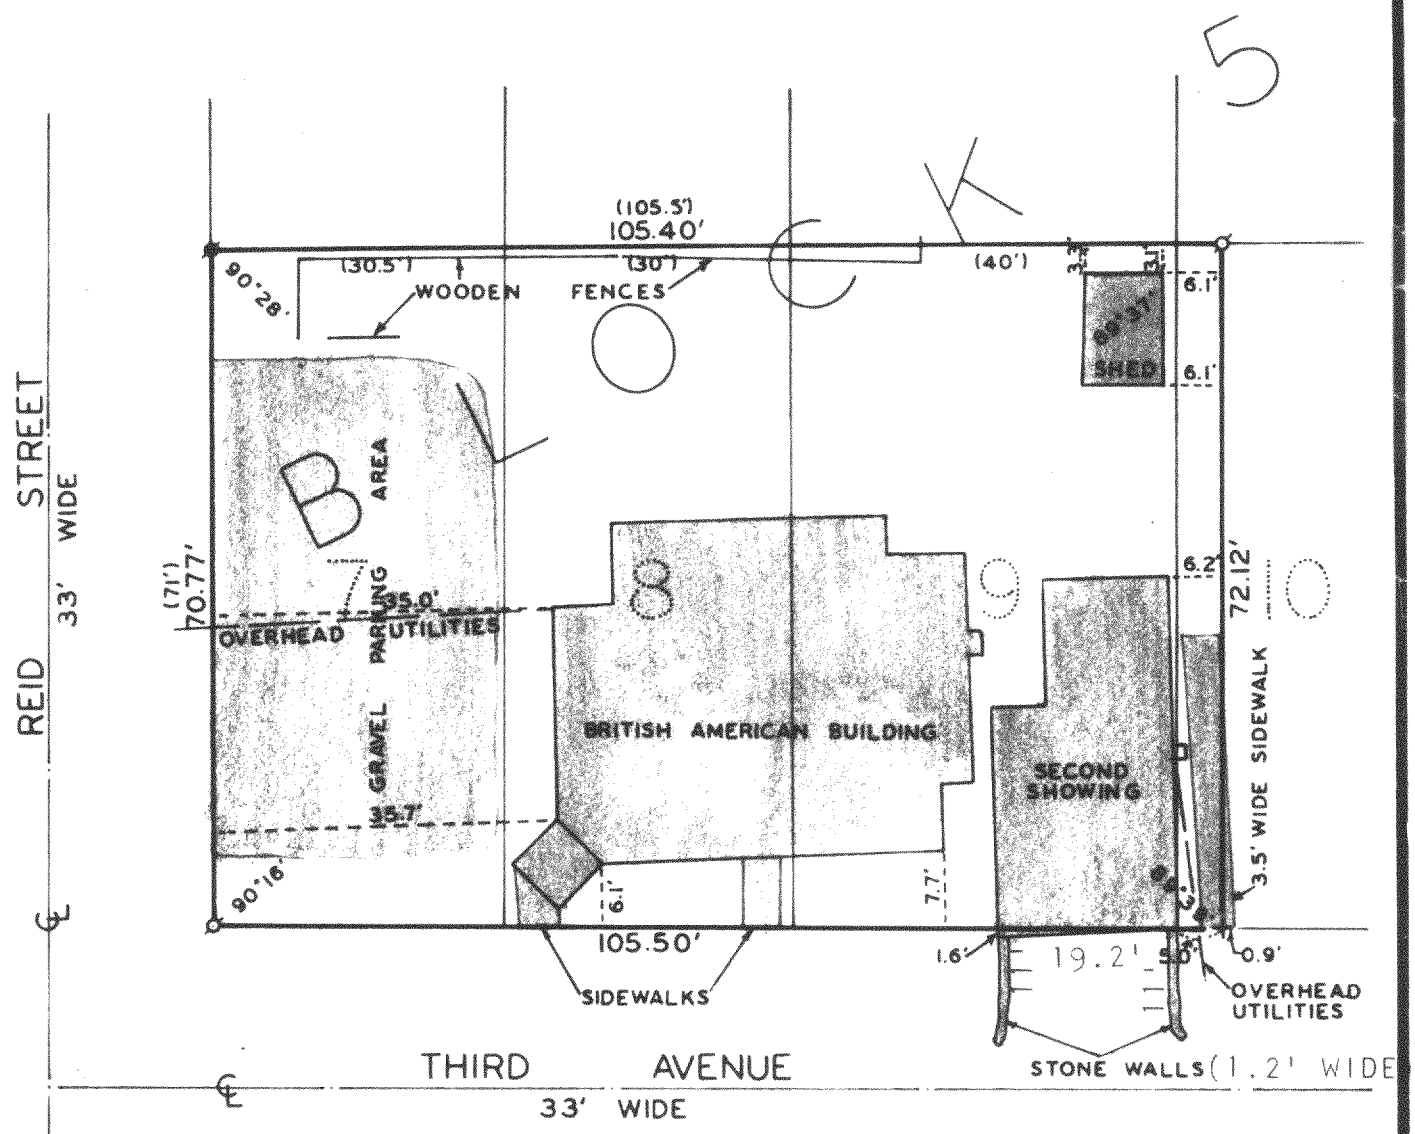

PLAT OF SURVEY OF

LOTS 7, 8, 9 AND THE WEST 5 FEET OF LOT 10, BLOCK 5, D.A. REID'S ADDITION TO REID'S PARK, A SUBDIVISION LOCATED IN THE VILLAGE OF FONTANA-ON-GENEVA LAKE, WALWORTH COUNTY, WISCONSIN.

ORDERED BY: CONROYD REALTY
HIGHWAY 67
FONTANA, WI 53125

I HAVE SURVEYED THE ABOVE-DESCRIBED PROPERTY AND THE ABOVE MAP IS A TRUE REPRESENTATION THEREOF AND SHOWS THE SIZE AND LOCATION OF THE PROPERTY, ITS EXTERIOR BOUNDARIES, THE LOCATION OF ALL APPARENT EASEMENTS AND ROADWAYS AND VISIBLE ENCROACHMENTS, IF ANY.

THIS SURVEY IS MADE FOR THE USE OF THE PRESENT OWNERS OF THE PROPERTY, AND ALSO THOSE WHO PURCHASE, MORTGAGE, OR GUARANTEE THE TITLE THERETO WITHIN ONE (1) YEAR FROM DATE HEREOF.

Harold H. Kolb
HAROLD H. KOLB
WISCONSIN REGISTERED LAND SURVEYOR, S-187
DATE Dec. 8, 1978

REVISED DEC. 12.1978

SCALE: 1"=20'

+ - CUT CROSS FOUND
O — IRON PIPE PLACED, 1" x 24" 1.13 LB./LIN. FT.
● — CONCRETE MONUMENT. 5" DIA. x 30" (FOUND)
σ - IRON PIPE FOUND ()-AS PLATTED

BRUNING 40-105 1M-6-71 SRA-34,35

5-554K