
KOLB LAND CONSULTING, INC.
LAKE GENEVA, WISCONSIN

PLAT OF SURVEY OF

PART OF LOT 5 AND LOT 7 OF THE GARDENS SUBDIVISION, AS PER REVISED PLAT RECORDED JUNE 9, 1927 IN VOLUME 8 OF PLATS ON PAGES 121 AND 122, WALWORTH COUNTY, WISCONSIN, LOCATED IN THE VILLAGE OF FONTANA-ON-GENEVA LAKE, WALWORTH COUNTY, WISCONSIN.

ORDERED BY: MRS. H. B. NEWTON
2616 LANDSTROM ROAD
ROCKFORD, ILLINOIS 61107

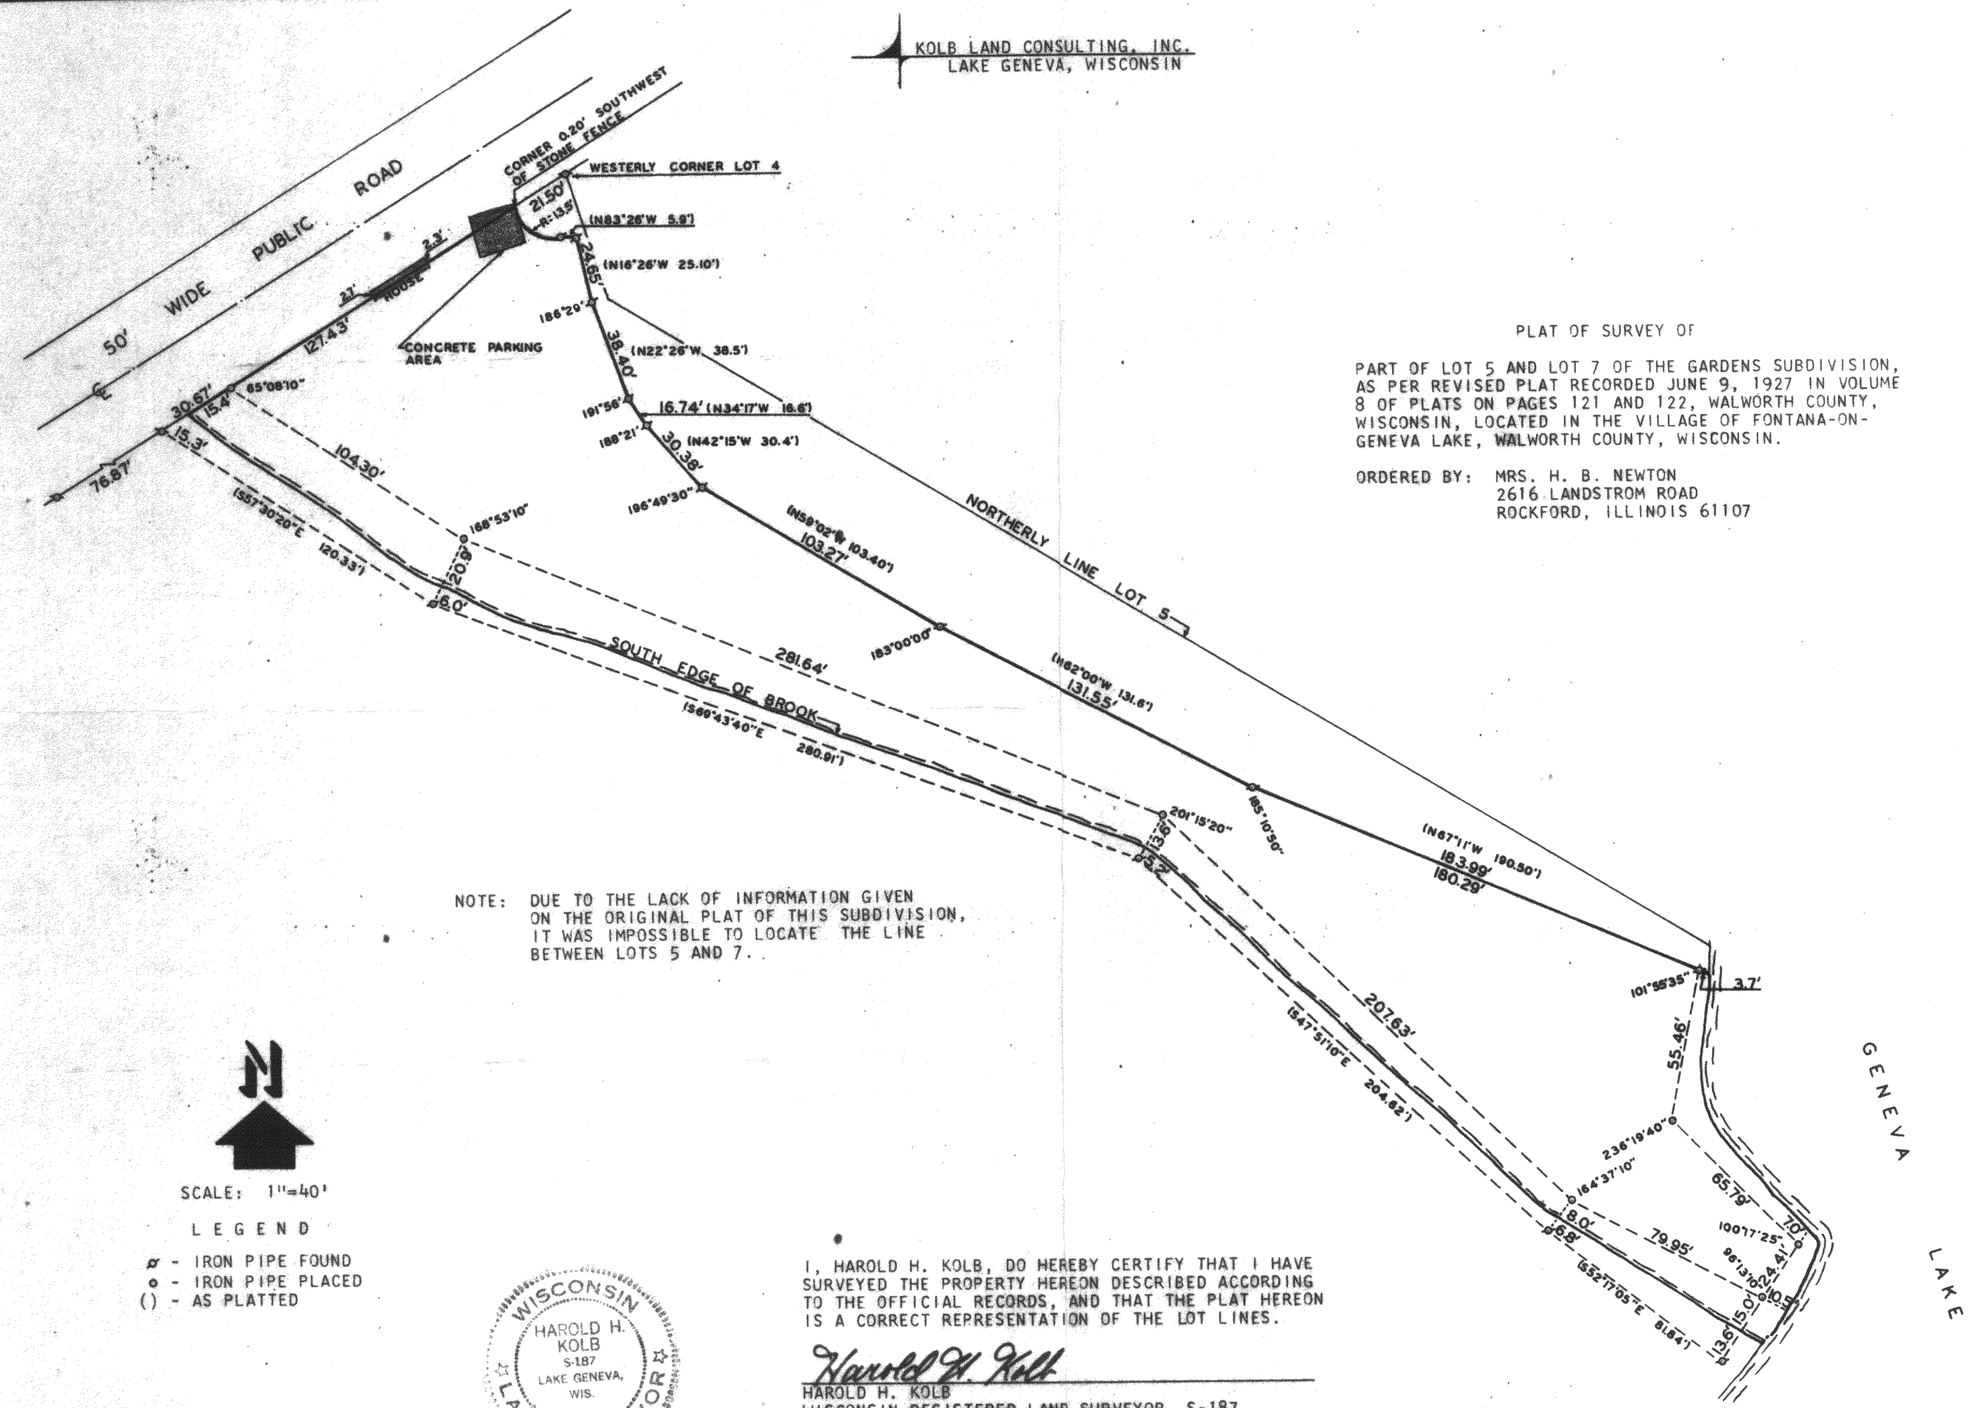

NOTE: DUE TO THE LACK OF INFORMATION GIVEN ON THE ORIGINAL PLAT OF THIS SUBDIVISION, IT WAS IMPOSSIBLE TO LOCATE THE LINE BETWEEN LOTS 5 AND 7..

SCALE: 1"=40'

L E G E N D

- ⌀ - IRON PIPE FOUND
- o - IRON PIPE PLACED
- () - AS PLATTED

WISCONSIN
HAROLD H. KOLB
S-187
LAKE GENEVA, WIS.
LAND SURVEYOR

I, HAROLD H. KOLB, DO HEREBY CERTIFY THAT I HAVE SURVEYED THE PROPERTY HEREON DESCRIBED ACCORDING TO THE OFFICIAL RECORDS, AND THAT THE PLAT HEREON IS A CORRECT REPRESENTATION OF THE LOT LINES.

Harold H. Kolb
HAROLD H. KOLB
WISCONSIN REGISTERED LAND SURVEYOR, S-187

Nov. 30, 1978
DATE

5-556K