
# PLAT OF SURVEY

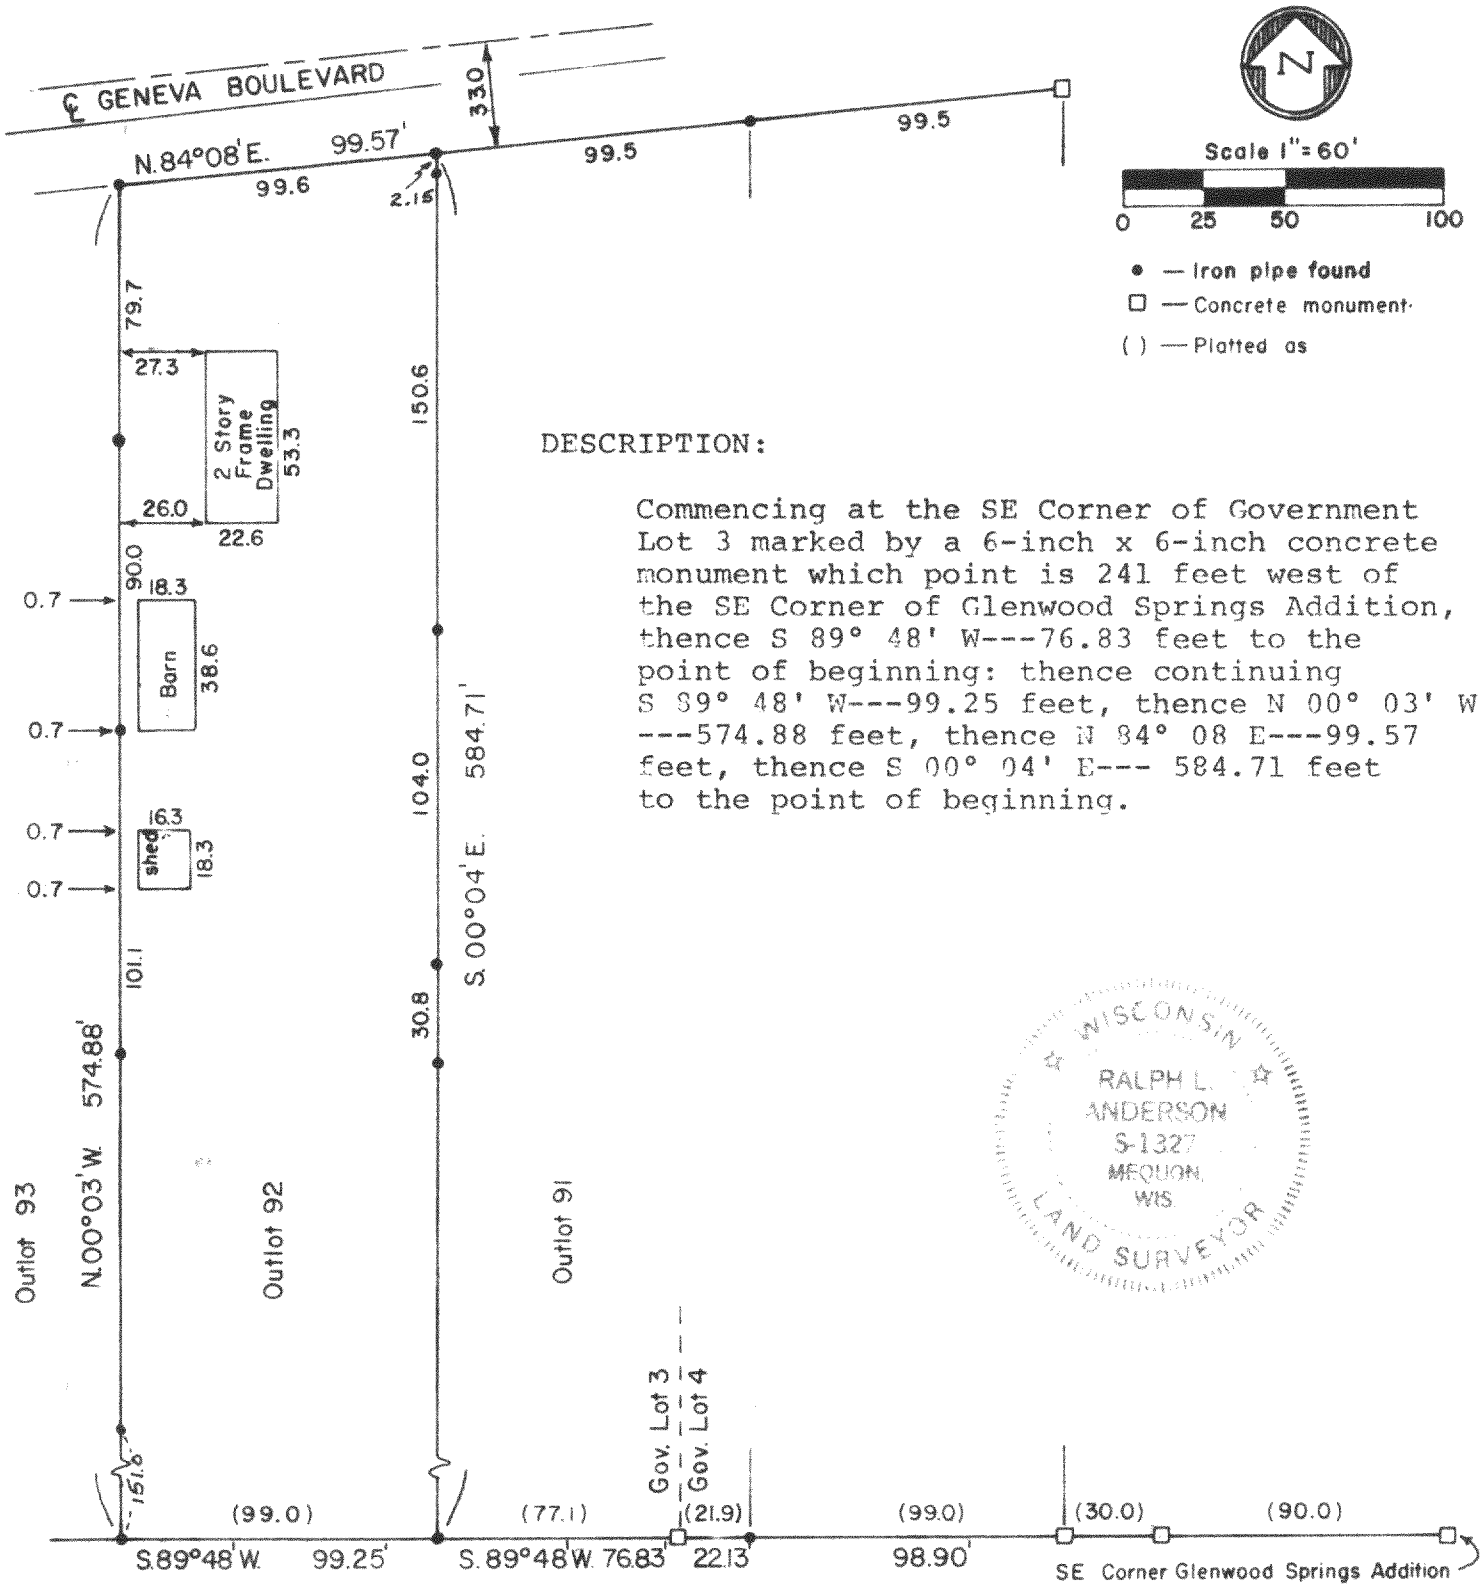


DESCRIPTION:

Commencing at the SE Corner of Government Lot 3 marked by a 6-inch x 6-inch concrete monument which point is 241 feet west of the SE Corner of Glenwood Springs Addition, thence S 89° 48' W---76.83 feet to the point of beginning: thence continuing S 89° 48' W---99.25 feet, thence N 00° 03' W ---574.88 feet, thence N 84° 08 E---99.57 feet, thence S 00° 04' E--- 584.71 feet to the point of beginning.

WISCONSIN
RALPH L. ANDERSON
S-1327
MEQUON, WIS.
LAND SURVEYOR

SURVEYOR'S CERTIFICATE

I have surveyed the above described property and the above map is a true representation thereof and shows the size and location of the property, its exterior boundaries, the location and dimensions of all visible structures thereon, fences, apparent easements and roadways and visible encroachments. This survey is made for the exclusive use of the present owners of the property, and also those who purchase, mortgage, or guarantee the title thereto within one (1) year from date hereof and as to them I warrant the accuracy of said survey and map.

Date 7 July 1977

Ralph L. Anderson

Ralph L. Anderson, RLS 1327

| Prepared By | Prepared For | Date | Sheet Number |
|---|---|---|---|
| VALENTINE AND ASSOCIATES, INC. DELAVAN, WISCONSIN | ALICE MARLEWSKI FONTANA, WISCONSIN | 7/7/77 | 1 of 1 |
| | | Job Number 7741 | Reference File |

C.S. 1034

5-559