
KOLB LAND CONSULTING, INC.

LAND SURVEYING · SUBDIVIDING · LAND PLANNING

LAKE GENEVA, WISCONSIN 53147 WHITEWATER, WISCONSIN 53190

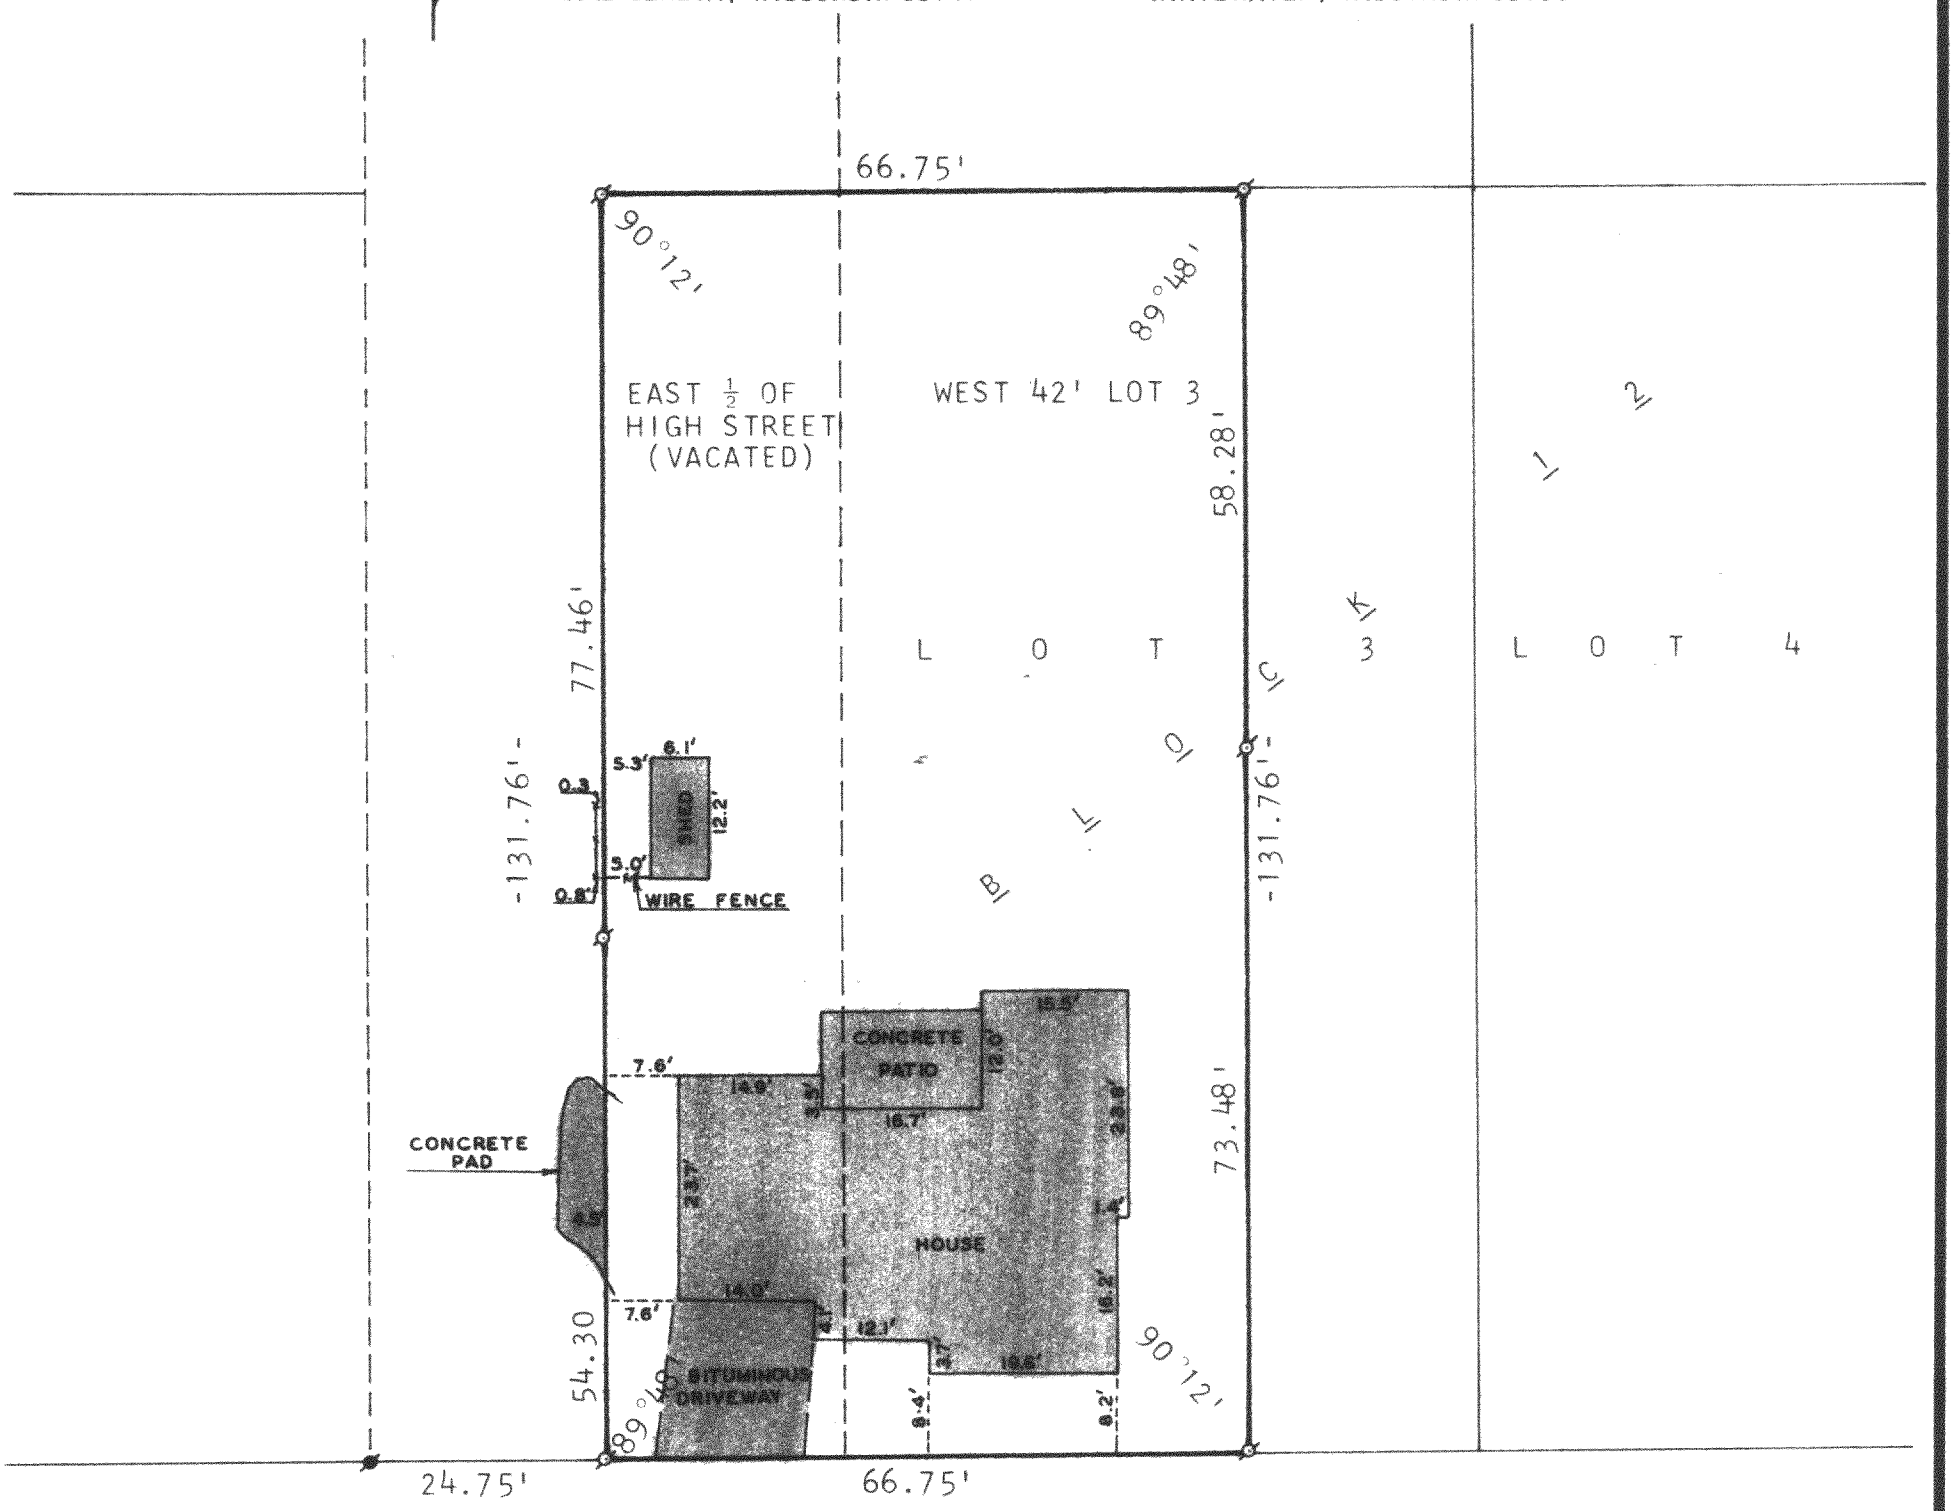

KINZIE STREET
66' WIDE

℄

PLAT OF SURVEY OF

THE WEST 42 FEET OF LOT 3, BLOCK 12, AND THE EAST ½ OF THE SOUTH ½ OF VACATED HIGH STREET, ORIGINAL PLAT, VILLAGE OF FONTANA, WALWORTH COUNTY, WISCONSIN.

ORDERED BY: BETTY GRABOW
P. O. BOX 122
FONTANA, WIS. 53125

SCALE: 1"=20'
¤ - IRON PIPE FOUND
● - CONCRETE MONUMENT FOUND

WISCONSIN HAROLD H. KOLB S-187 LAKE GENEVA, WIS. LAND SURVEYOR

I HEREBY CERTIFY THAT I HAVE SURVEYED THE ABOVE DESCRIBED PROPERTY AND THAT THE ABOVE MAP IS A TRUE REPRESENTATION THEREOF AND SHOWS THE SIZE AND LOCATION OF THE PROPERTY, ITS EXTERIOR BOUNDARIES, THE LOCATION OF ALL VISIBLE STRUCTURES AND DIMENSIONS OF ALL PRINCIPAL BUILDINGS THEREON, BOUNDARY FENCES, APPARENT EASEMENTS, ROADWAYS AND VISIBLE ENCROACHMENTS, IF ANY.

THIS SURVEY IS MADE FOR THE USE OF THE PRESENT OWNERS OF THE PROPERTY, AND ALSO THOSE WHO PURCHASE, MORTGAGE, OR GUARANTEE THE TITLE THERETO WITHIN ONE (1) YEAR FROM DATE HEREOF.

Harold H. Kolb
HAROLD H. KOLB
WISCONSIN REGISTERED LAND SURVEYOR, S-187
DATE June 25, 1979

SOP-72

5-560K