
KOLB LAND CONSULTING, INC.

LAND SURVEYING · SUBDIVIDING · LAND PLANNING

LAKE GENEVA, WISCONSIN 53147 WHITEWATER, WISCONSIN 53190

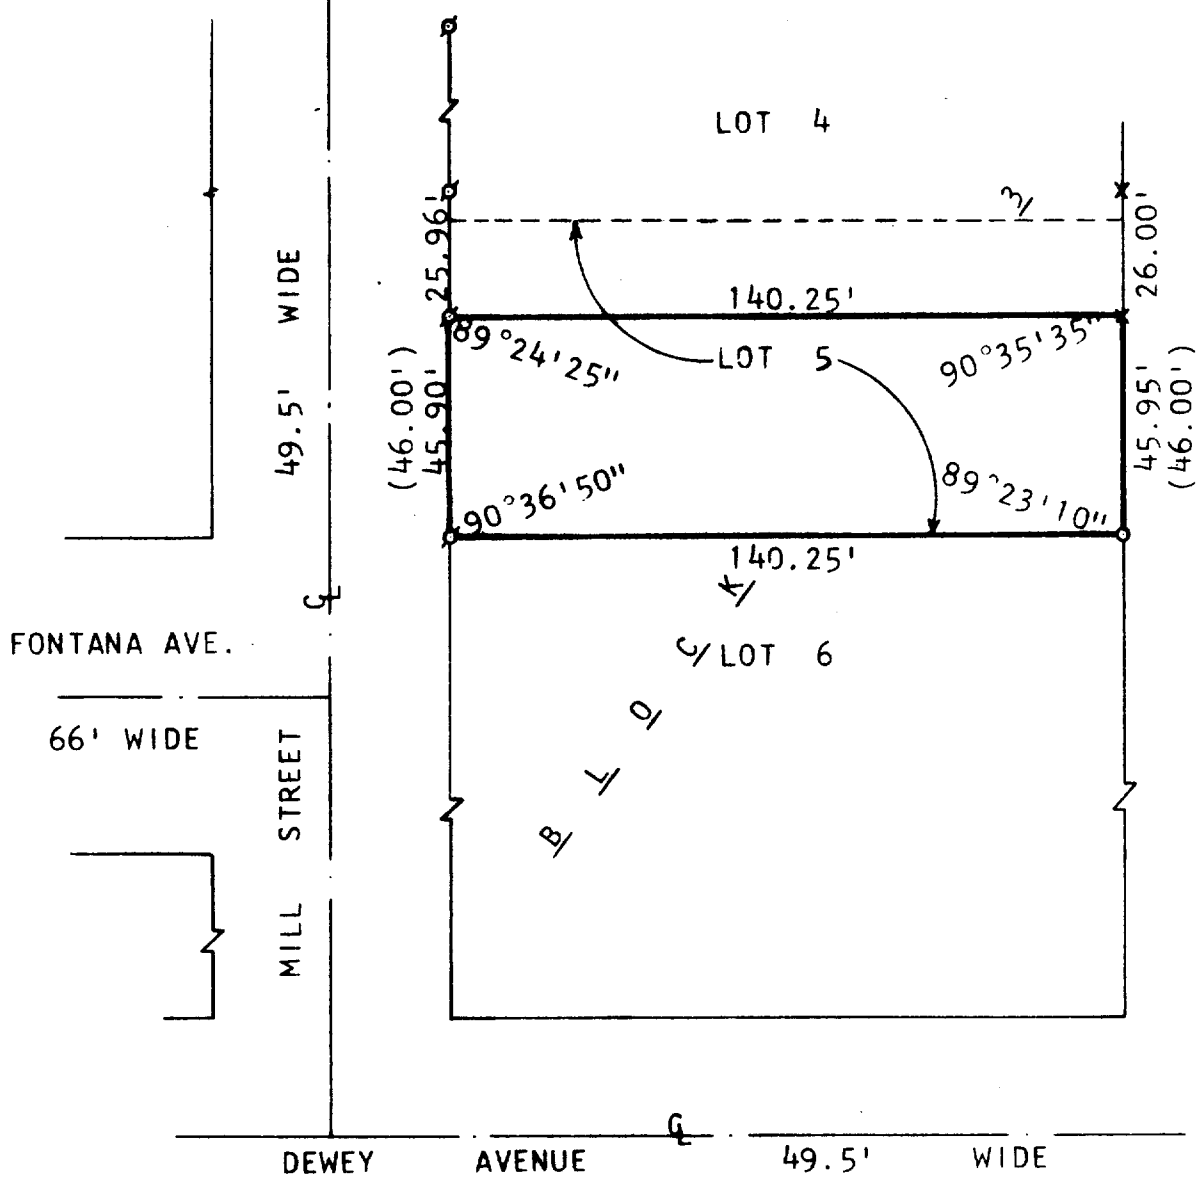

WISCONSIN
HAROLD H. KOLB
S-187
LAKE GENEVA, WIS.
LAND SURVEYOR

PLAT OF SURVEY OF

THE SOUTH 46 FEET OF LOT 5, BLOCK 3, ASSESSOR'S PLAT NUMBER 1, C. L. DOUGLAS ADDITION TO THE VILLAGE OF FONTANA-ON-GENEVA LAKE, WALWORTH COUNTY, WISCONSIN.

ORDERED BY: CONROYD REALTY
HIGHWAY 67
FONTANA, WI 53125

N

SCALE : 1" = 40'

LEGEND

o - IRON PIPE FOUND
o - IRON PIPE PLACED
x - RAILROAD SPIKE FOUND
( ) - AS PLATTED

I, HAROLD H. KOLB, DO HEREBY CERTIFY THAT I HAVE SURVEYED THE PROPERTY HEREON DESCRIBED ACCORDING TO THE OFFICIAL RECORDS, AND THAT THE PLAT HEREON IS A CORRECT REPRESENTATION OF THE LOT LINES.

Harold H. Kolb

HAROLD H. KOLB
WISCONSIN REGISTERED LAND SURVEYOR, S-187

DATE June 15, 1979

ST FV-199A

5-561K