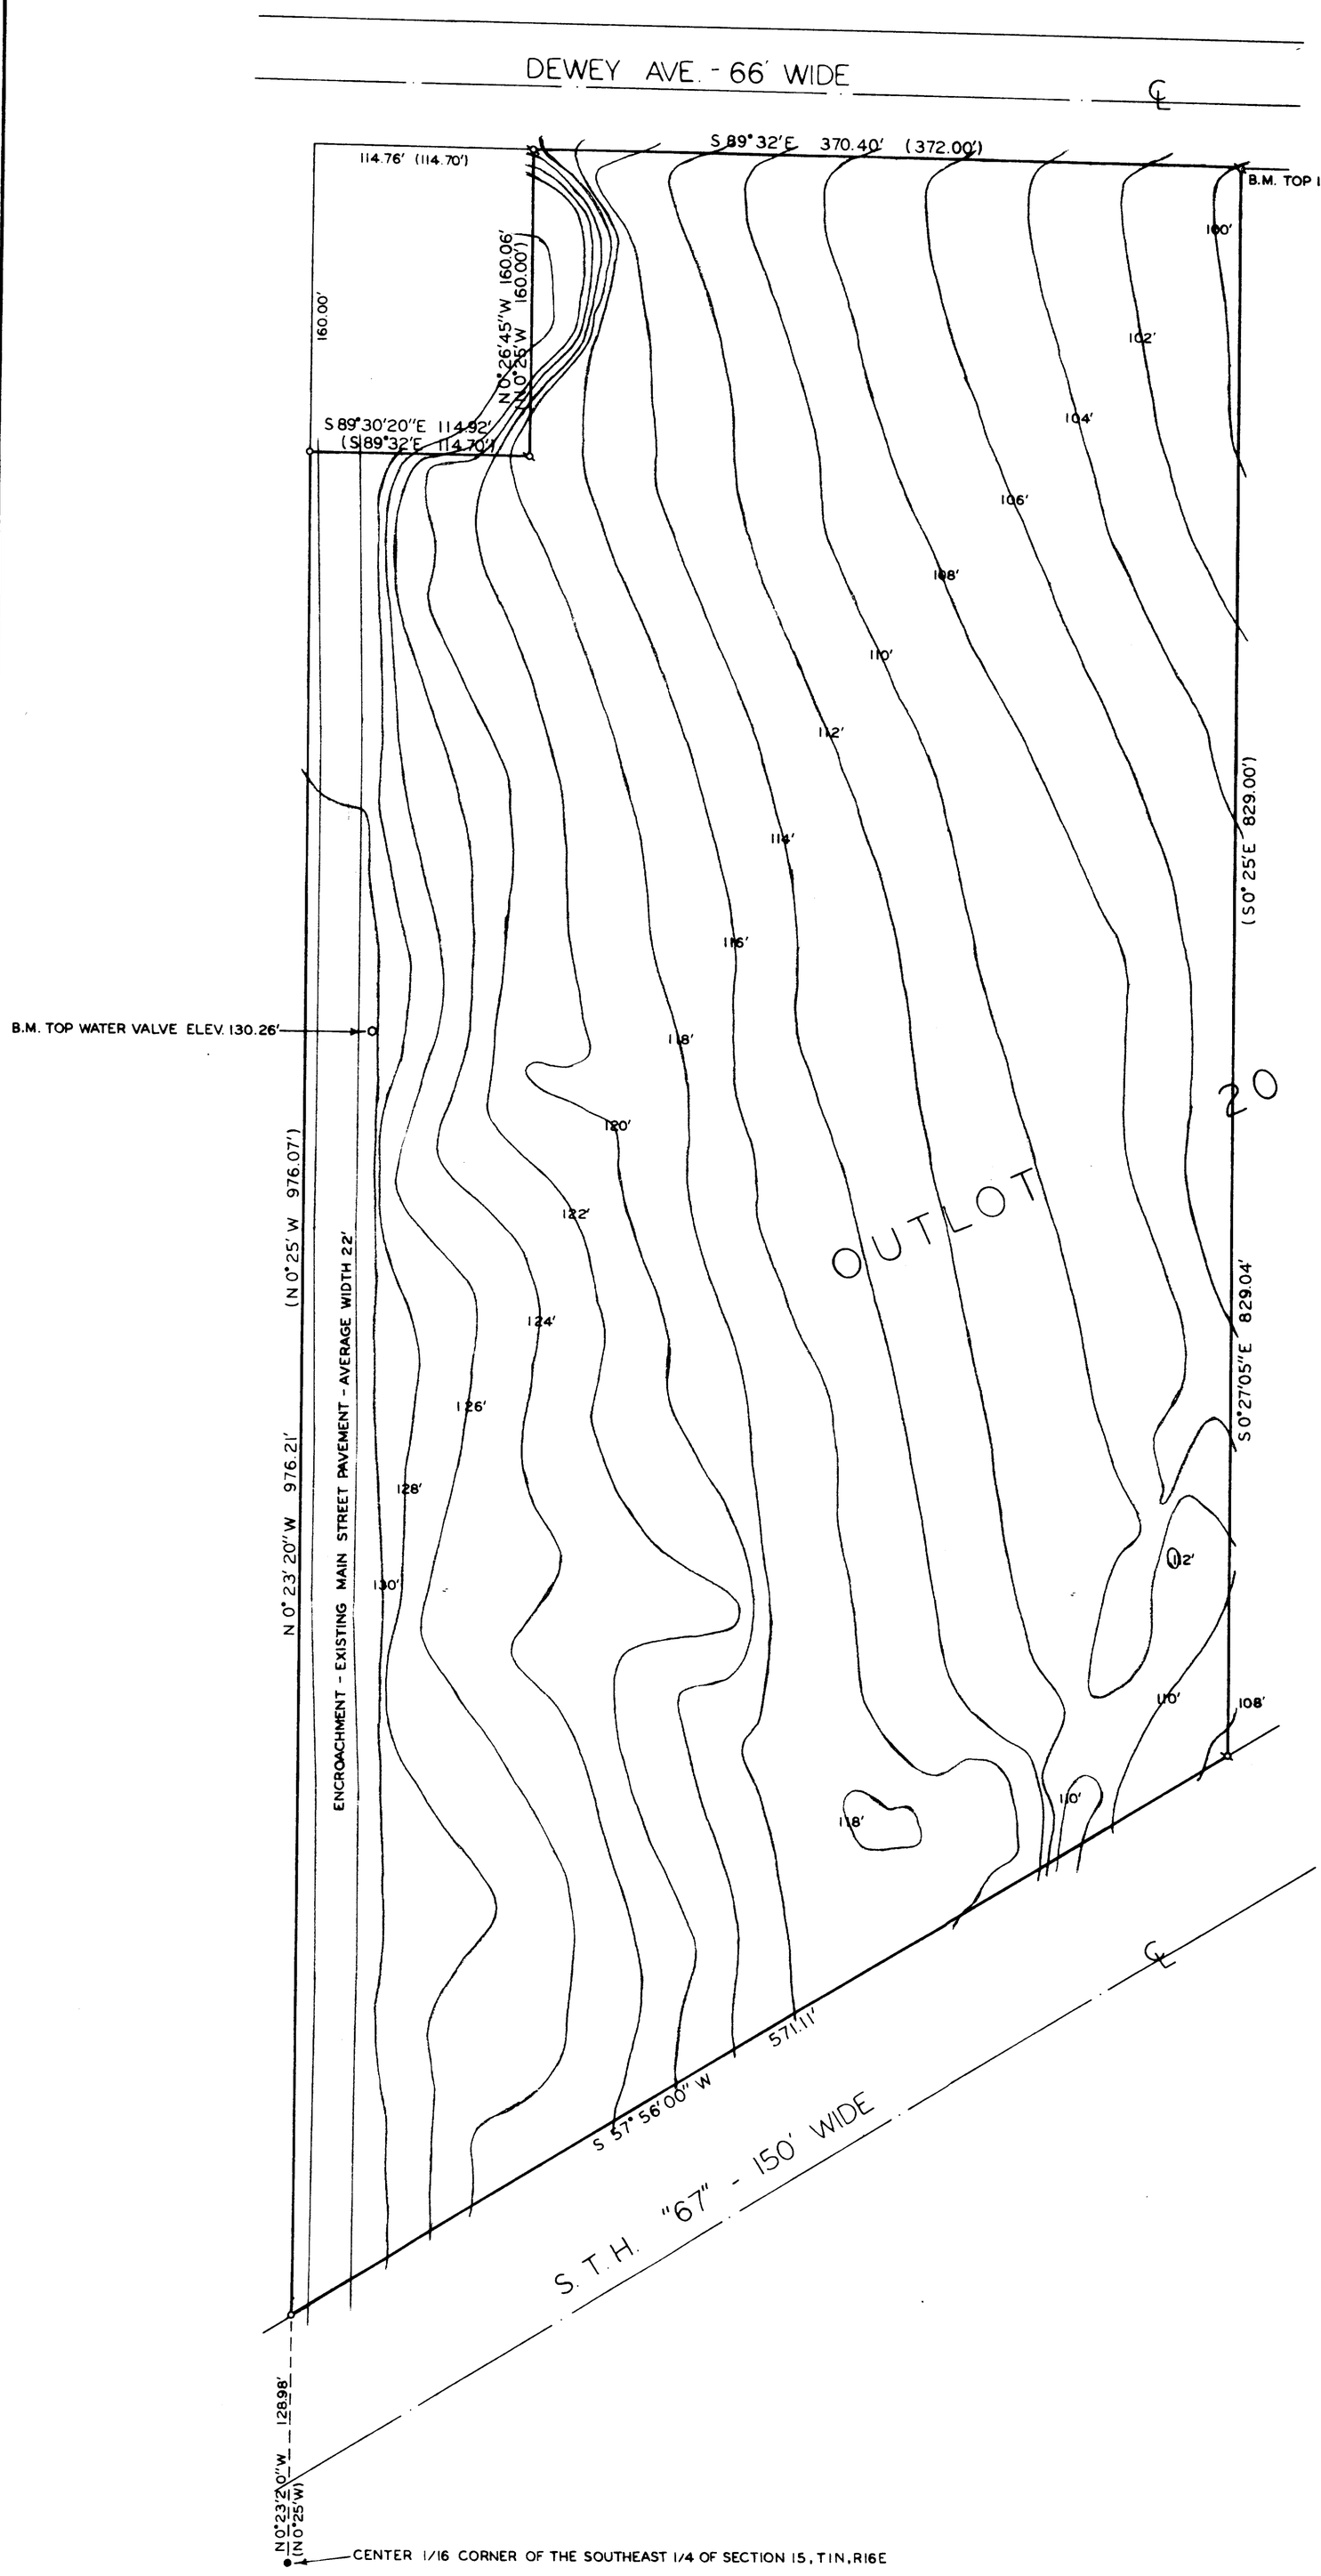


KOLB LAND CONSULTING, INC.
LAKE GENEVA, WISCONSIN 53147

PLAT OF SURVEY OF

PART OF OUTLOT 20, VILLAGE OF FONTANA-ON-GENEVA LAKE, WALWORTH COUNTY, WISCONSIN.

NOTE: BEARING OF NORTH LINE ASSUMED AS S 89°32'E FROM EXISTING SURVEY RECORDS.

N

SCALE: 1"=50'

LEGEND

- ⊗ - FOUND IRON PIPE
- ○ - PLACED IRON PIPE
- ● - FOUND CONCRETE MONUMENT

I, HAROLD H. KOLB, DO HEREBY CERTIFY THAT I HAVE SURVEYED THE PROPERTY HEREON DESCRIBED ACCORDING TO THE OFFICIAL RECORDS, AND THAT THIS PLAT IS A CORRECT REPRESENTATION OF THE LOT LINES TO THE BEST OF MY KNOWLEDGE AND BELIEF.

Harold H. Kolb
HAROLD H. KOLB
WISCONSIN REGISTERED LAND SURVEYOR, S-187
DATE April 30, 1979

WISCONSIN HAROLD H. KOLB S-187 LAKE GENEVA, WIS. LAND SURVEYOR

STFX-36.37

S-563F