PLAT OF SURVEY OF UNIT 114 OF ABBEY SPRINGS CONDOMINIUMS NO. IV LOCATED IN THE SW¼ OF SEC. 18, T1N R17E, AND THE SE¼ OF SEC. 13, T1N R16E, VILLAGE OF FONTANA-ON-GENEVA LAKE, WAL. CO. WIS.
JUNE 8, 1981

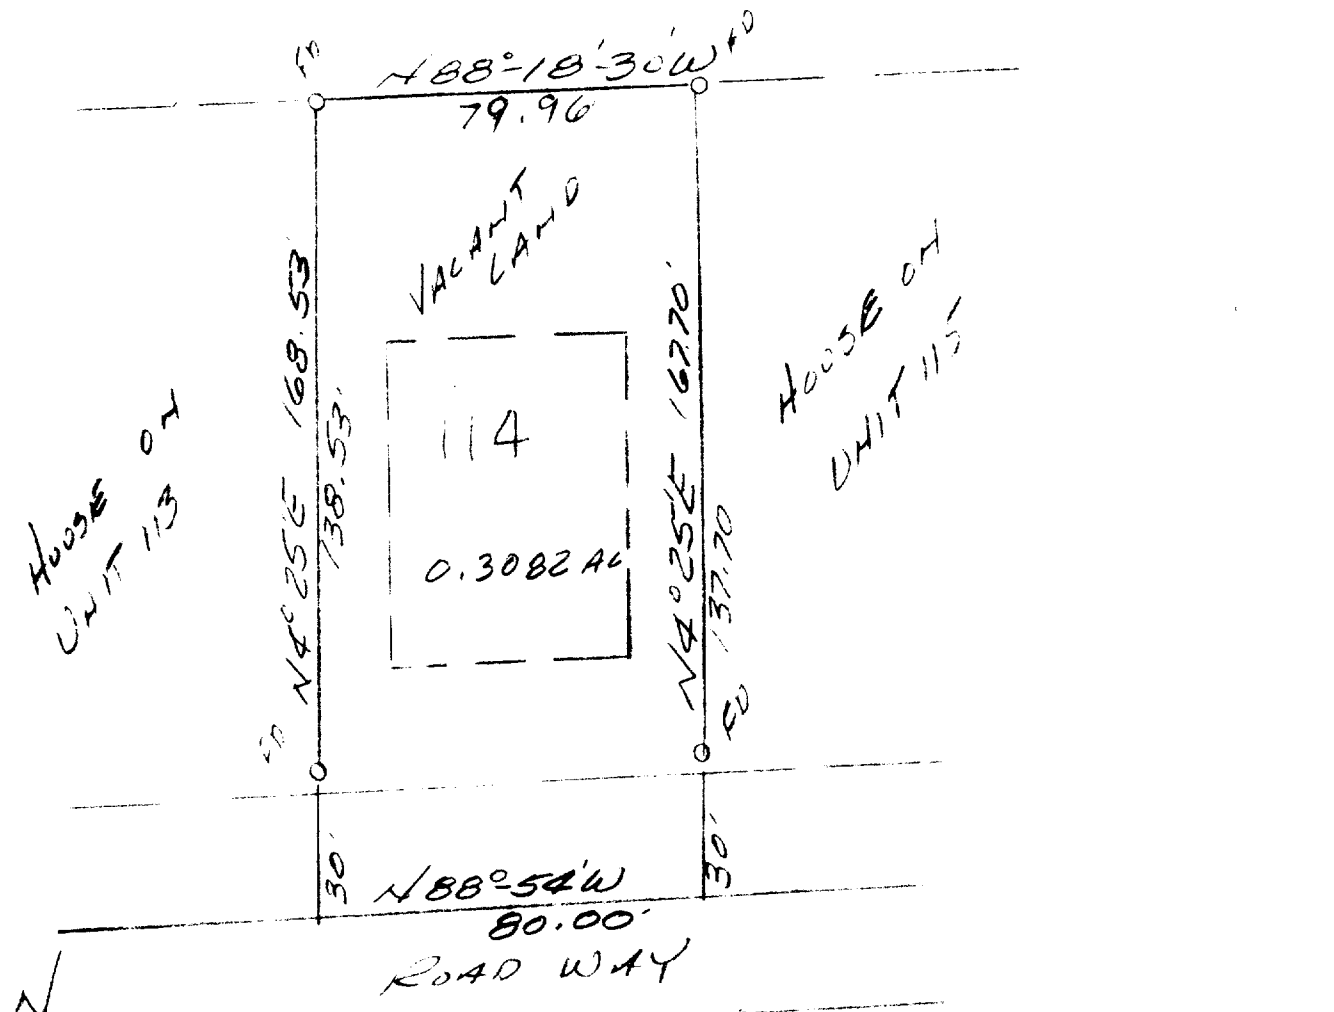

SCALE: 1"=40'

O - FOUND IRON PIPE

I CERTIFY THAT I SURVEYED THE ABOVE DESCRIBED PROPERTY & THAT THE PLAT SHOWN HEREON IS AN ACCURATE SURVEY & A TRUE REPRESENTATION THEREOF

WISCONSIN
THOMAS P. A. JENSEN
S-1084
ELKHORN, WIS.
LAND SURVEYOR

THOMAS P.A. JENSEN
JENSEN SURVEYING & MAPPING, S.C.
ELKHORN, WIS

SURVEYED FOR:
MR. HATHORN
57 BOBOLINK DR
FONTANA, WIS.
53125

81039

5-564-J

SKOB4-114