


DUNHAM SURVEYING, S.C.
SURVEYING & SUBDIVIDING
DELAVER, WISCONSIN 53115

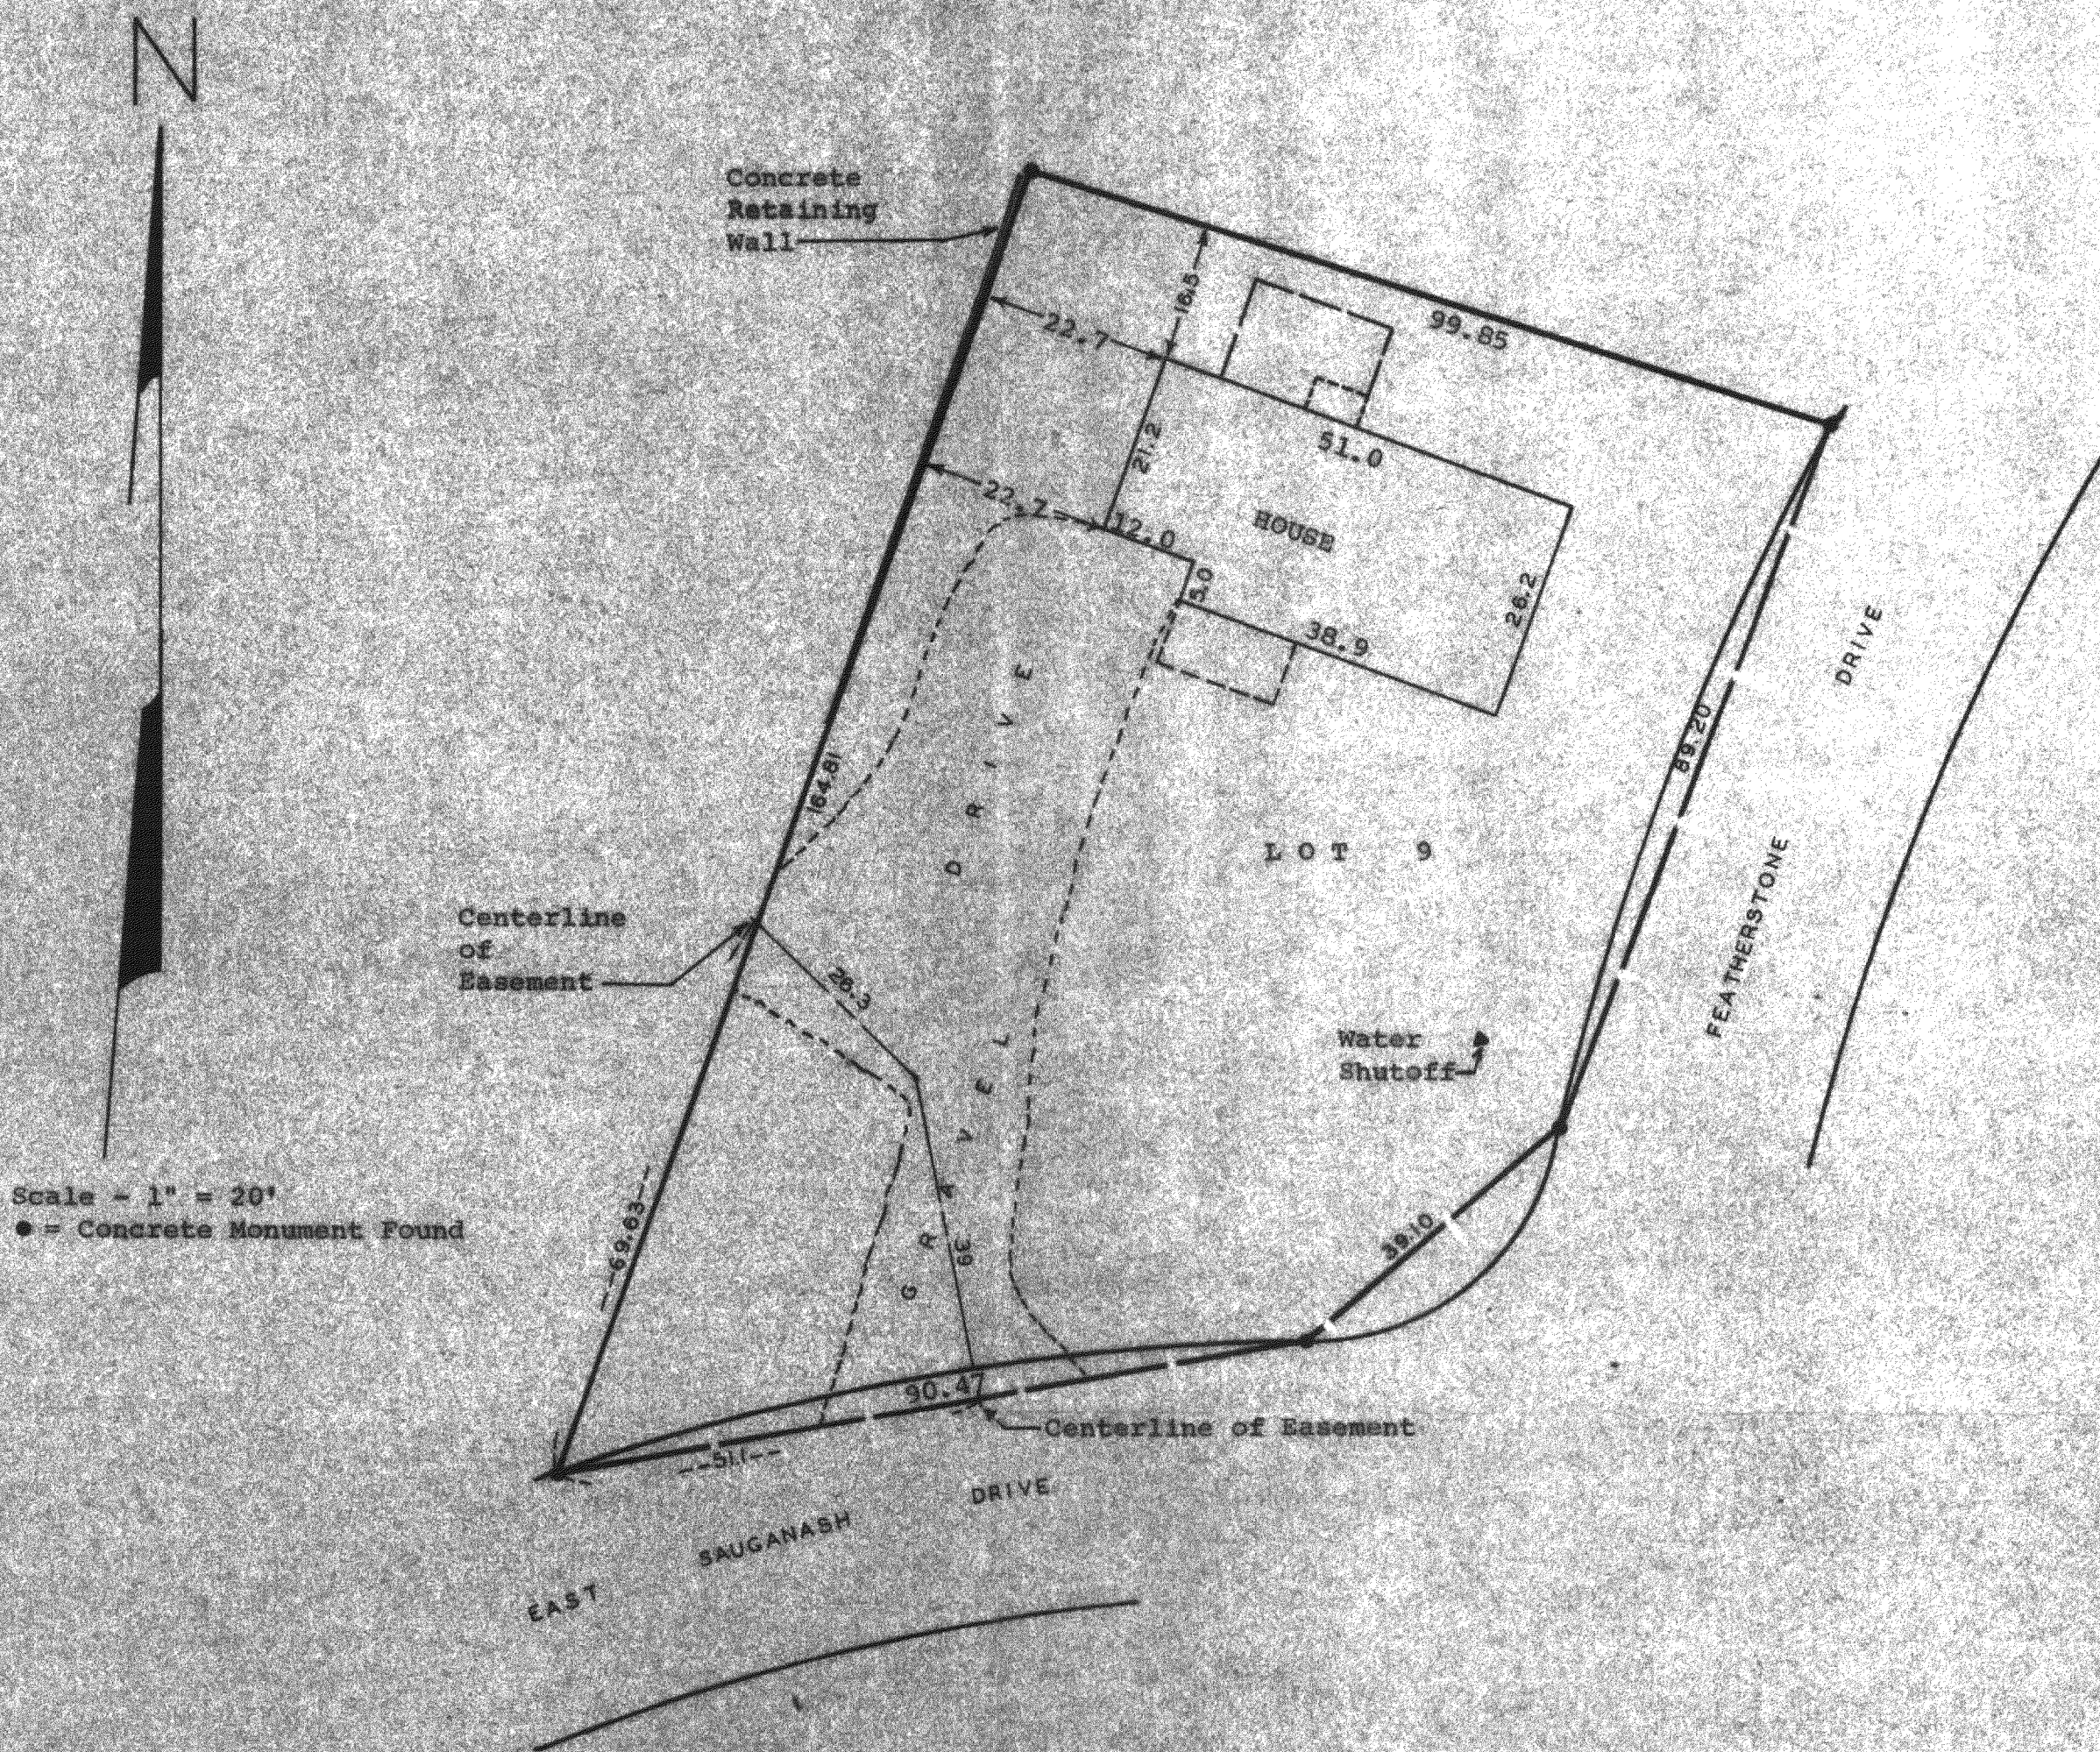

STATE OF WISCONSIN)
COUNTY OF WALWORTH) SS

I, James M. Dunham, Surveyor, certify that I have surveyed the property described as follows:

Lot 9, Block "E" of Unit No. 3 of Country Club Estates, a subdivision located in the Village of Pontana-on-Geneva Lake, Walworth County, Wisconsin, subject to an easement 15 feet in width for the purpose of ingress and egress, the centerline described as follows: Beginning on the southerly line of said Lot 9, 51.1 feet northeasterly from the southwest corner of said Lot 9; thence Northerly 39 feet; thence Northwesterly 26.3 feet to a point on the westerly line of said Lot 9, 69.63 feet northerly from the southwest corner of said Lot 9, said point is the point of termination.

and that the above map is a true representation thereof and shows the size and location of the property, its exterior boundaries, the location of all visible structures and dimensions of all principal buildings thereon, boundary fences, apparent easements, roadways and visible encroachments, if any.

This survey is made for the use of the present owners of the property, and also those who purchase, mortgage, or guarantee the title thereto within one (1) year from date hereof.

June 21, 1979

James M. Dunham
James M. Dunham, Surveyor

