
FARRIS, HANSEN & COOPER, INC.
ENGINEERING, SURVEYING AND LAND PLANNING
715 W. WALWORTH ST. - P.O. BOX 487 - ELKHORN, WI 53121
OFFICE: 414/723-2098

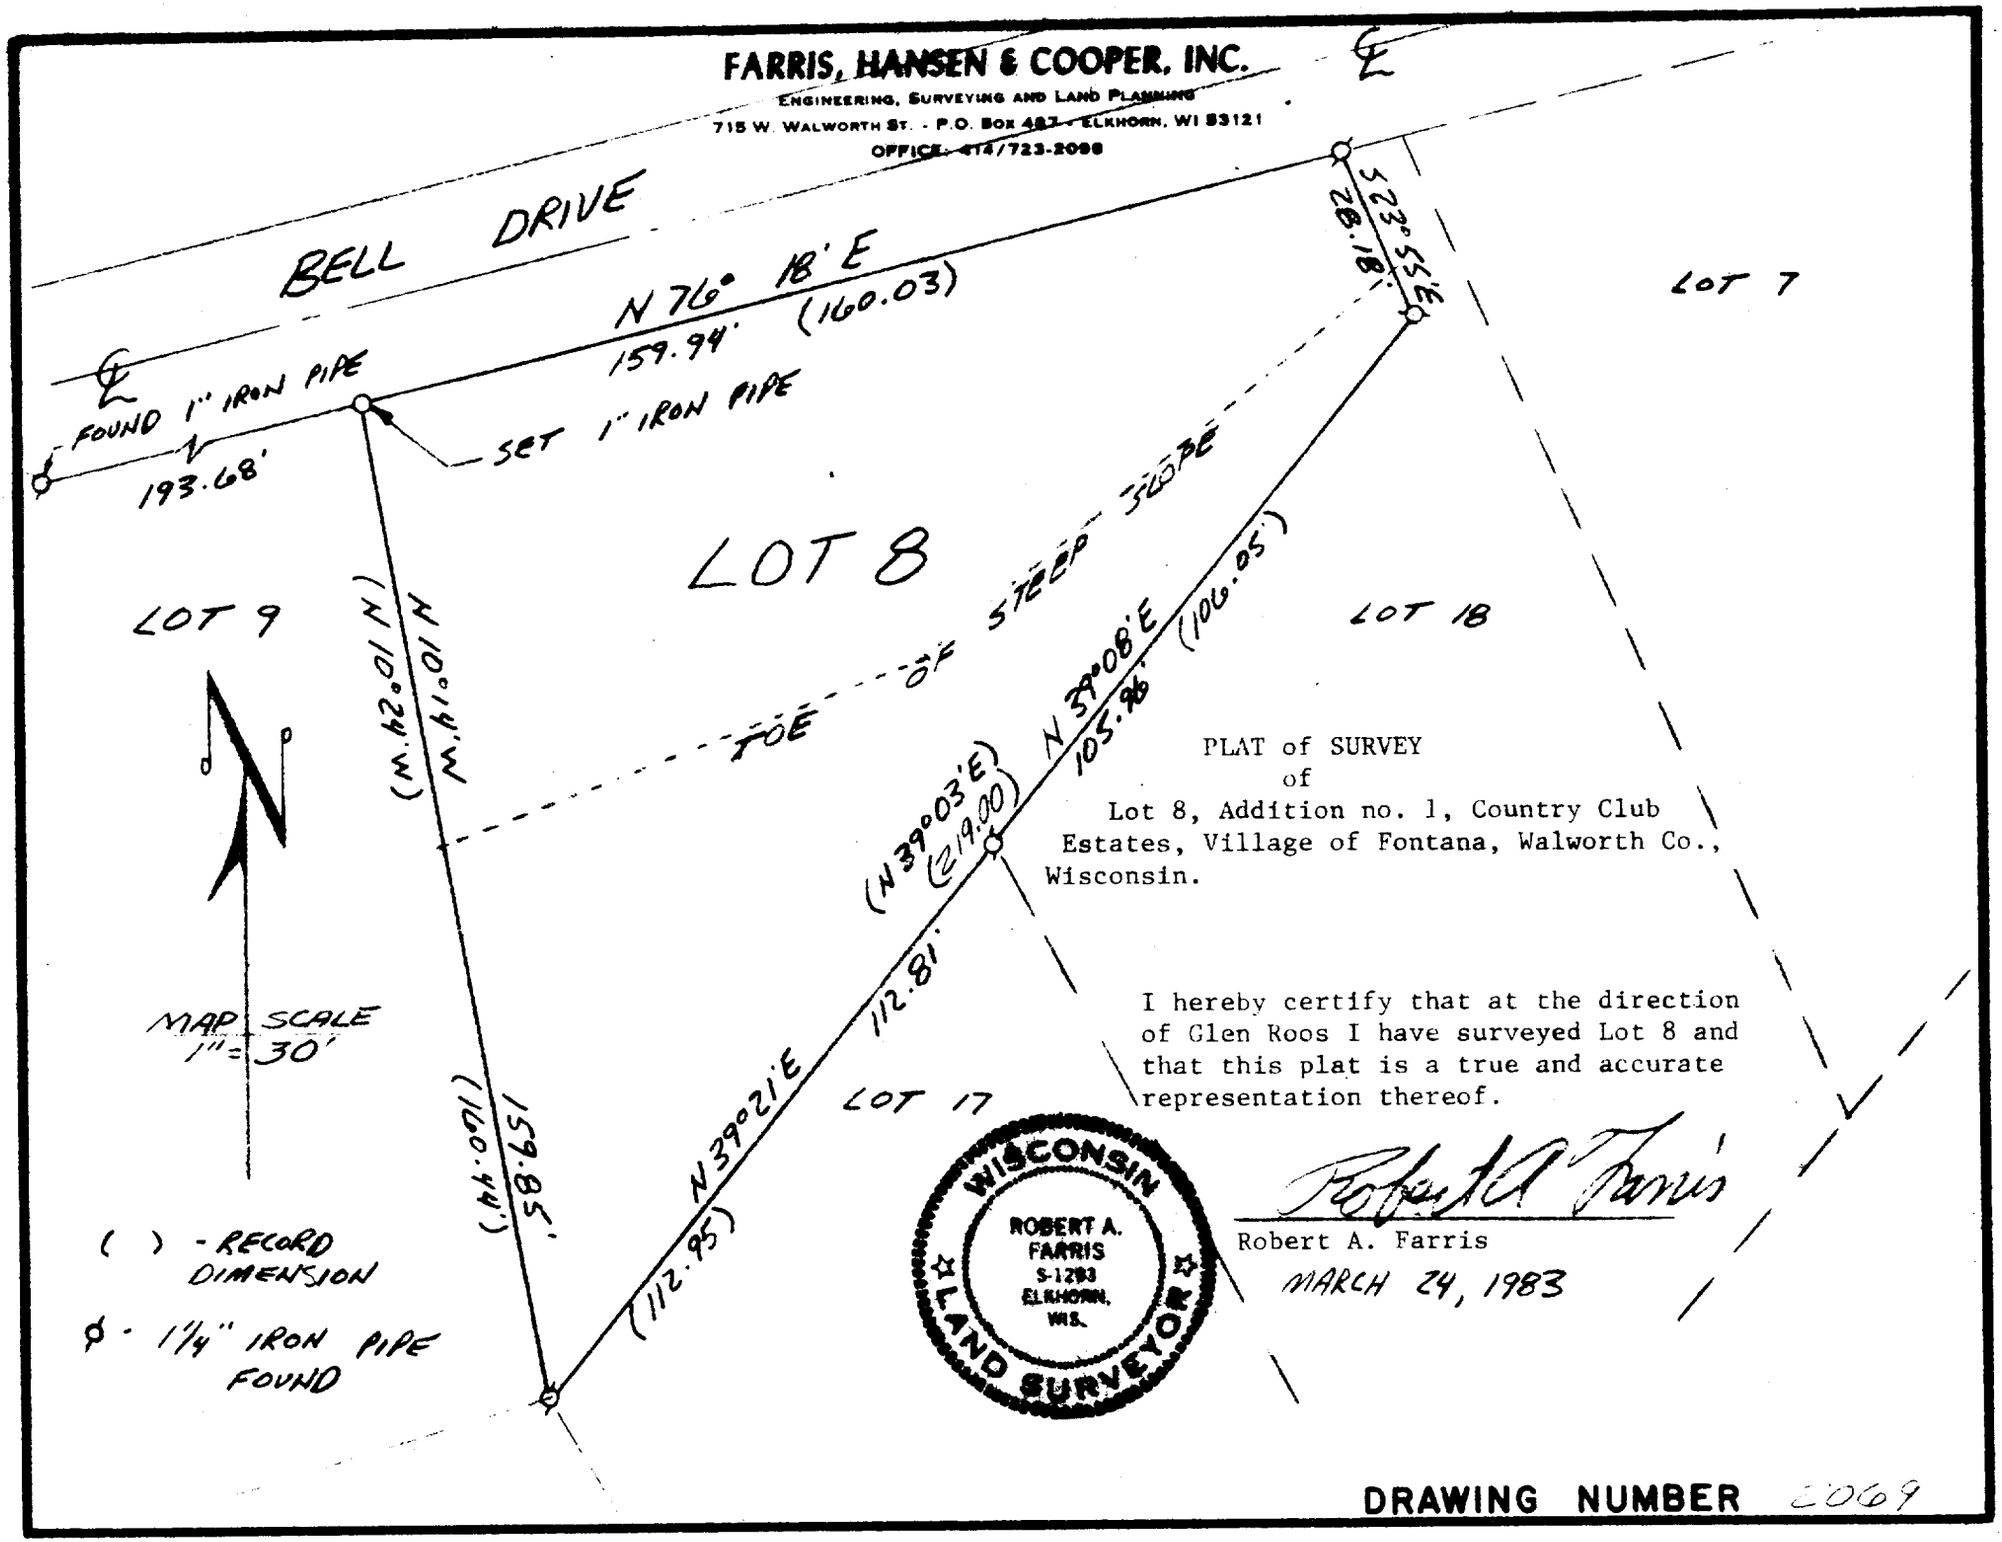


PLAT of SURVEY
of
Lot 8, Addition no. 1, Country Club Estates, Village of Fontana, Walworth Co., Wisconsin.

I hereby certify that at the direction of Glen Roos I have surveyed Lot 8 and that this plat is a true and accurate representation thereof.

WISCONSIN
ROBERT A. FARRIS
S-1293
ELKHORN, WIS.
LAND SURVEYOR

Robert A. Farris

Robert A. Farris

MARCH 24, 1983

DRAWING NUMBER 2069

SCT-8