
GEORGE T. DUNHAM

SURVEYING & SUBDIVIDING

DELAVAN, WISCONSIN

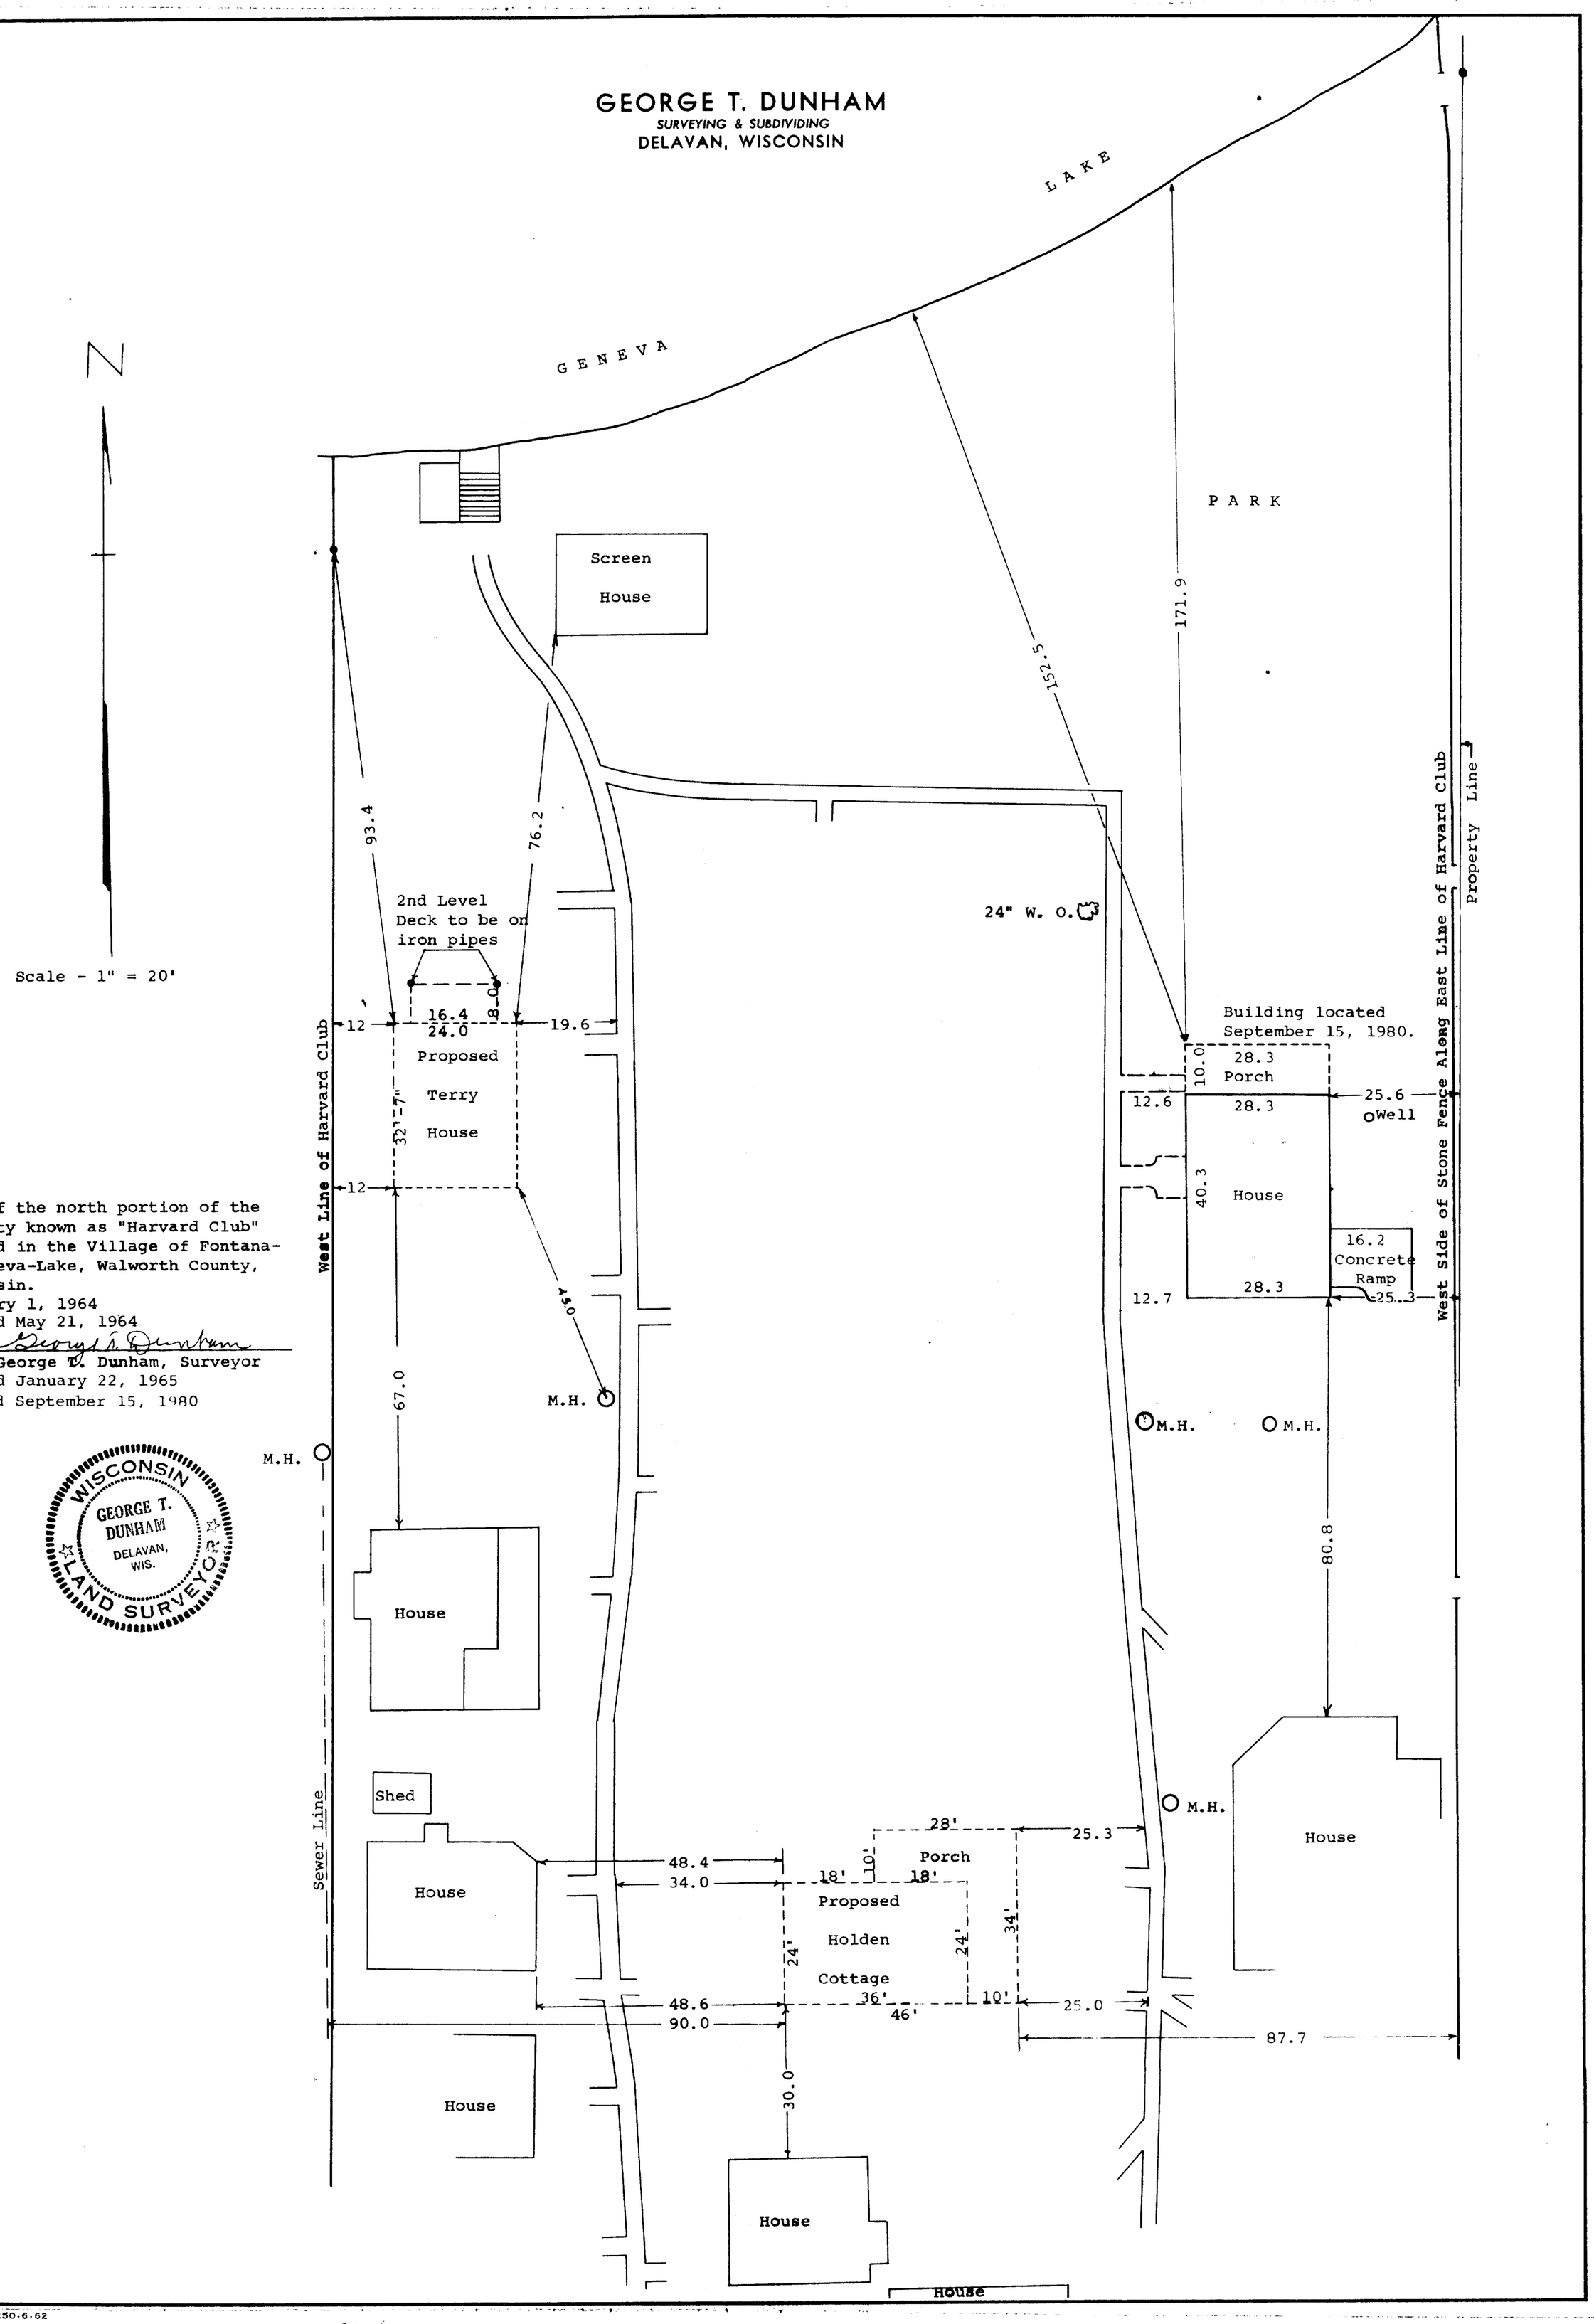

Plat of the north portion of the property known as "Harvard Club" located in the Village of Fontana-on-Geneva-Lake, Walworth County, Wisconsin.
February 1, 1964
Revised May 21, 1964

George T. Dunham, Surveyor
Revised January 22, 1965
Revised September 15, 1980

WISCONSIN
GEORGE T. DUNHAM
DELAVAN, WIS.
LAND SURVEYOR

K & E—195L 250-6-62

SGE-1 (Harvard Club)
Lot 1 of R.H. Gardner's Subd.

5-583D 5-75