
KOLB LAND CONSULTING, INC.

LAND SURVEYING · SUBDIVIDING · LAND PLANNING

LAKE GENEVA, WISCONSIN 53147 WHITEWATER, WISCONSIN 53190

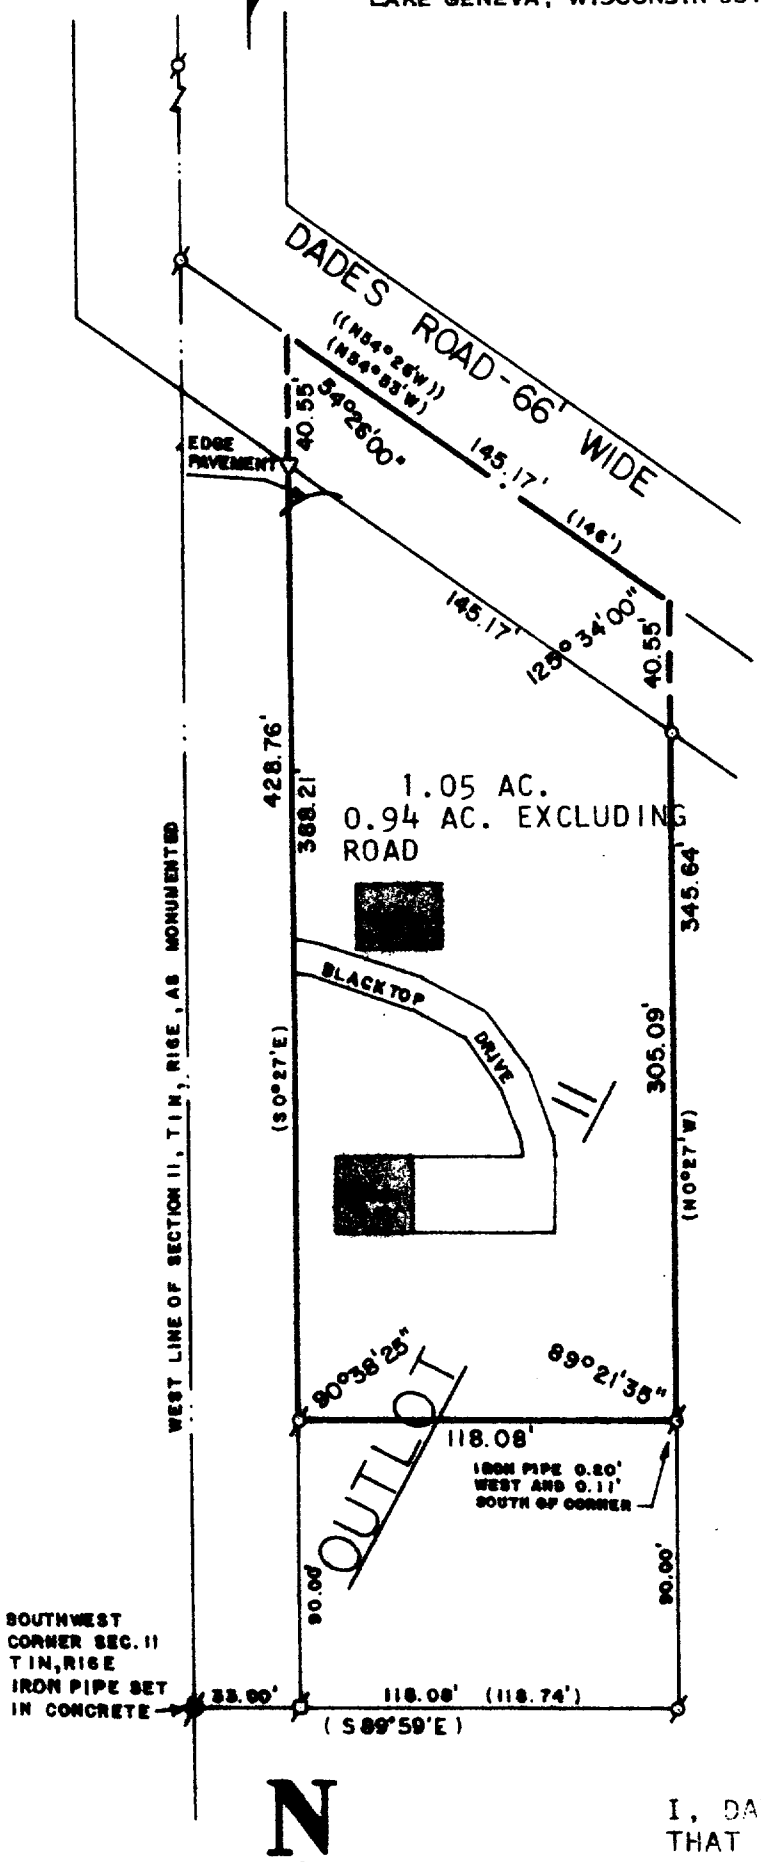

SCALE: 1"=60'

LEGEND

- ø- IRON PIPE FOUND
- ø- SQ. IRON ROD FOUND
- o- IRON PIPE SET
- ▽- RAILROAD SPIKE SET
- ()- RECORDED AS
- (())- AS SHOWN ON EXISTING SURVEYS

PLAT OF SURVEY OF

OUTLOT 11, EXCEPTING THE SOUTH 90.00 FEET, OF ASSESSOR'S PLAT NO. 1 OF C.L.DOUGLASS ADDITON TO THE VILLAGE OF FONTANA-ON-GENEVA LAKE, T1N, R16E, WALWORTH COUNTY, WISCONSIN

ORDERED BY: JERRY GLASS
FOR
LAWRENCE F. GOSCHI

WISCONSIN DAVID F ABELL S-1596 REGISTERED LAND SURVEYOR

I, DAVID F. ABELL, DO HEREBY CERTIFY THAT I HAVE SURVEYED THE PROPERTY HEREON DESCRIBED ACCORDING TO THE OFFICAL RECORDS, AND THAT THE PLAT HEREON IS A CORRECT REPRESENTATION OF THE LOT LINES TO THE BEST OF MY KNOWLEDGE AND BELIEF.

David F. Abell

DAVID F. ABELL
WISCONSIN REGISTERED LAND SURVEYOR, S-1596

DATE JULY 10, 1981

STEV-17

5-594-K ✓