
KOLB LAND CONSULTING, INC.
LAKE GENEVA, WISCONSIN

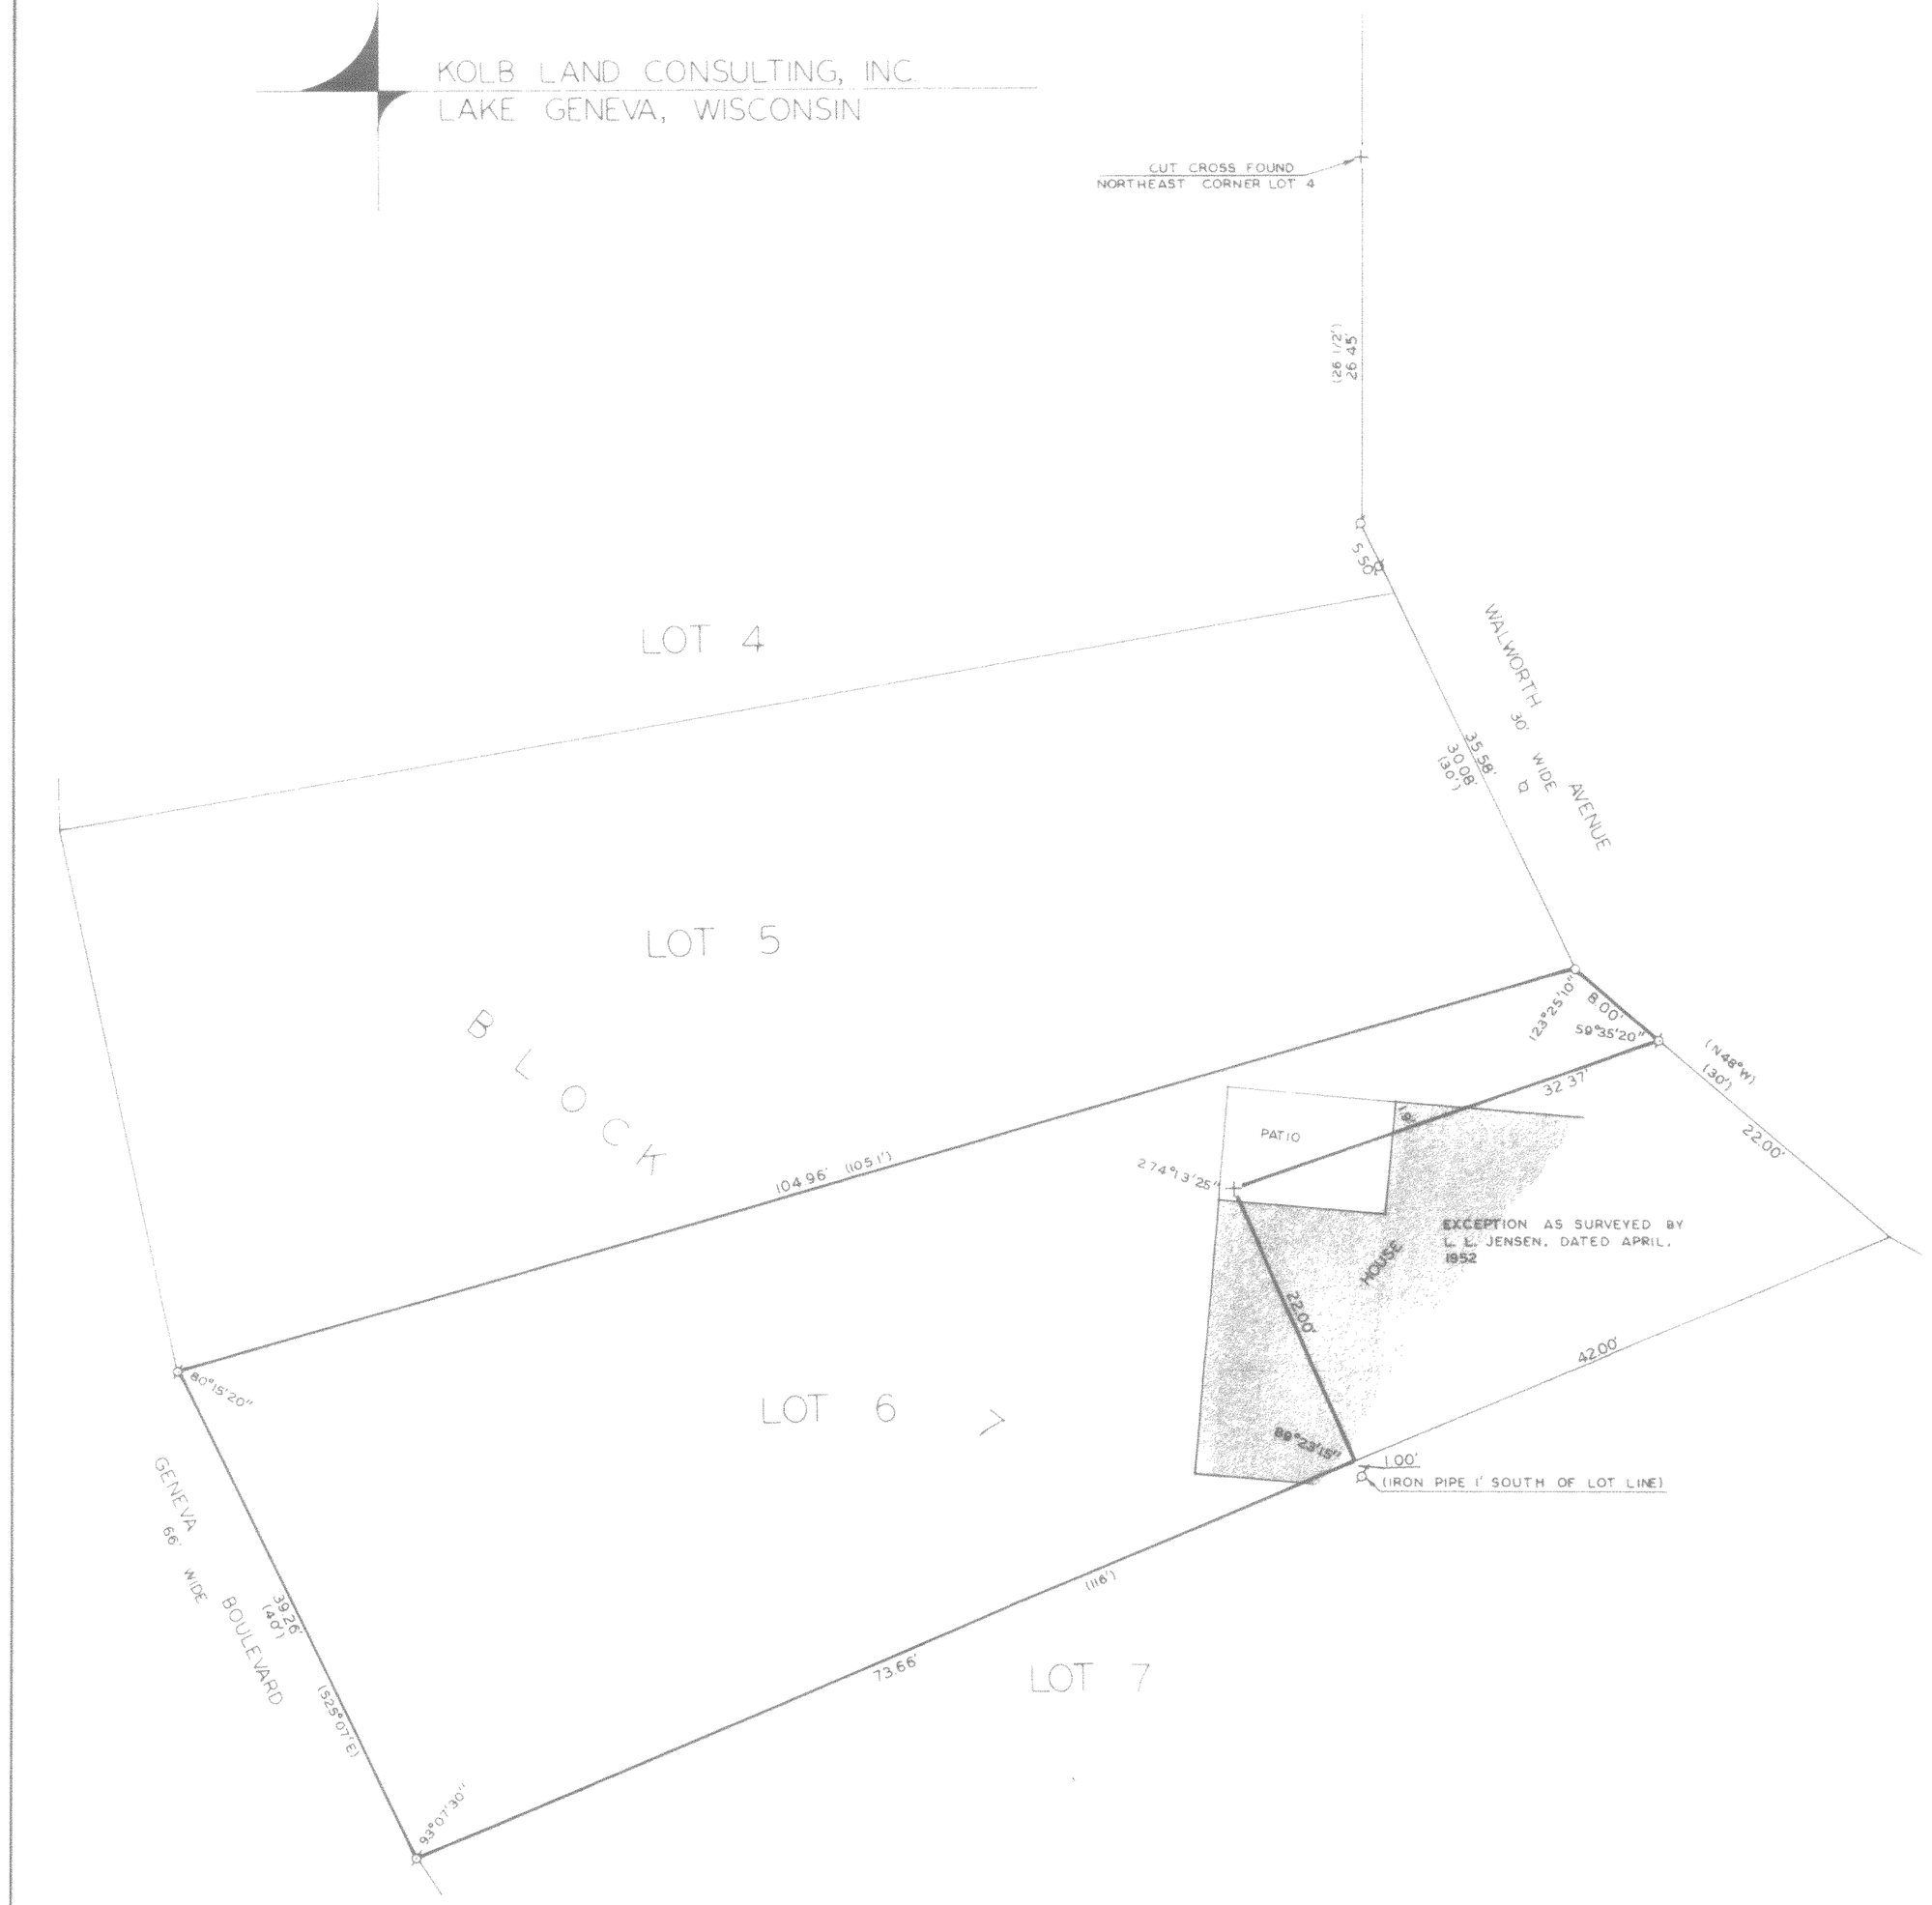

PLAT OF SURVEY OF

PART OF LOT 6, BLOCK 7, GLENWOOD SPRINGS, A SUBDIVISION LOCATED IN THE VILLAGE OF FONTANA-ON-GENEVA LAKE, WALWORTH COUNTY, WISCONSIN.

ORDERED BY: TOM NICHOLSON

FOR: GLENWOOD SPRINGS CLUB
P.O. BOX 298
FONTANA, WI 53125

SCALE: 1"=10'

ø - IRON PIPE FOUND
o - IRON PIPE PLACED
+ - CUT CROSS IN CONCRETE
() - RECORDED AS

WISCONSIN LAND SURVEYOR

I, HAROLD H. KOLB, DO HEREBY CERTIFY THAT I HAVE SURVEYED THE PROPERTY HEREON DESCRIBED ACCORDING TO THE OFFICIAL RECORDS, AND THAT THE PLAT HEREON IS A CORRECT REPRESENTATION OF THE LOT LINES TO THE BEST OF MY KNOWLEDGE AND BELIEF.

Harold H. Kolb
HAROLD H. KOLB
WISCONSIN REGISTERED LAND SURVEYOR, S-187

DATE July 29, 1980

565-25

5-598-K