
#112-60

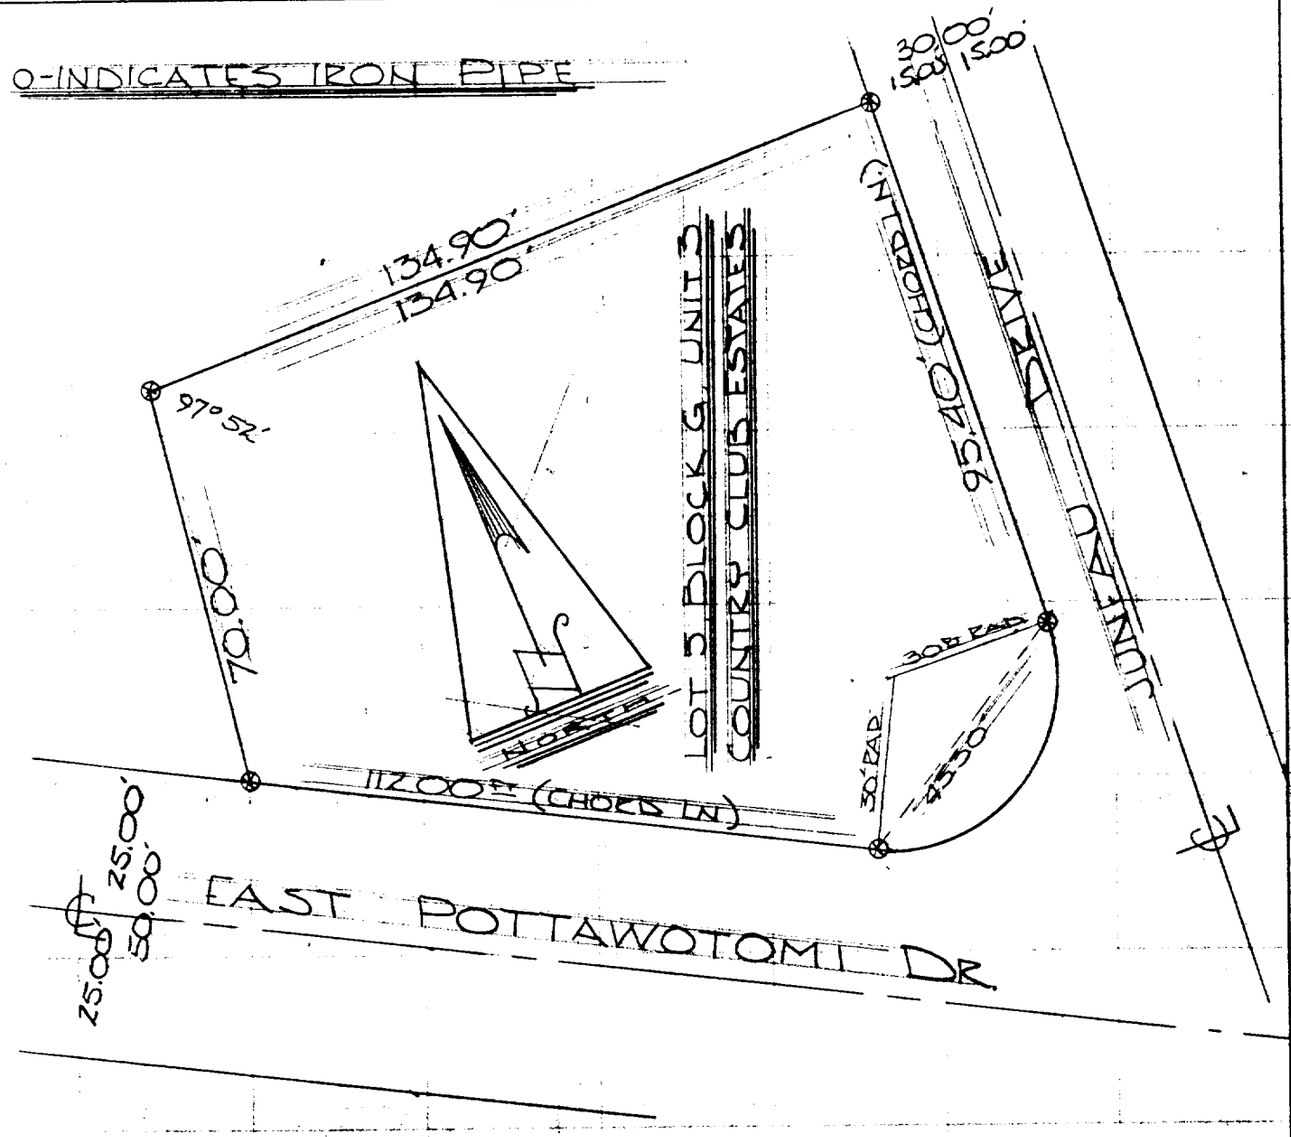

DESCRIPTION: Lot 5 of Block "G" of Unit 3 of Country Club Estates Subdivision in the Village of Fontana, Walworth County, Wisconsin.

CERTIFICATE: I, James F. Biagi, surveyor, do hereby certify that I have surveyed the property hereon described.

May 25, 1965.

James F. Biagi

James F. Biagi, RLS 272

WISCONSIN
JAMES F.
BIAGI
MILWAUKEE,
WIS.
LAND SURVEYOR

5-5B

SC03-114