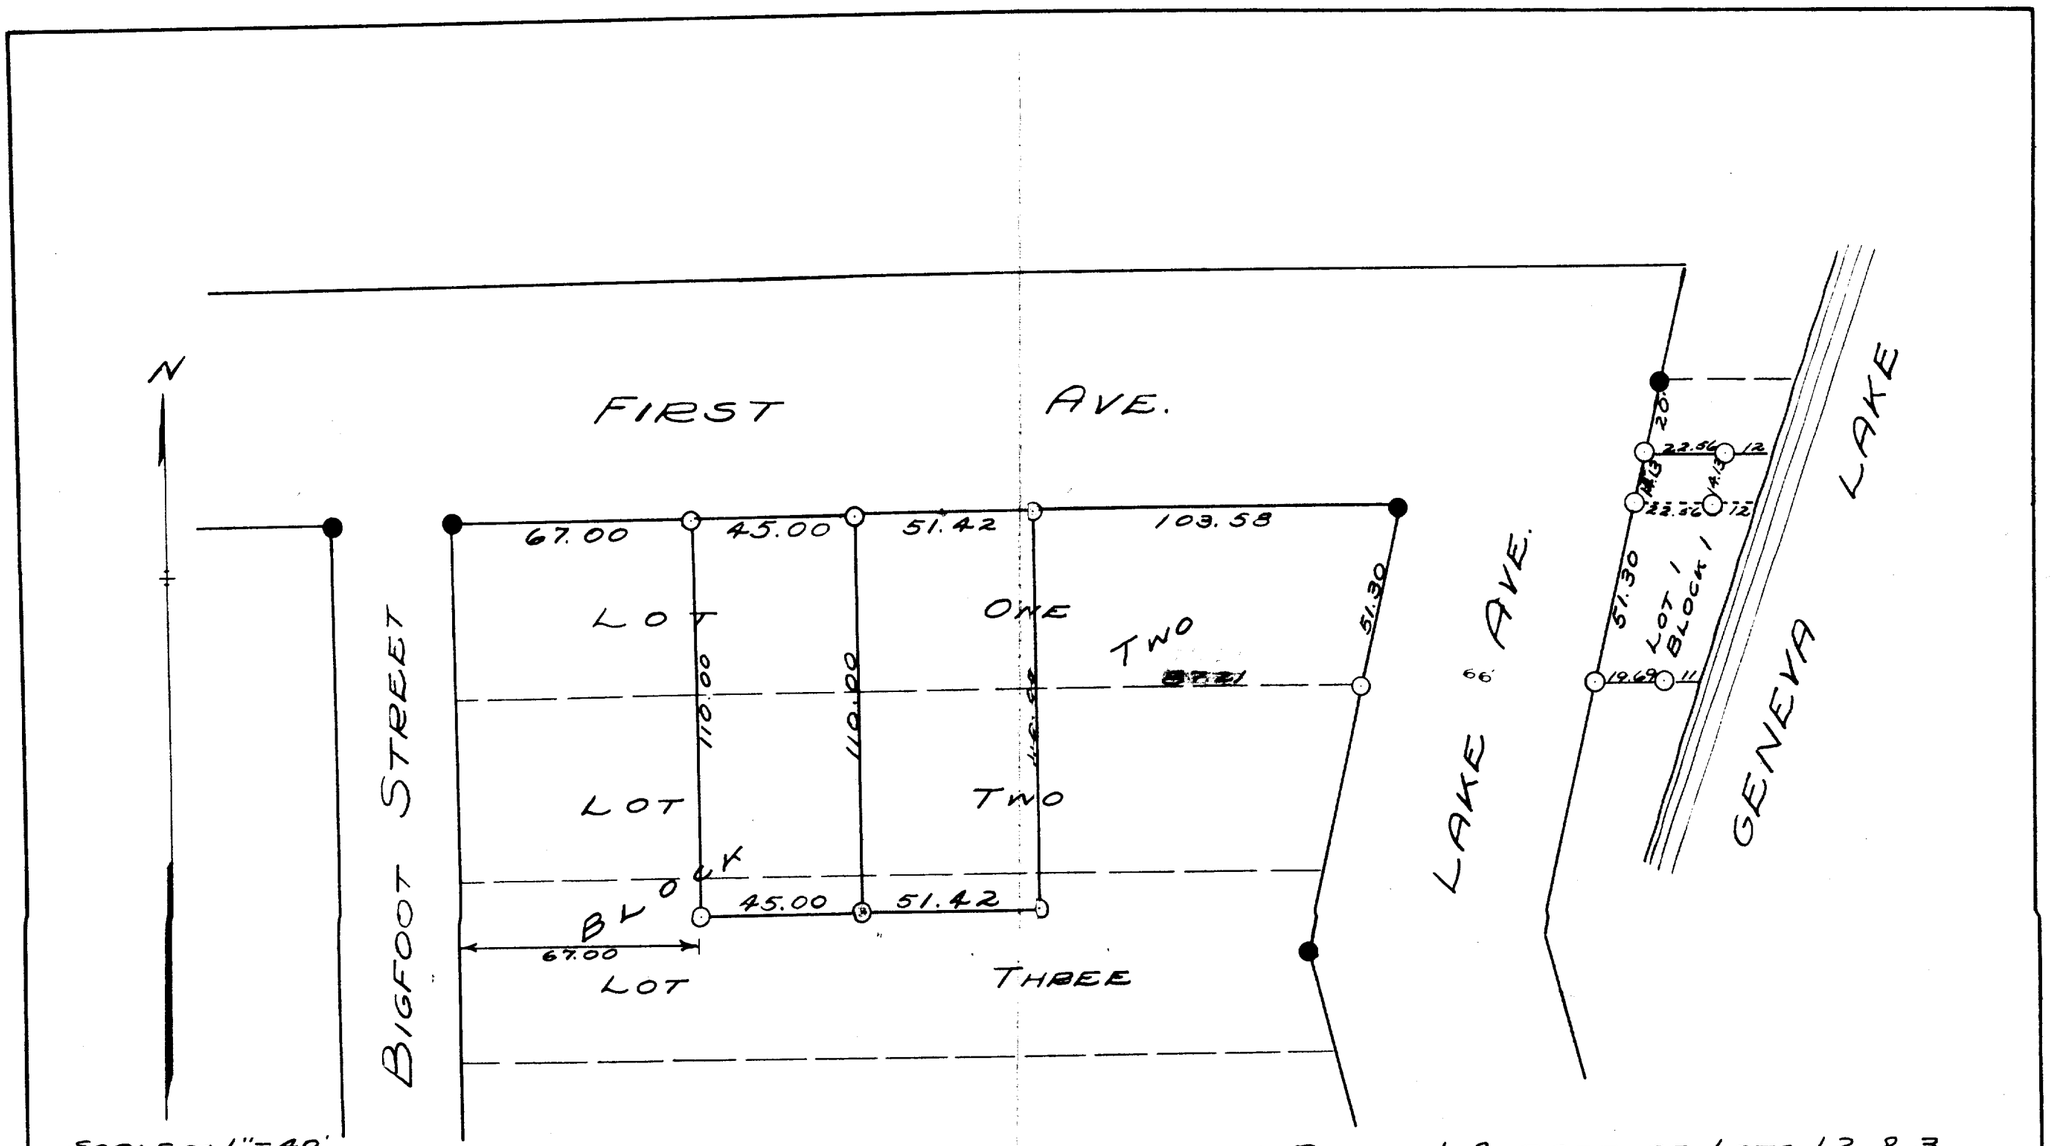


SCALE ~ 1"=40'
● = CONC. MONU.
○ = IRON PIPE.

PLAT OF SURVEY OF PART OF LOT 1, BLOCK 1 & PART OF LOTS 1, 2, & 3 OF BLOCK 2 OF D.A. REID'S ADDITION TO REID'S PARK, IN THE VILLAGE OF FONTANA-ON-GENEVA-LAKE, WALWORTH COUNTY, WISCONSIN.

MARCH, 1940

Floyd L. Jensen
COUNTY SURVEYOR

SRA-6

5-5 J