
DUNHAM SURVEYING, S.C.

SURVEYING & SUBDIVIDING
DELAVAN, WISCONSIN 53115

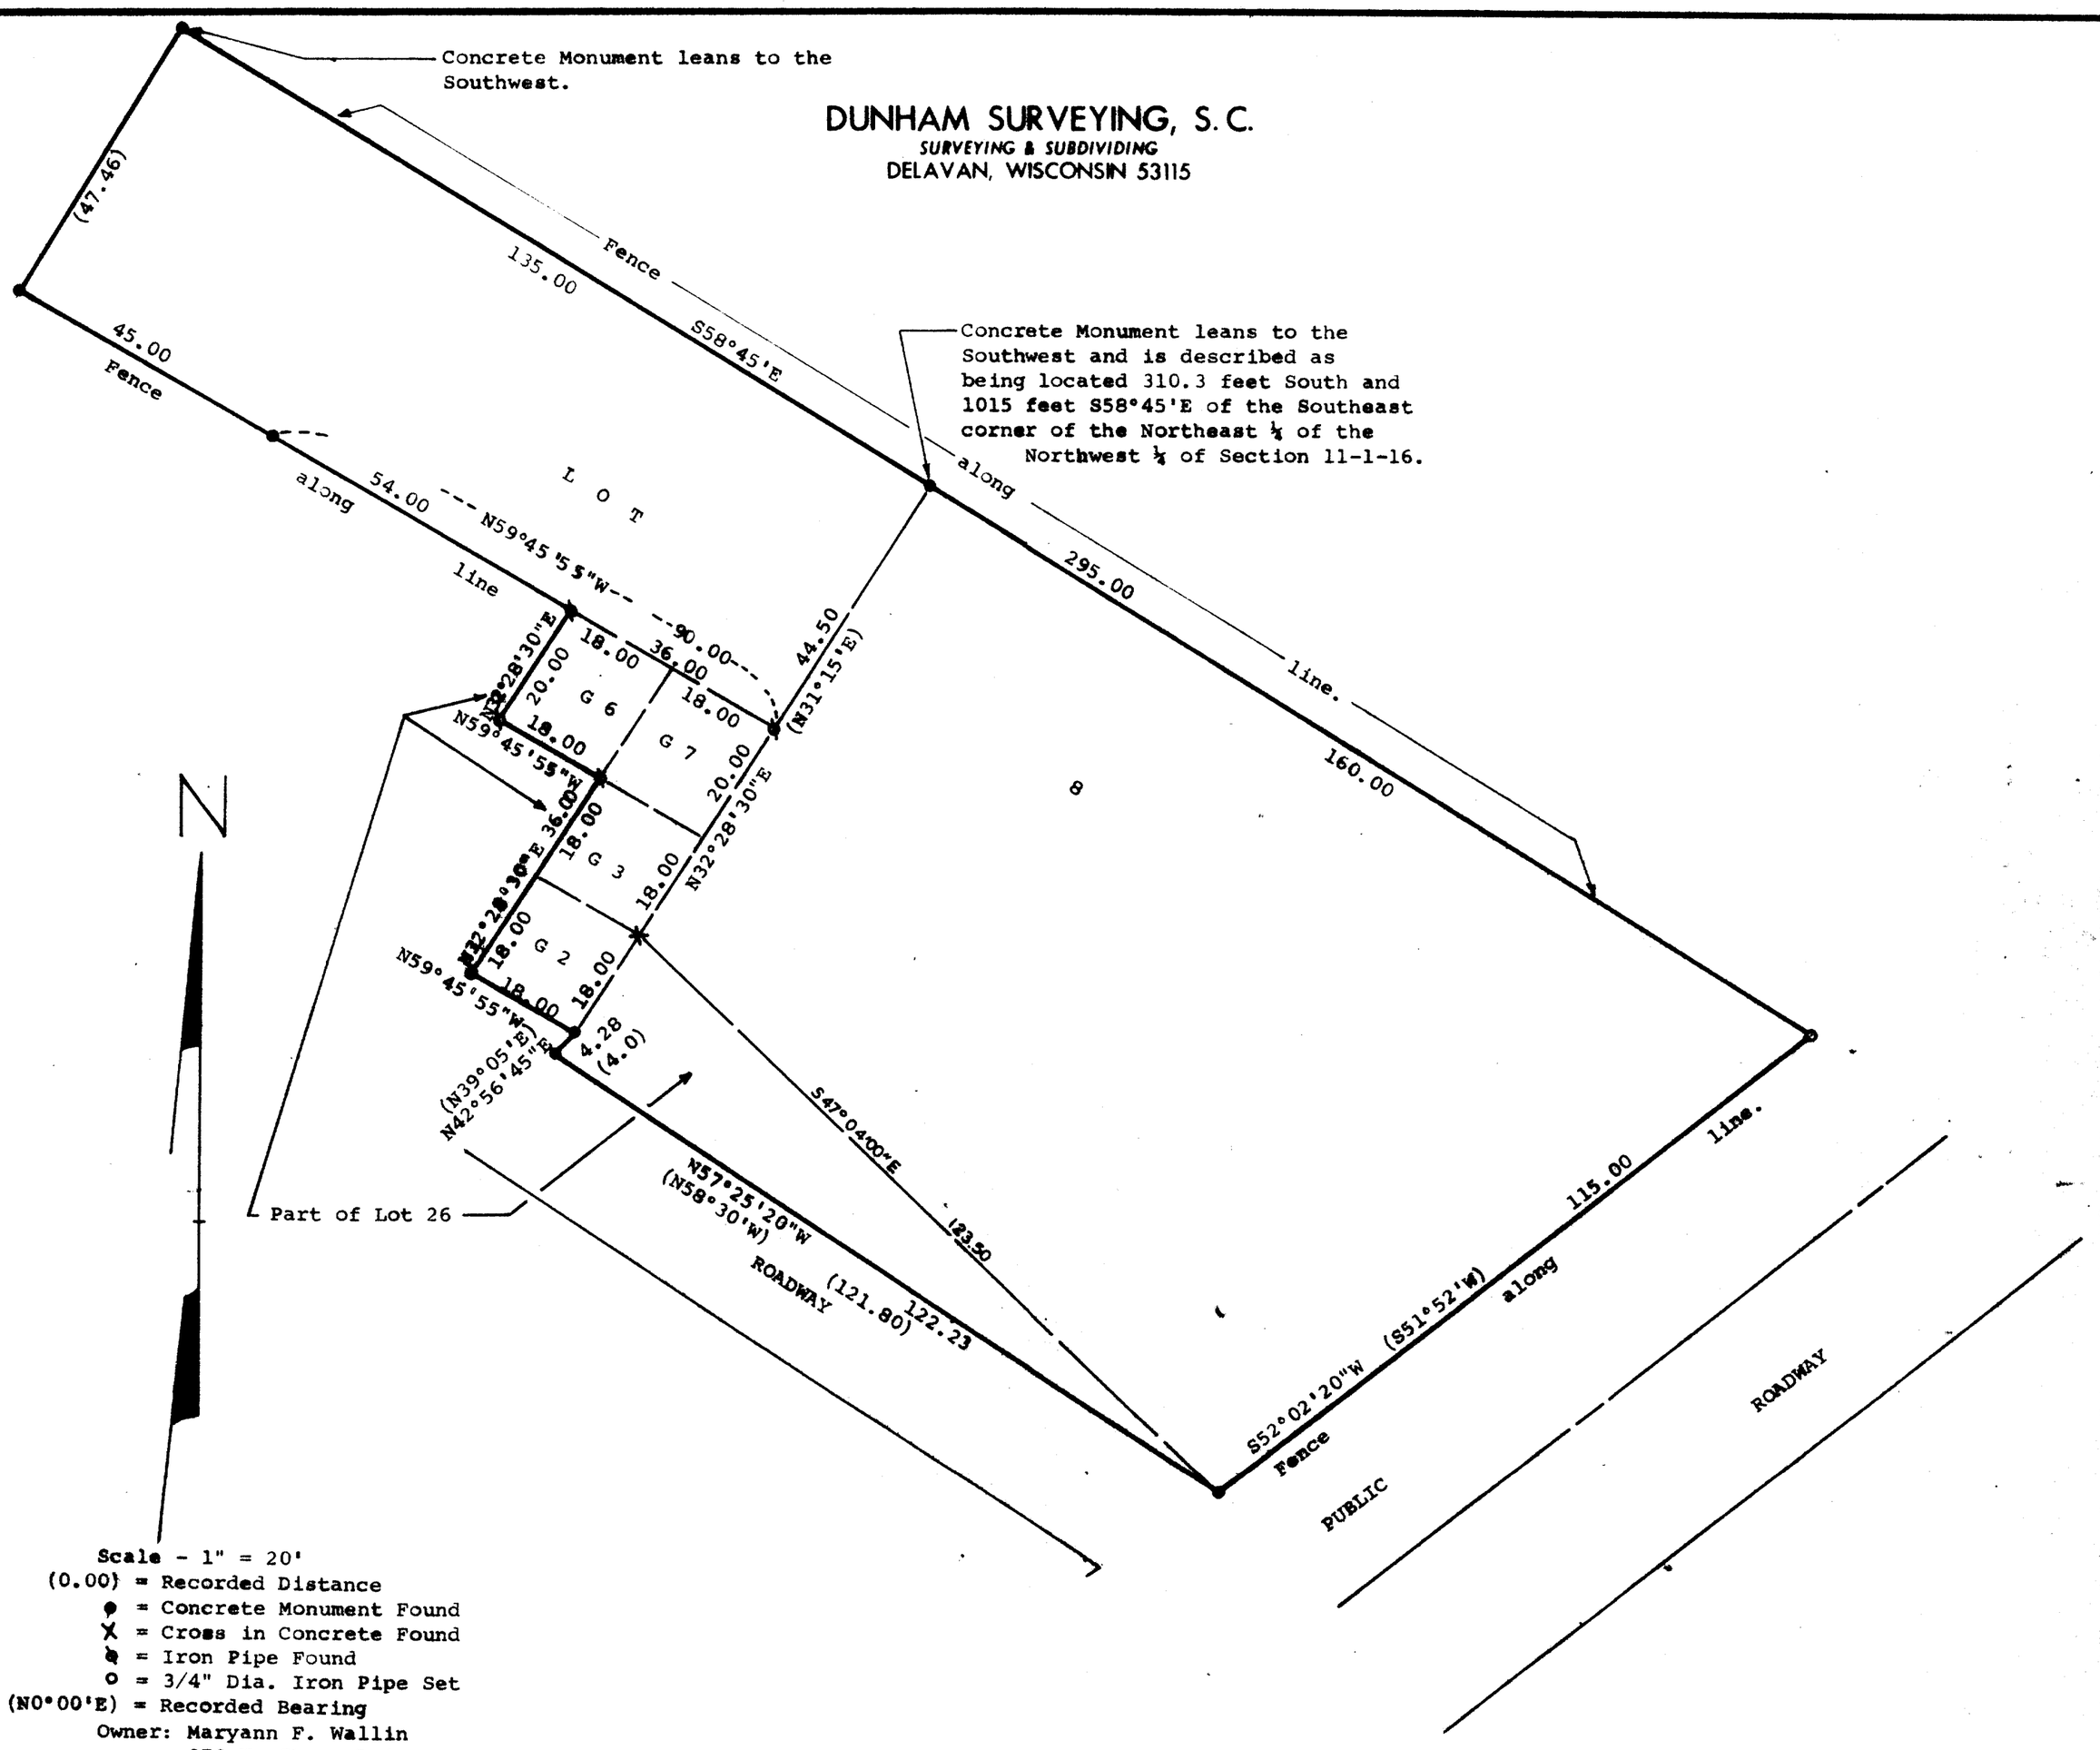

Scale - 1" = 20'
(0.00) = Recorded Distance
● = Concrete Monument Found
X = Cross in Concrete Found
◔ = Iron Pipe Found
o = 3/4" Dia. Iron Pipe Set
(N0°00'E) = Recorded Bearing

Owner: Maryann F. Wallin
373 N. Shore Drive
Fontana, Wisconsin 53125

Note: Bearings are referenced to the Northeasterly line of Lot 8, recorded bearing of S58°45'E.

STATE OF WISCONSIN) ss
COUNTY OF WALWORTH)

I, George T. Dunham, Surveyor, certify that I have surveyed the property described as follows,

Lot 8 of the Revised Plat of The Gardens Subdivision, as recorded June 9, 1927 in Volume 8 of Plats, Pages 121 and 122, Walworth County Records, said land located in the Village of Fontana-on-Geneva Lake, Walworth County, Wisconsin. Also a part of Lot 26 of said subdivision described as follows: Commencing at a point that is 44.50 feet, S32°28'30"W (recorded as S31°15'W) of a point that is 1015 feet, S58°45'E of a point that is 310.3 feet South of the Southeast corner of the Northeast ¼ of the Northwest ¼ of Section 11, T1N, R16E; thence from this place of beginning S32°28'30"W, 38.00 feet; thence S47°04'00"E, 123.50 feet to the [illegible] corner of Lot 8 of said subdivision; thence N57°25'20"W, 122.23 feet to a concrete monument; thence N42°56'45"E, 4.28 feet to a concrete monument; thence N59°45'55"W, 18.00 feet; thence N32°28'30"E, 36.00 feet; thence N59°45'55"W, 18.00 feet; thence N32°28'30"E, 20.00 feet; thence S59°45'55"E, 36.00 feet to the place of beginning.

and that the above map is a true representation thereof and shows the size and location of the property, its exterior boundaries, the location of all visible structures and dimensions of all principal buildings thereon, boundary fences, apparent easements, roadways and visible encroachments, if any.

This survey is made for the use of the present owners of the property, and also those who purchase, mortgage, or guarantee the title thereto within one (1) year from date hereof.

June 1, 1982.

George T. Dunham

George T. Dunham, Surveyor

WISCONSIN
GEORGE T. DUNHAM
DELAVAN, WIS.
LAND SURVEYOR

H & E 10-9155

SG-00008

5-601-D