
KOLB LAND CONSULTING, INC.

LAND SURVEYING · SUBDIVIDING · LAND PLANNING

LAKE GENEVA, WISCONSIN 53147

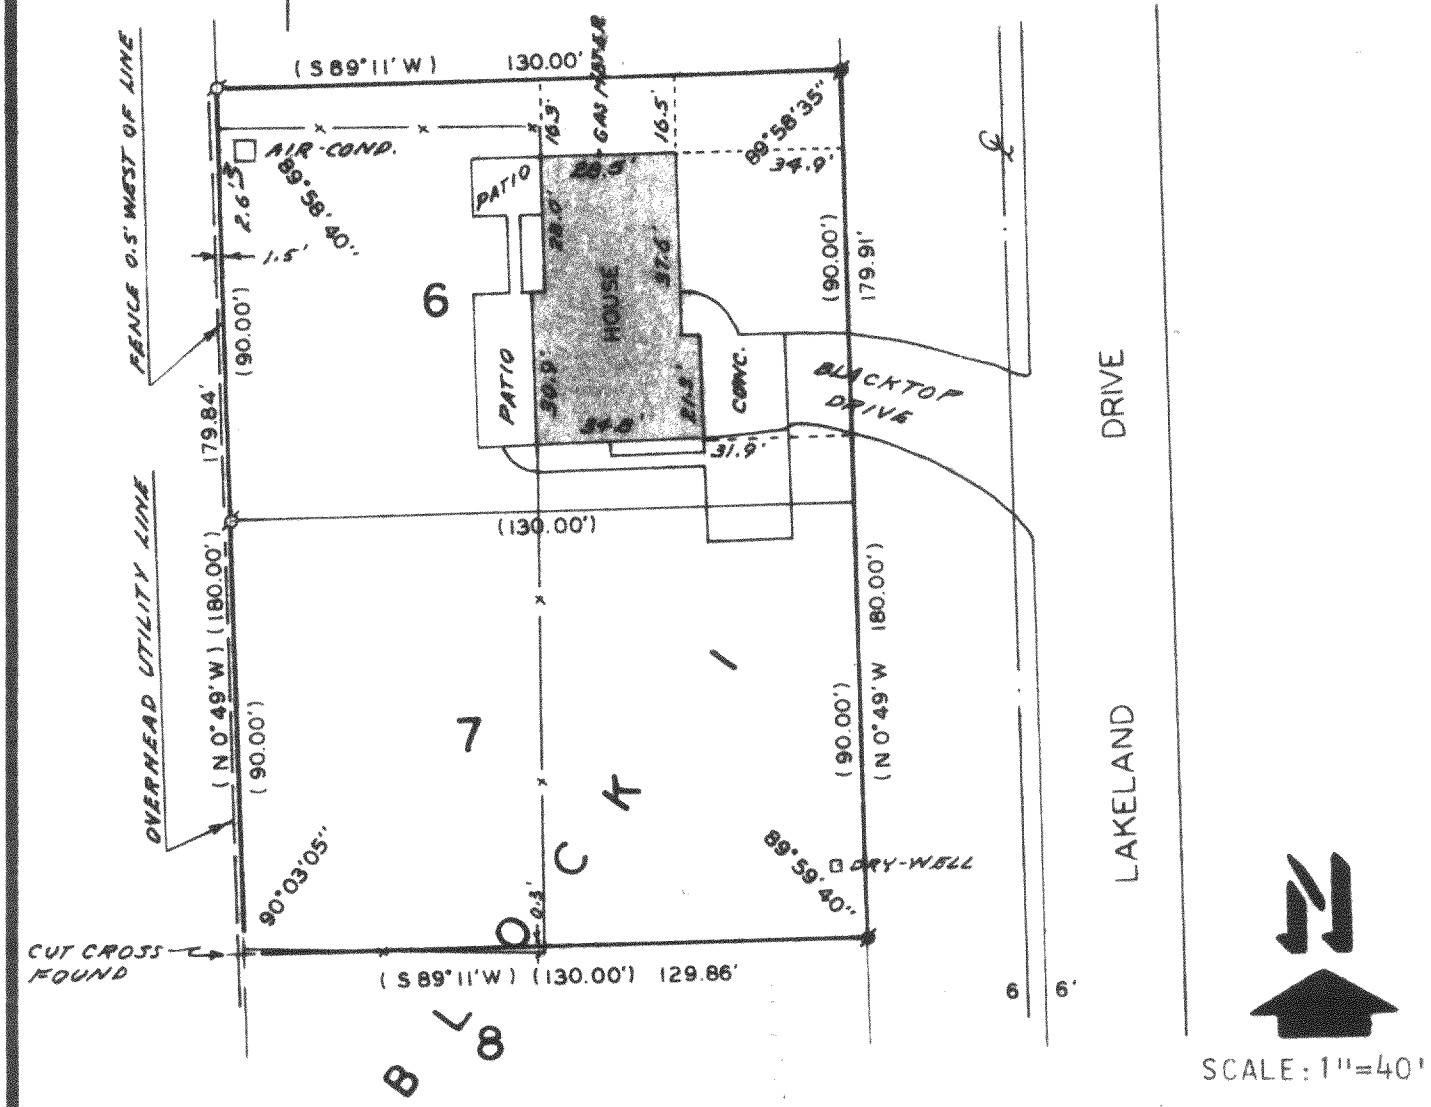

SCALE: 1"=40'

PLAT OF SURVEY OF

LOTS 6 & 7, BLOCK 1, BROOKWOOD SUBDIVISION, LOCATED IN SECTION 18, T 1 N, R 17 E, VILLAGE OF FONTANA-ON-GENEVA LAKE, WALWORTH COUNTY, WISCONSIN

ORDERED BY:
THE RAULAND AGENCY
118 KENOSHA
WALWORTH, WI. 53184

LEGEND
- ⌀ IRON PIPE FOUND
- ⌀ 2"X30" IRON PIPE SET OVER FOUND IRON PIPE.
- —x— FENCE
- ( ) AS PLATTED

I HEREBY CERTIFY THAT I HAVE SURVEYED THE ABOVE DESCRIBED PROPERTY AND THAT THE ABOVE MAP IS A TRUE REPRESENTATION THEREOF AND SHOWS THE SIZE AND LOCATION OF THE PROPERTY, ITS EXTERIOR BOUNDARIES, THE LOCATION OF ALL VISIBLE STRUCTURES AND DIMENSIONS OF ALL PRINCIPAL BUILDINGS THEREON, BOUNDARY FENCES, APPARENT EASEMENTS, ROADWAYS AND VISIBLE ENCROACHMENTS, IF ANY.

THIS SURVEY IS MADE FOR THE USE OF THE PRESENT OWNERS OF THE PROPERTY, AND ALSO THOSE WHO PURCHASE, MORTGAGE, OR GUARANTEE THE TITLE THERETO WITHIN ONE (1) YEAR FROM THE DATE HEREOF.

WISCONSIN HAROLD H. KOLB S-187 LAKE GENEVA, WIS. LAND SURVEYOR

Harold H. Kolb

WISCONSIN REGISTERED LAND SURVEYOR, S- 187

DATE SEPT. 8, 1983

SBS-6
11-7

5-604-K