
DUNHAM SURVEYING, S.C.
SURVEYING & SUBDIVIDING
DELAVAN, WISCONSIN 53115

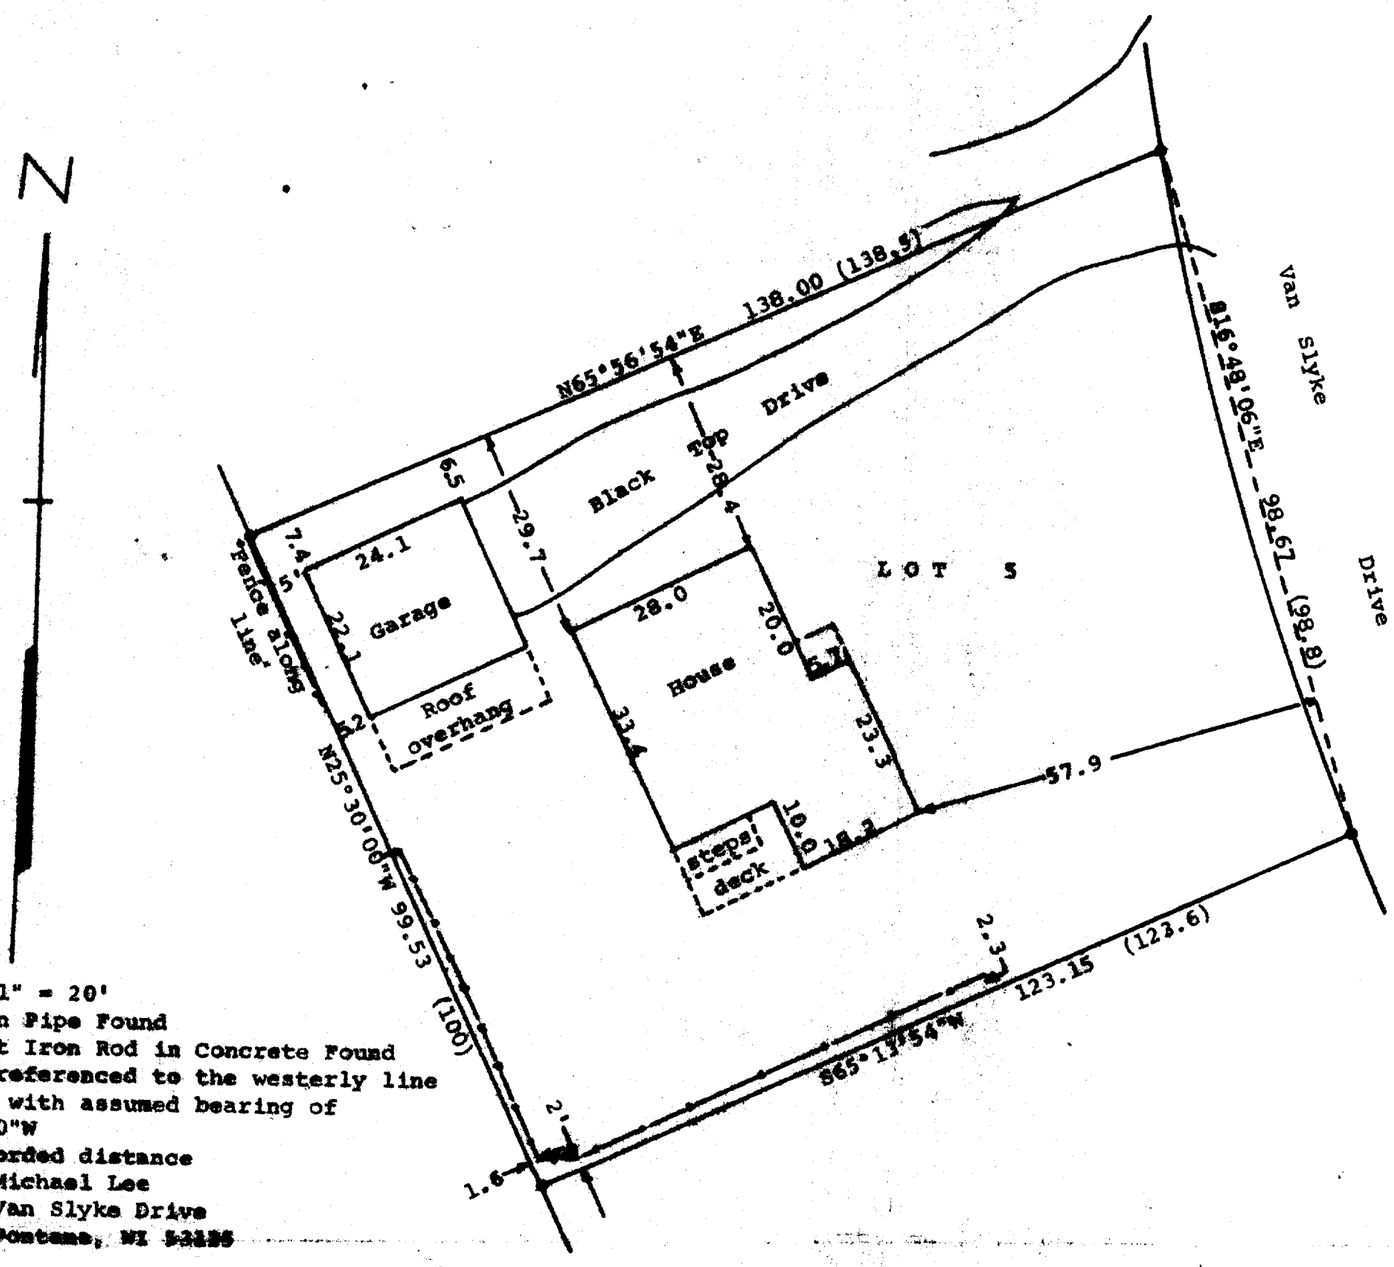

Scale - 1" = 20'
●= Iron Pipe Found
●= Bent Iron Rod in Concrete Found
Bearings referenced to the westerly line of Lot 5 with assumed bearing of N25°30'00"W
(0.00) = recorded distance
Owner: Michael Lee
Van Slyke Drive

STATE OF WISCONSIN) SS
COUNTY OF WALWORTH)

I, George T. Dunham, Surveyor, certify that I have surveyed the property described as follows:

Lot 5, Block "D", Unit No. 3, Country Club Estates, located in the Village of Fontana-on-Geneva Lake, Walworth County, Wisconsin, and that the above map is a true representation thereof and shows the size and location of the property, its exterior boundaries, the locationof all visible structures and dimensions of all principal buildings thereon, boundary fences, apparent easements roadways and visible encroachments, if any.

This survey is made for the use of the present owners of the property, and also those who purchase, mortgage, or guarantee the title thereto within one (1) year from date hereof.

December 13, 1982

George T. Dunham, Surveyor

WISCONSIN
GEORGE T. DUNHAM
DELAVAN, WIS.
S-306
LAND SURVEYOR

SC03-57

5-6025-D