
DUNHAM SURVEYING, S.C.
SURVEYING & SUBDIVIDING
DELAVAN, WISCONSIN 53115



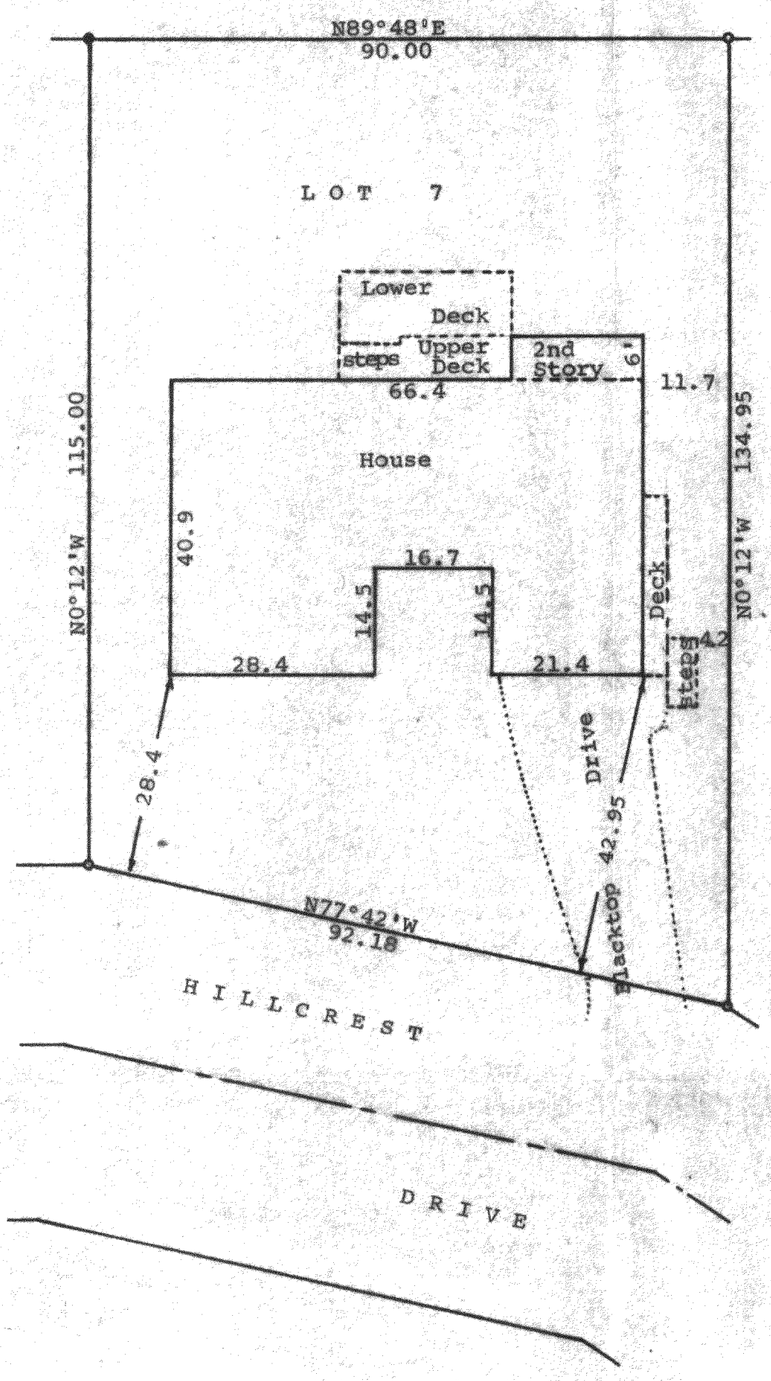

Scale - 1" = 20'
● = 5" Concrete Monument Found
o = 1" Iron Pipe Found
Bearings used are referenced to the N89°48'E recorded along the north line of Lot 7
Owner: Anne Litt
Fontana, WI 53125

STATE OF WISCONSIN)
COUNTY OF WALWORTH) SS

I, George T. Dunham, Surveyor, certify that I have surveyed the property described as follows:

Lot 7, Addition D to Country Club Estates, a subdivision located in the SW¼ of the SE¼ of Section 14, T 1 N, R 16 E, Village of Fontana on Geneva Lake, Walworth County, Wisconsin.

and that the plat shown above is a true representation thereof and shows the size and location of the property, its exterior boundaries, the location of all visible structures, and dimensions of all principal buildings thereon, boundary fences, apparent easements, roadways and visible encroachments, if any, and that I have surveyed the property hereon described according to the official records, to the best of my knowledge and belief.

May 2, 1984

George T. Dunham, Surveyor

WISCONSIN
GEORGE T. DUNHAM
DELAVAN, WIS.
S-306
LAND SURVEYOR

SCTD-7

5-608-D

K & E 10-9155