
HAROLD H. KOLB

REGISTERED PROFESSIONAL LAND SURVEYOR
LAKE GENEVA, WISCONSIN

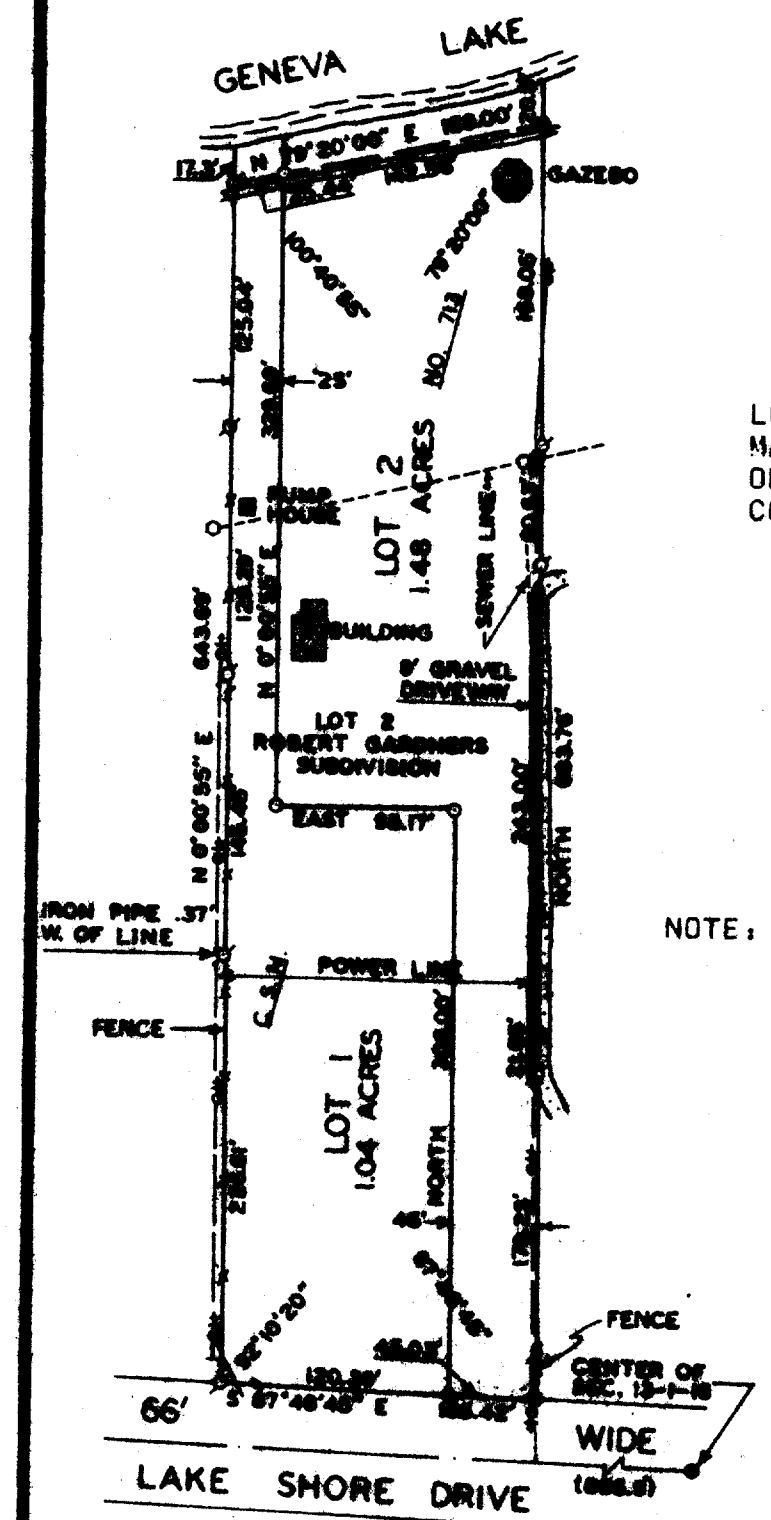

PLAT OF SURVEY OF

LOT 1 AND LOT 2 OF CERTIFIED SURVEY MAP NO. 713 LOCATED IN THE VILLAGE OF FONTANA-ON-GENEVA LAKE, WALWORTH COUNTY, WISCONSIN.

NOTE: THE EAST LINE OF LOT 2 OF ROBERT GARDNERS SUBDIVISION IS ASSUMED "NORTH."

OWNER: DR. ISHOONA I. BEBLIS

WISCONSIN HAROLD H. KOLB S-187 LAKE GENEVA, WIS. LAND SURVEYOR

N

SCALE IN FEET

LEGEND

O — IRON PIPE PLACED, ⅝" x 24" 1.13 LB./LIN. FT.
● — CONCRETE MONUMENT, 5" DIA. x 30"
□ — IRON PIPE FOUND
P — MANHOLE
( ) - RECORDED AS
Δ - SPIKE FOUND
⌀ - POWER POLE

I HEREBY CERTIFY THAT I HAVE SURVEYED THE ABOVE DESCRIBED PROPERTY AND THAT THE ABOVE MAP IS A TRUE REPRESENTATION THEREOF AND SHOWS THE SIZE AND LOCATION OF THE PROPERTY, ITS EXTERIOR BOUNDARIES, THE LOCATION OF ALL VISIBLE STRUCTURES AND DIMENSIONS OF ALL PRINCIPAL BUILDINGS THEREON, BOUNDARY FENCES, APPARENT EASEMENTS, ROADWAYS AND VILIBLE ENCROACHMENTS, IF ANY.
THIS SURVEY IS MADE FOR THE USE OF THE PRESENT OWNERS OF THE PROPERTY, AND ALSO THOSE WHO PURCHASE, MORTGAGE, OR [redacted]E THE TITLE THERETO WITHIN ONE (1) YEAR FROM DATE HEREOF.

Harold H. Kolb

HAROLD H. KOLB
WISCONSIN REGISTERED LAND SURVEYOR, S-187

DATE Aug 5, 1977

REVISED: DECEMBER 21, 1983

5-609-K

SA 7130000 1 + SA 7130000 2 FON-82