COOPER SURVEYING SERVICES

Rural - Residential - Commercial


Route 3, Box 255 :: Elkhorn, Wisconsin 53121

Phone (414) 723-6265

SURVEYING & PLANNING
SUBDIVISIONS - LOT SURVEYS
CONSTRUCTION STAKING - MAPPING

RECEIVED
APR 19 1984

PLAT OF SURVEY OF LOT J 16 OF COUNTRY CLUB ESTATES ADDITION J
TO THE VILLAGE OF FONTANA-ON- GENEVA LAKE WALWORTH COUNTY WIS.

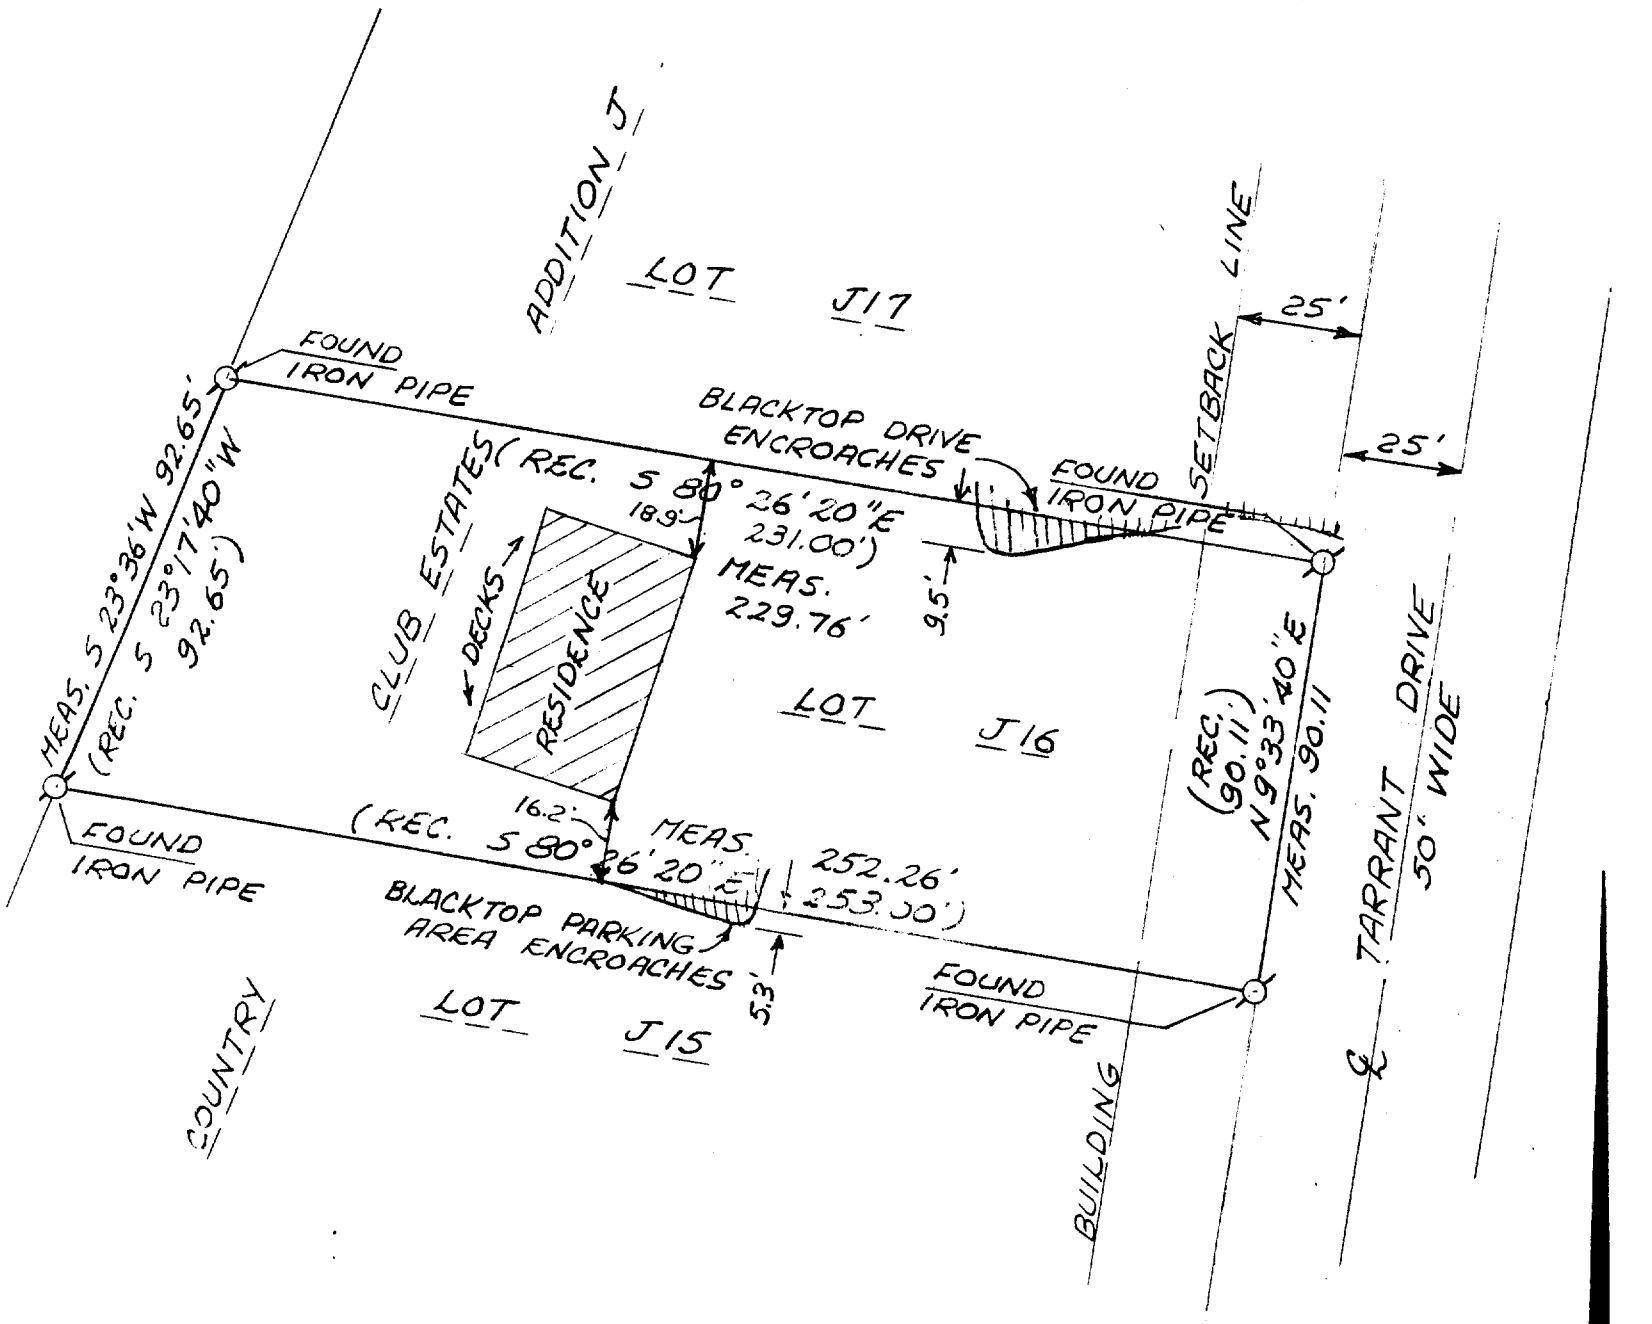

SURVEY DONE FOR: KEECE REALTY

I, DANIEL D. COOPER, REGISTERED SURVEYOR, DO HEREBY CERTIFY THAT I HAVE SURVEYED THE PROPERTY DESCRIBED HEREON AND THAT THE MAP SHOWN HEREON IS A TRUE AND ACCURATE REPRESENTATION THEROF TO THE BEST OF MY PROFESSIONAL KNOWLEDGE AND BELIEF.

DATED THIS 5th DAY OF June, 1984 Daniel D. Cooper
DANIEL D. COOPER, RLS NO. S-1464

WISCONSIN
DANIEL D. COOPER
S-1464
WIS.
LAND SURVEYOR

0 50 100
SCALE: 1"=40'

DRAWING NO. 1924