
DUNHAM SURVEYING, S. C.

SURVEYING & SUBDIVIDING

DELAVAN, WISCONSIN 53115

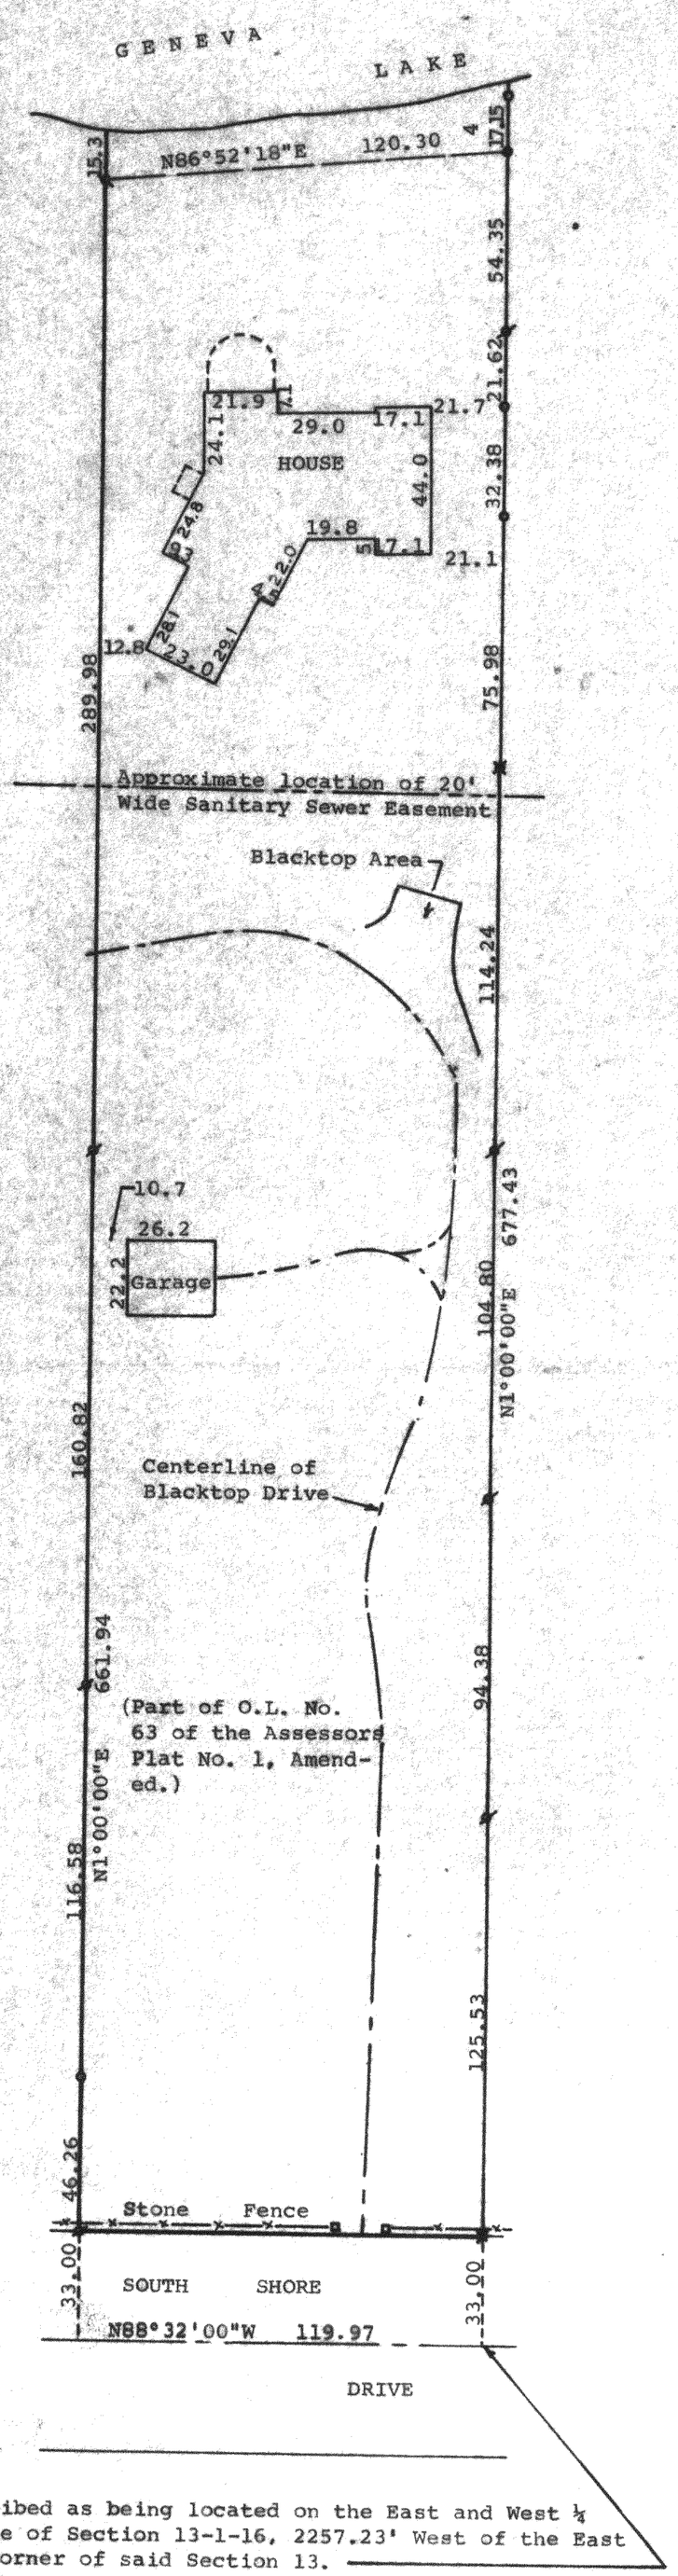

Point described as being located on the East and West ¼ Section line of Section 13-1-16, 2257.23' West of the East ¼ Section corner of said Section 13.

N

Scale - 1" = 40'

- ⌀ = 1" Iron Pipe Found
- ⌀ = 3/4" Iron Pipe Found
- ● = 3/4" Iron Rod Found
- ○ = 3/4" x 24" Iron Pipe Set
- ✖ = 1¼" Iron Pipe Found
- ▫ = Stone Pillar

Bearings referenced to the West line of Outlot 63 with the previously assumed bearing of N1°00'00"E

Survey ordered for:
Dean L. Buntrock
3003 Butterfield Road
Oak Brook, IL 60521

STATE OF WISCONSIN)
COUNTY OF WALWORTH) SS

I, George T. Dunham, Surveyor, certify that I have surveyed the property described as follows:

A parcel of land located in the North ½ of Section 13, T 1 N, R 16 E, Village of Fontana-on-Geneva Lake, Walworth County, Wisconsin, described as follows: Beginning at a point on the East and West ¼ section line of said section, 2257.23 feet West of the East ¼ section corner of said section, said point also being the southwest corner of premises conveyed to Wallace H. Hastings et ux by deed dated August 7, 1968 and recorded August 8, 1968 in Volume 665 of Deeds at page 544 as Document No. 605093; thence N1°00'00"E 711 feet more or less to the shore of Geneva Lake; thence Westerly along the shore of said lake to a point 119.97 feet from the last described line, measured at right angles; thence S1°00'00"W 710 feet more or less to the East and West ¼ section line of said section; thence East along said East and West ¼ section line 119.97 feet more or less to the place of beginning.

and that the map shown hereon is a true representation thereof and shows the size and location of the property, its exterior boundaries, the location of all visible structures and dimensions of all principal buildings thereon, boundary fences, apparent easements, roadways and visible encroachments, if any, and that I have surveyed the property hereon described according to the official records, to the best of my knowledge and belief.

September 15, 1983
Revised June 25, 1984

George T. Dunham, Surveyor

WISCONSIN
GEORGE T. DUNHAM
DELAVAN, WIS.
S-306
LAND SURVEYOR

K & E 10-9135

ST FV-92

5-615-DV