
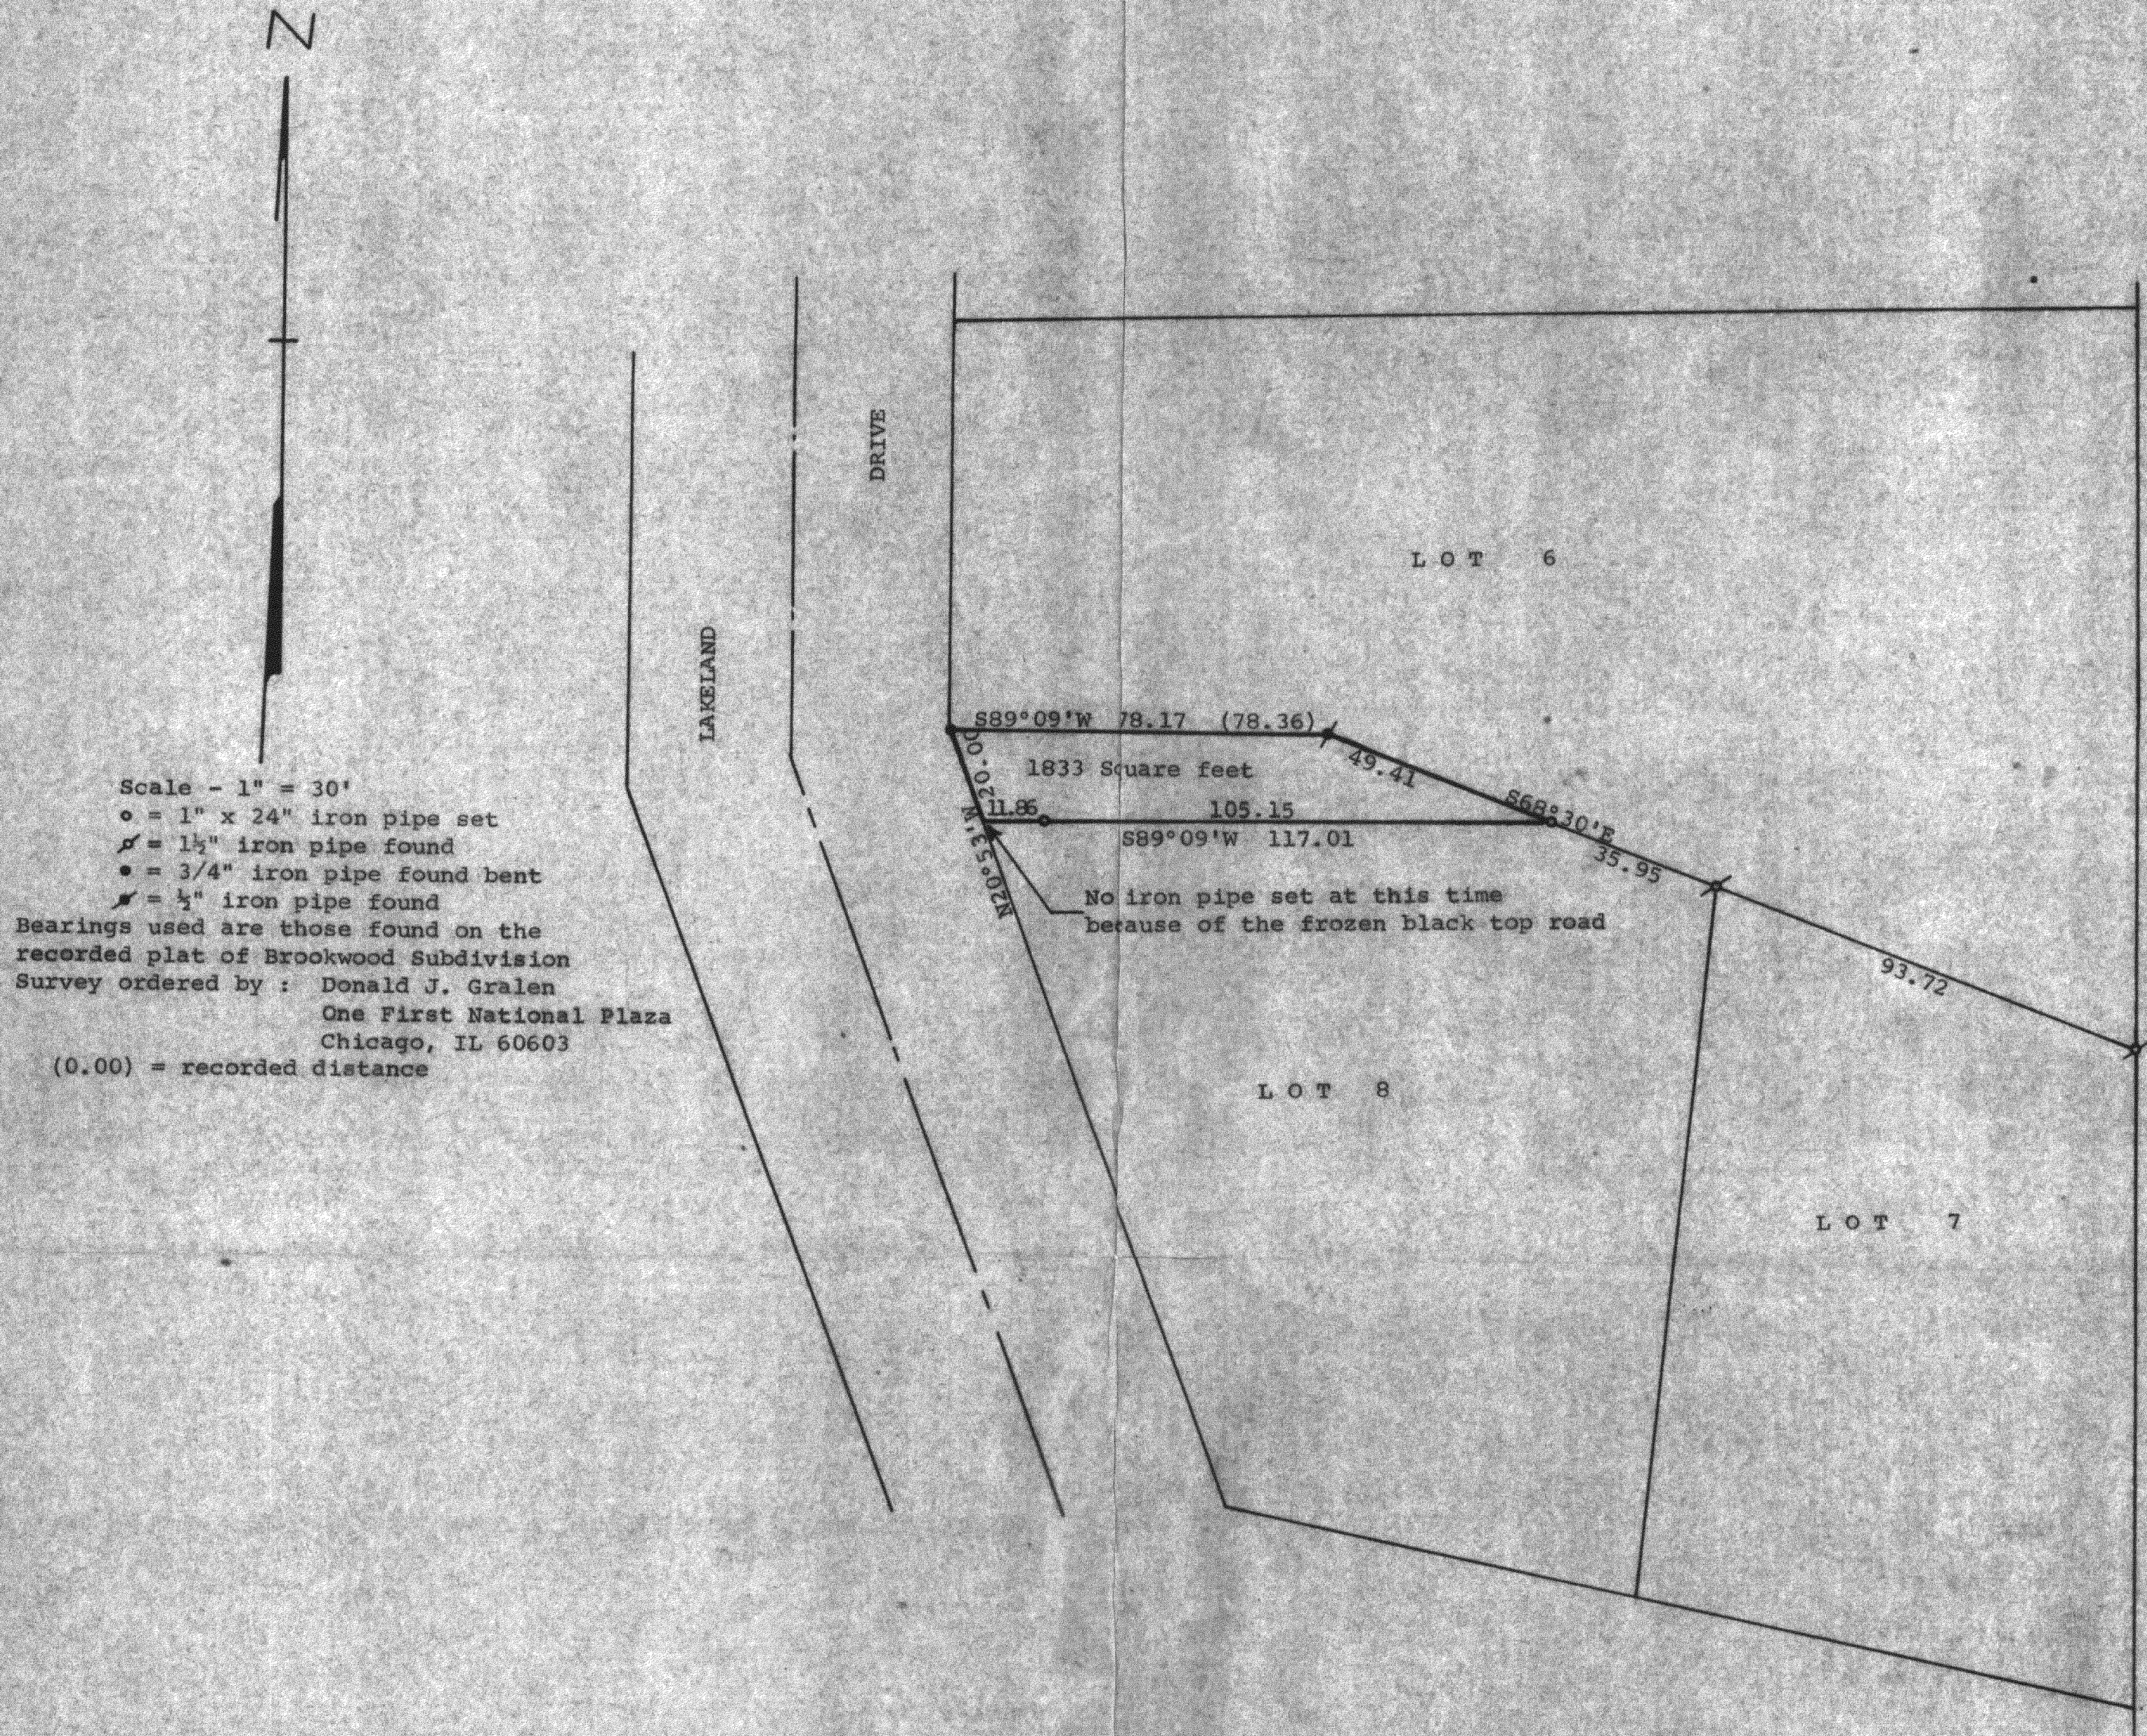


DUNHAM SURVEYING, S.C.
SURVEYING & SUBDIVIDING
DELAVER, WISCONSIN 53115

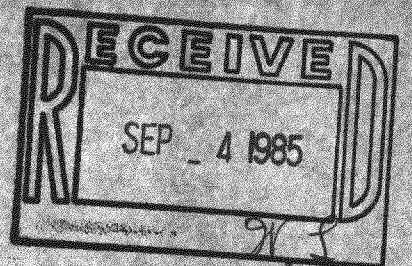

STATE OF WISCONSIN)
COUNTY OF WALWORTH)

I, George T. Dunham, Surveyor, certify that I have surveyed the property described as follows:

A part of Lot 8, Block 2 of Brookwood Subdivision, located in the Village of Fontana-on-Geneva Lake, Walworth County, Wisconsin, described as follows: Beginning at the northwest corner of said Lot 8; thence N89°09'E along the north line of said Lot 8, 78.17 feet (recorded as 78.36 feet) thence S68°30'E along the northerly line of said Lot 8, 49.41 feet; thence S89°09'W 117.01 feet to the westerly line of said Lot 8; thence N20°53'W along said westerly line 20.00 feet to the place of beginning containing 1833 square feet of land, (Said description is prepared for a lot line adjustment and not for creating a new parcel of land)

and that the map shown above is a correct representation thereof and shows the size and location of the property, its exterior boundaries, the location of all visible structures and dimensions of all principal buildings thereon, boundary fences, apparent easements, roadways and visible encroachments, if any, and that I have surveyed the property hereon described according to the official records to the best of my knowledge and belief.
February 5, 1985

George T. Dunham
George T. Dunham, Surveyor

