RECEIVED
SEP 30 1985


HAROLD H. KOLB

REGISTERED PROFESSIONAL LAND SURVEYOR
LAKE GENEVA, WISCONSIN

ORDERED BY:

BOB KEEFE & ASSOCIATES

REVISION ORDERED BY:
FIRST BANK SOUTHEAST
303 CENTER STREET
LAKE GENEVA, WI.
53147

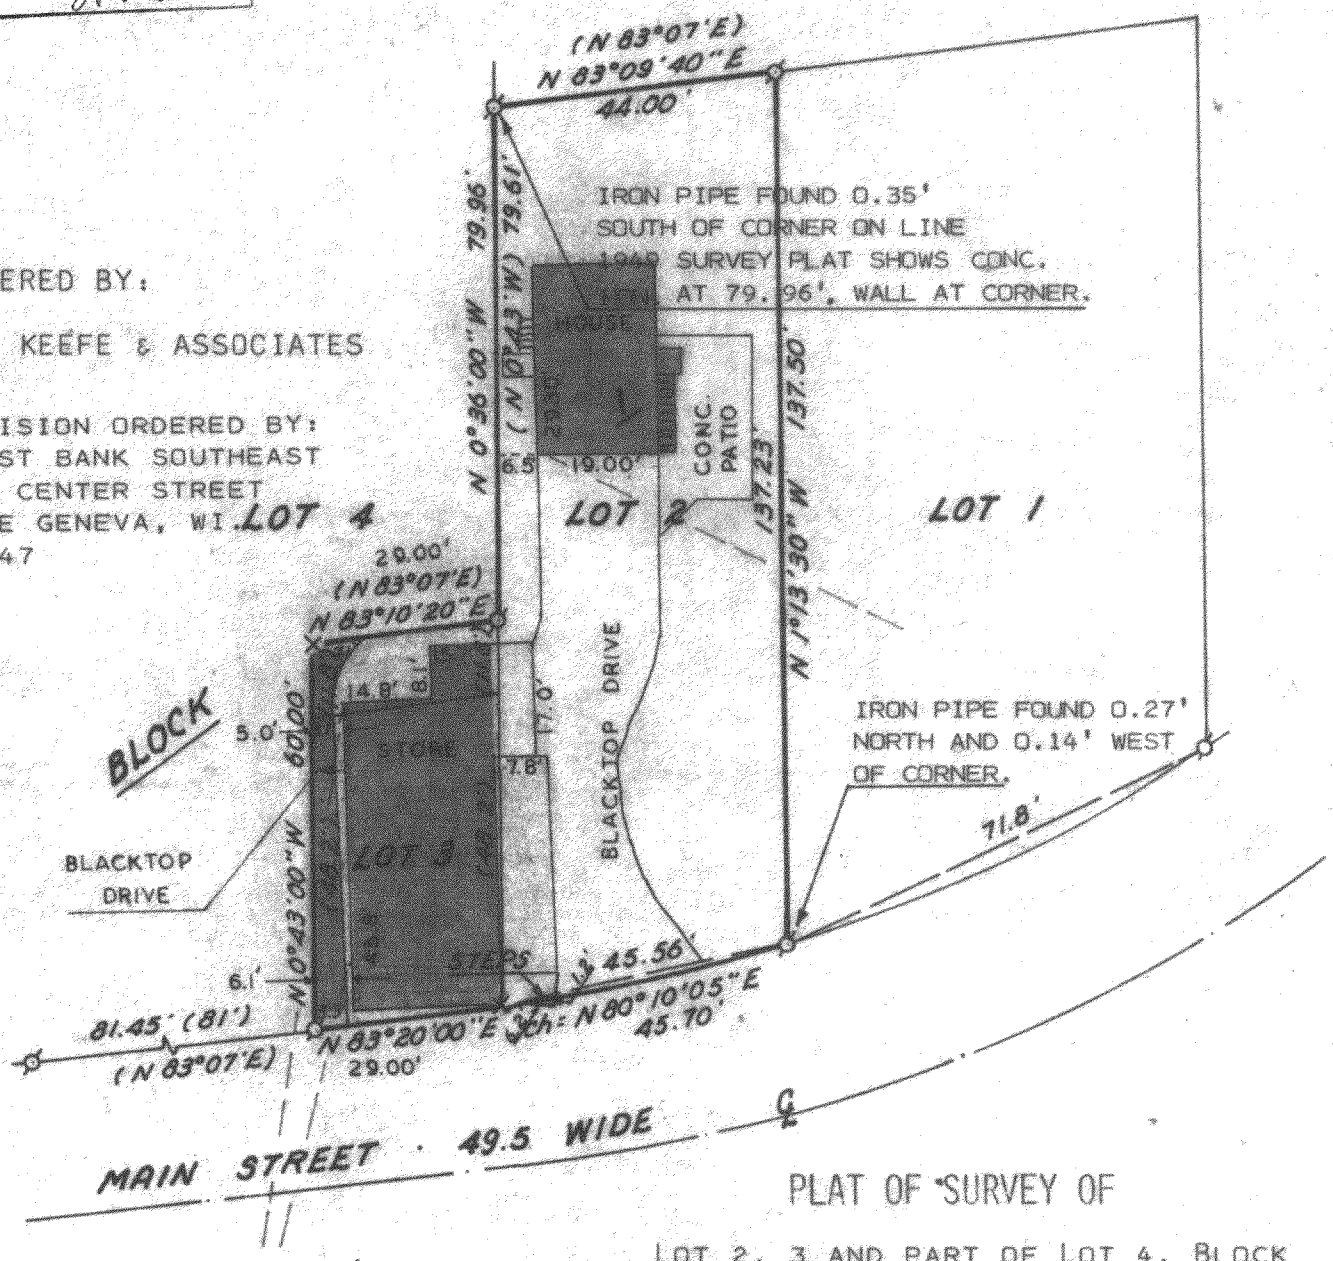

PLAT OF SURVEY OF

LOT 2, 3 AND PART OF LOT 4, BLOCK 1, C. L. DOUGLAS SUBDIVISION, VILLAGE OF FONTANA-ON-GENEVA LAKE, WALWORTH COUNTY, WISCONSIN.

NOTE: THE WEST LINE OF LOT 3 IS ASSUMED N 0°43' W AS SHOWN ON EXISTING RECORDS.

ACCURACY: DISTANCES ± 0.01'
ANGLES ± 05"
ERROR OF CLOSURE--LESS THAN ONE PART IN 3000

WISCONSIN
HAROLD H. KOLB
S-187
LAKE GENEVA, WIS.
LAND SURVEYOR

I, HAROLD H. KOLB, DO HEREBY CERTIFY THAT I HAVE SURVEYED THE PROPERTY HEREON DESCRIBED ACCORDING TO THE OFFICIAL RECORDS AND THAT THE PLAT HEREON IS A CORRECT REPRESENTATION OF THE LOT LINES.

N

SCALE: 1"=30'

Harold H. Kolb
HAROLD H. KOLB
WISCONSIN REGISTERED LAND SURVEYOR, S-187
DATE Dec. 29, 1976

REVISED: MAY 21, 1985

LEGEND

O — IRON PIPE PLACED ()-AS RECORDED
● — CONCRETE MONUMENT X-RAILROAD SPIKE
ø — IRON PIPE FOUND — — — OVER HEAD UTILITY LINE

5-628-K

BRUNING 40-105 1M-6-71 STFV-00174 ODINSKI FON-192