
GEORGE T. DUNHAM

SURVEYING & SUBDIVIDING

DELAVAN, WISCONSIN

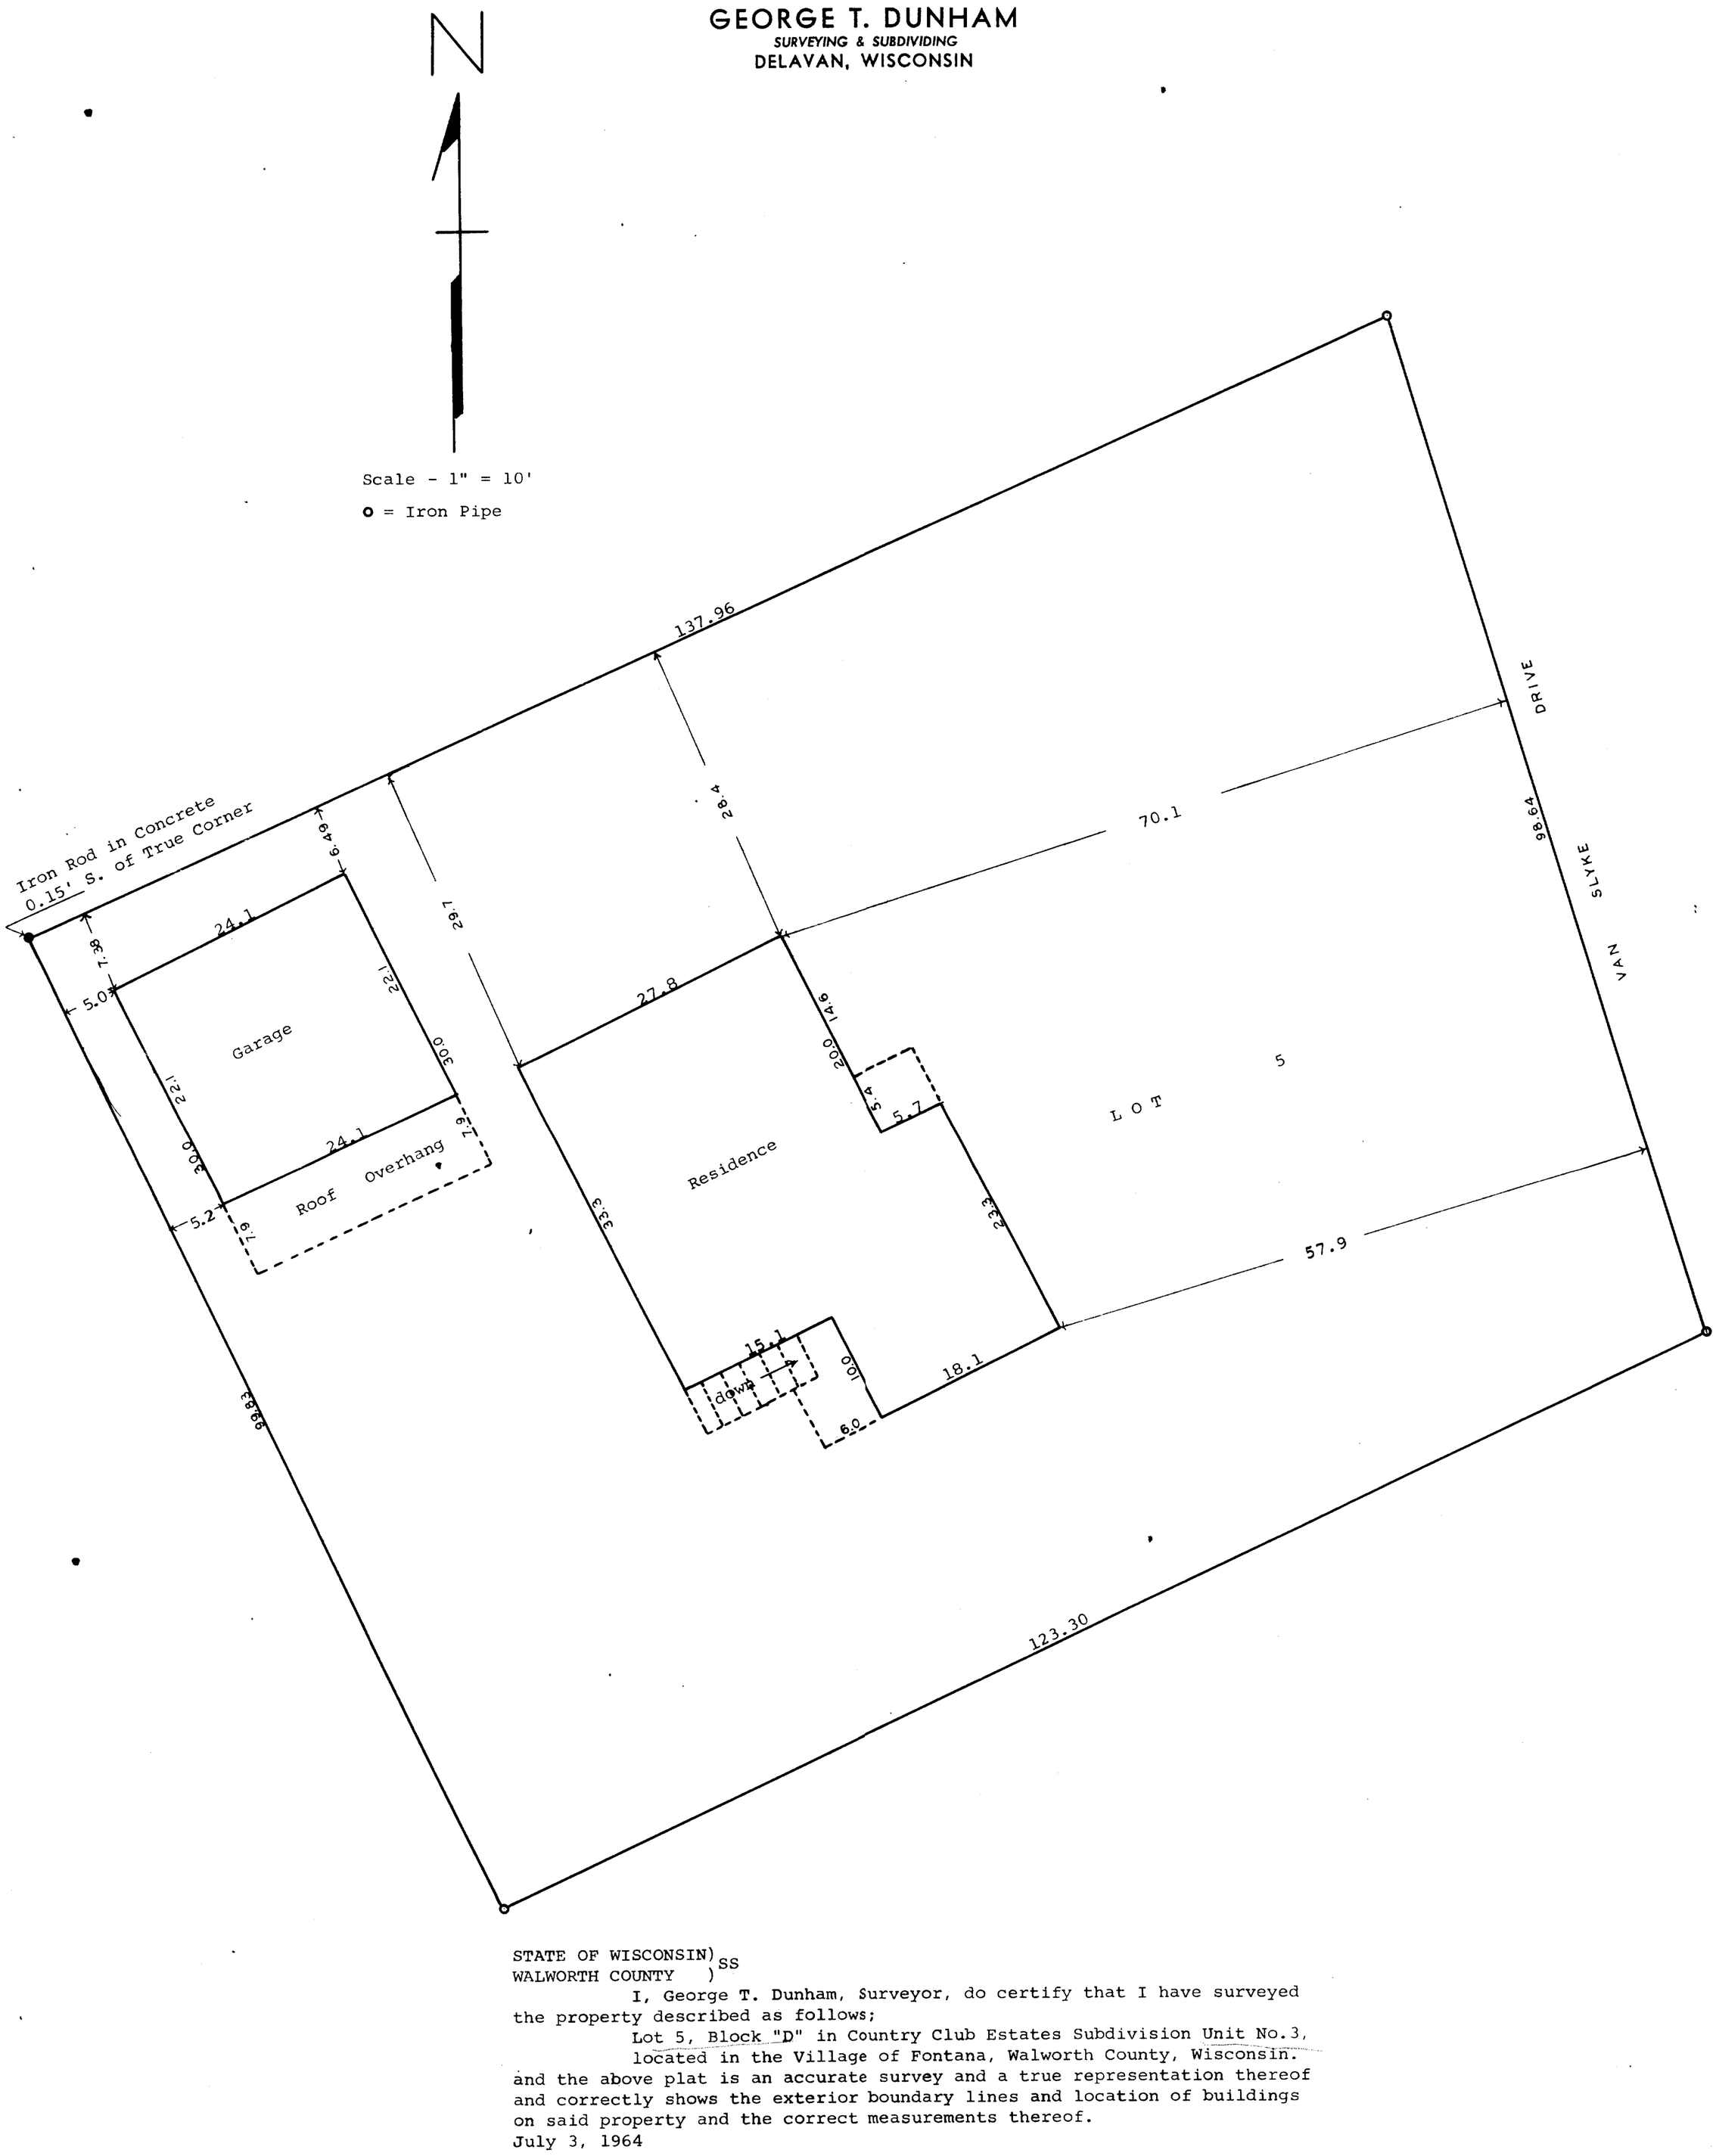

STATE OF WISCONSIN)
WALWORTH COUNTY) SS

I, George T. Dunham, Surveyor, do certify that I have surveyed the property described as follows;

Lot 5, Block "D" in Country Club Estates Subdivision Unit No.3, located in the Village of Fontana, Walworth County, Wisconsin.

and the above plat is an accurate survey and a true representation thereof and correctly shows the exterior boundary lines and location of buildings on said property and the correct measurements thereof.

July 3, 1964

George T. Dunham

George T. Dunham, Surveyor

SC03-57

K & E—195L 250-6-62

5-63