
RECEIVED
SEP 30 1985

KOLB LAND CONSULTING, INC.

LAND SURVEYING · SUBDIVIDING · LAND PLANNING

929 WILLIAMS STREET LAKE GENEVA, WISCONSIN 53147 414-248-3697

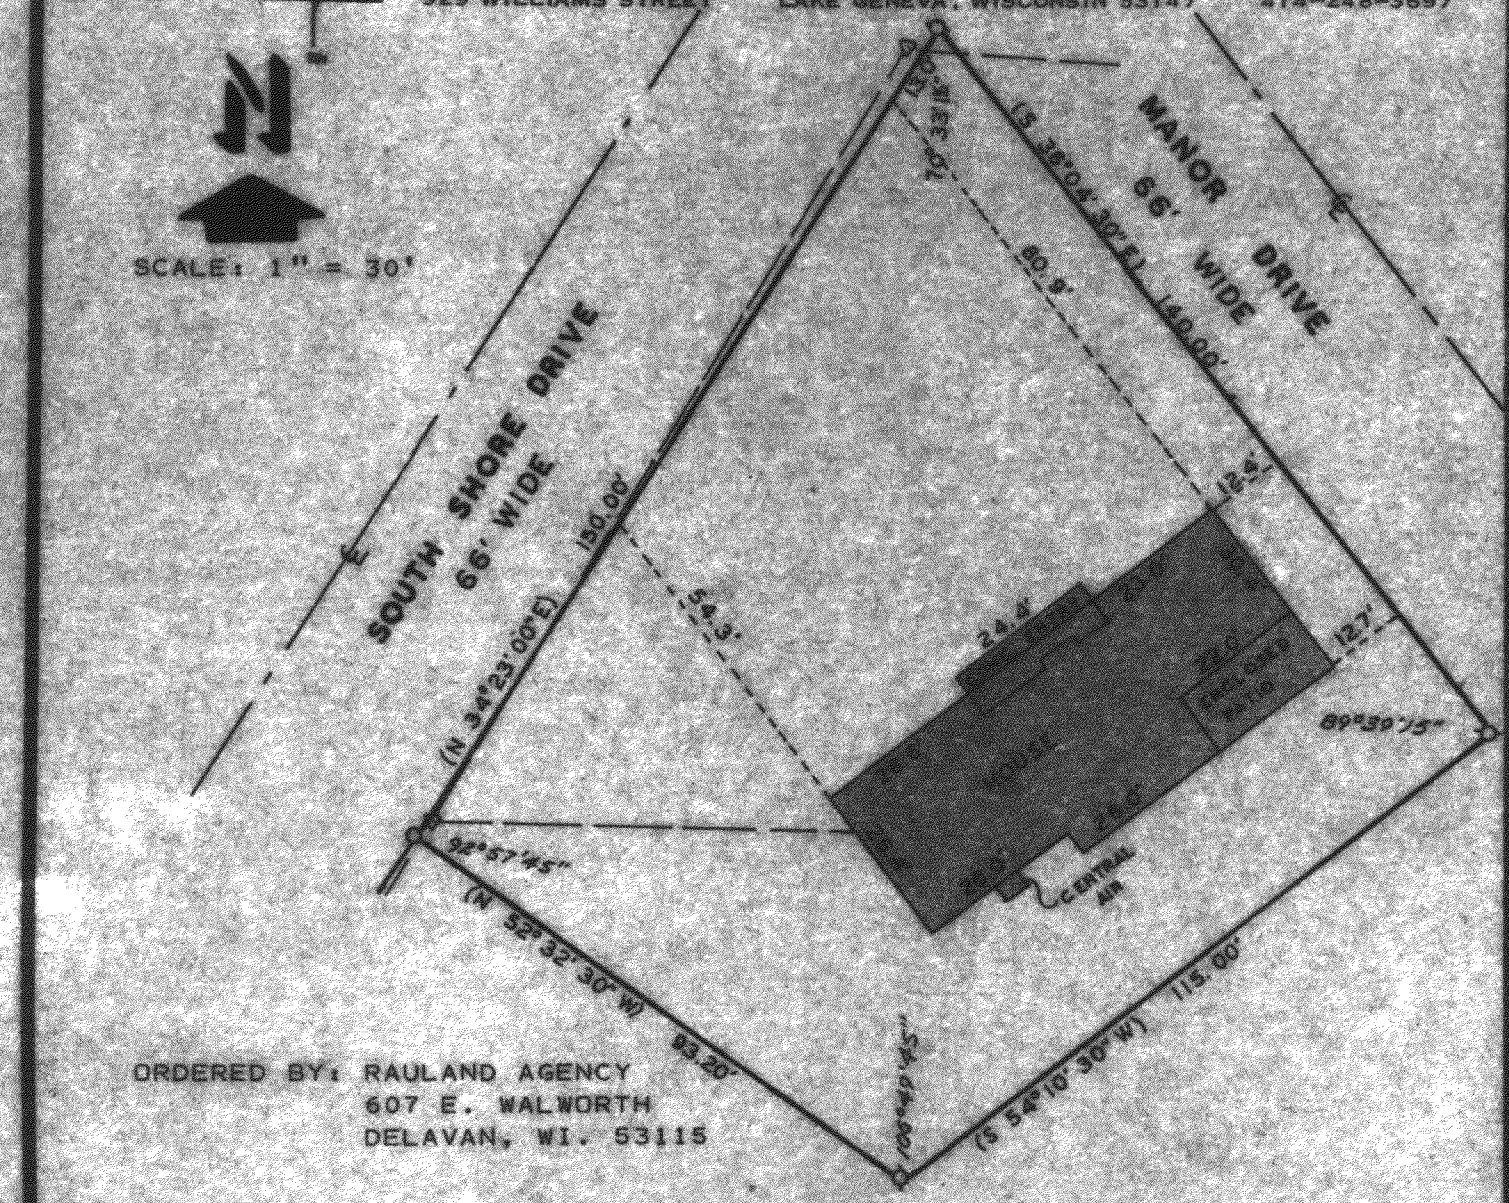

ORDERED BY: RAULAND AGENCY
607 E. WALWORTH
DELAVAN, WI. 53115

PLAT OF SURVEY OF

A PARCEL OF LAND LOCATED IN THE SW 1/4, SECTION 13, T1N, R16E, VILLAGE OF FONTANA, WALWORTH COUNTY, WISCONSIN.
TAX PARCEL: STFV 1228

LEGEND
o IRON PIPE FOUND
o 1" X24" IRON PIPE SET
Δ UTILITY POLE
——OVERHEAD UTILITY LINES
(4) AS RECORDED

NOTE: BEARINGS ARE ASSUMED AS RECORDED.

WISCONSIN
HAROLD H. KOLB
S-187
LAKE GENEVA, WIS.
LAND SURVEYOR

I HEREBY CERTIFY THAT I HAVE SURVEYED THE ABOVE DESCRIBED PROPERTY AND THAT THE ABOVE MAP IS A TRUE REPRESENTATION THEREOF AND SHOWS THE SIZE AND LOCATION OF THE PROPERTY ITS EXTERIOR BOUNDARIES, THE LOCATION OF ALL VISIBLE STRUCTURES AND DIMENSIONS OF ALL PRINCIPAL BUILDINGS THEREON, BOUNDARY FENCES, APPARENT EASEMENTS, ROADWAYS AND VISIBLE ENCROACHMENTS, IF ANY TO THE BEST OF MY KNOWLEDGE AND BELIEF.
THIS SURVEY IS MADE FOR THE USE OF THE PRESENT OWNERS OF THE PROPERTY, AND ALSO THOSE WHO PURCHASE, MORTGAGE, OR GUARANTEE THE TITLE THERETO WITHIN ONE (1) YEAR FROM DATE HEREOF.

Harold H. Kolb
HAROLD H. KOLB

WISCONSIN REGISTERED LAND SURVEYOR, S-187

DATE JUNE 24, 1985

REVISED

REVISED

FV-122-B

F-130 5-632-K