
ROBERS & BOYD, INC.
CONSULTING ENGINEERS
LAND SURVEYORS

109 SOUTH SPRING STREET
BURLINGTON, WISCONSIN 53105
PHONE: 414-763-7834

PLAT OF SURVEY
FOR
WENDY O'KANE
OF

Lot 7, Block 2 of Assessor's Plat #1, C.L. Douglas Addition, Village of Fontana-on-Geneva Lake, Wisconsin.

RECEIVED
JAN 23 1986

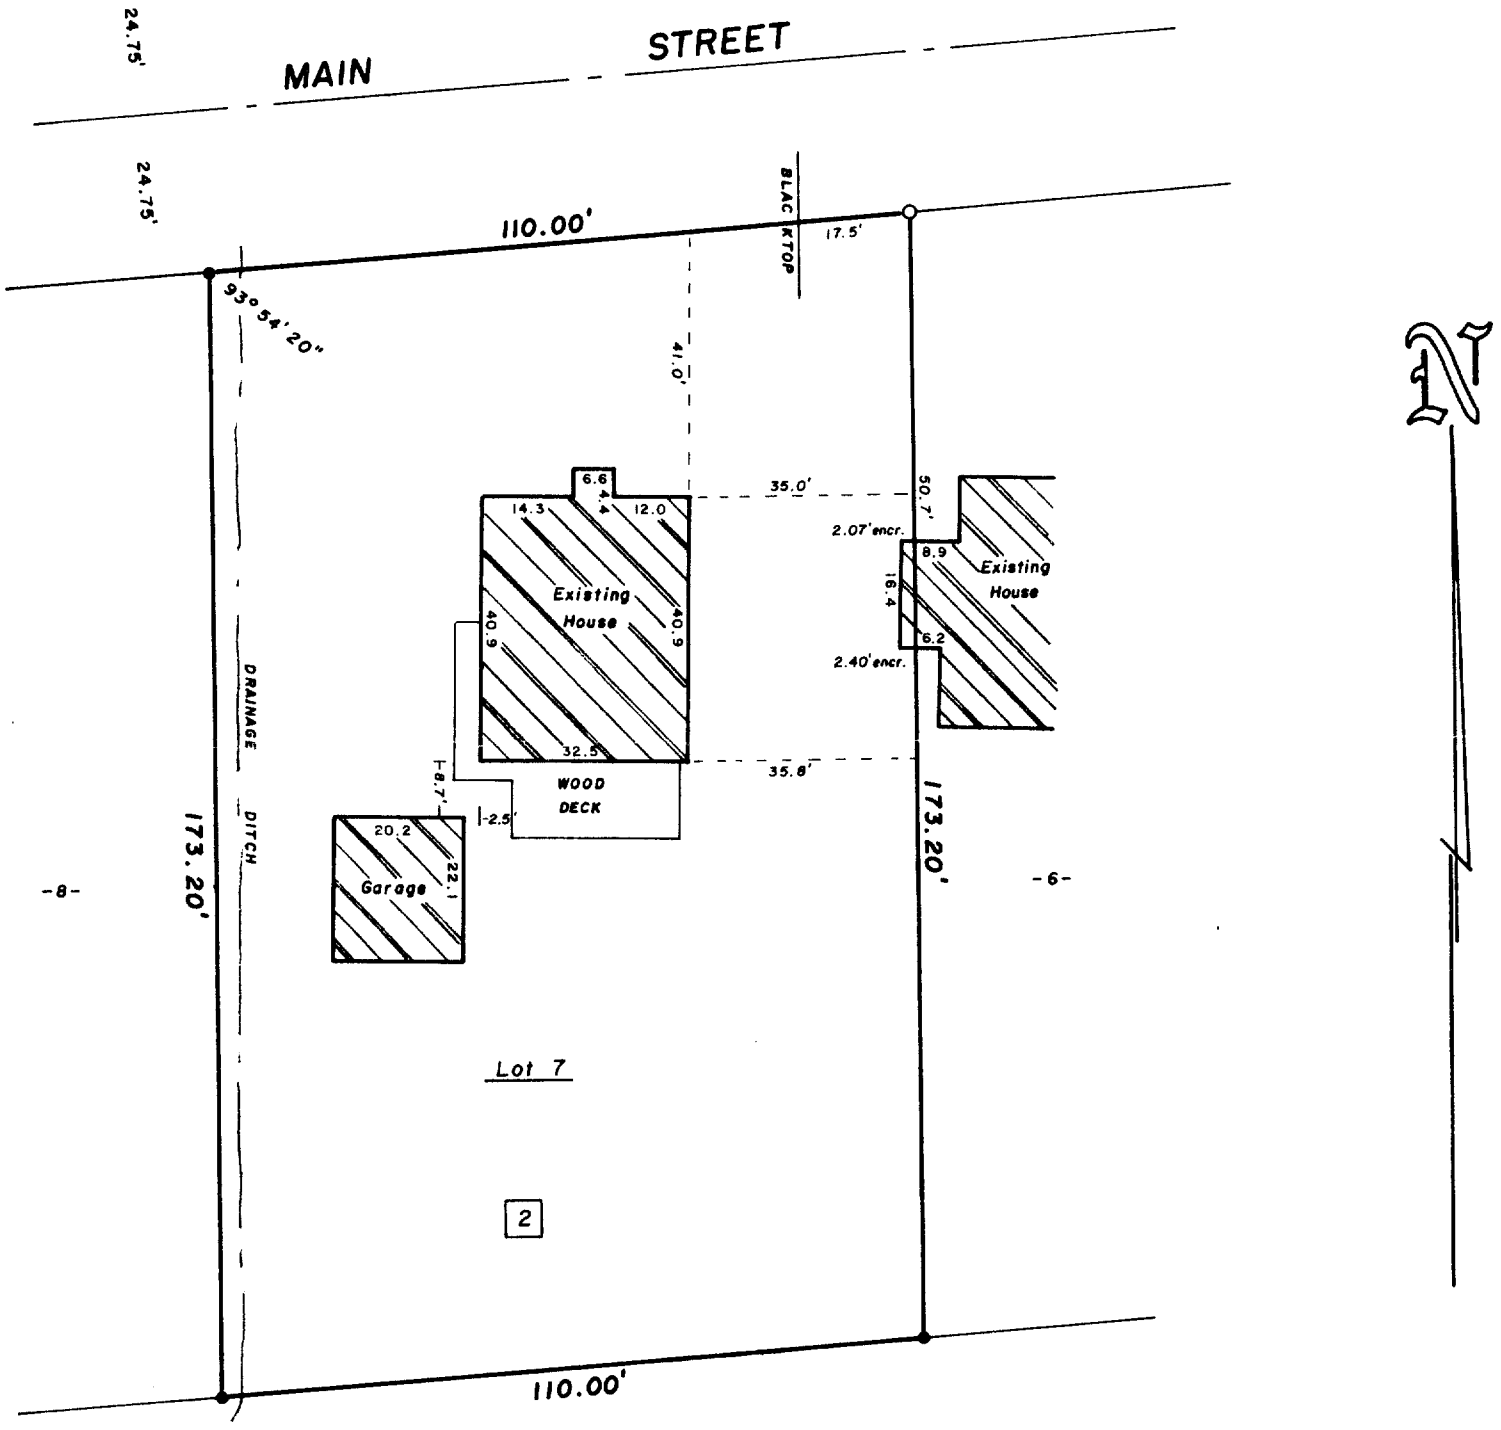

"I hereby certify that I have surveyed the above described property and that the above map is a true representation thereof and shows the size and location of the property, its exterior boundaries, the location of all visible structures and dimensions of all principal buildings thereon, boundary fences, apparent easements, roadways and visible encroachments, if any.

"This survey is made for the use of the present owners of the property, and also those who purchase, mortgage, or guarantee the title thereto within one year from date hereof."

NO MONUMENTATION HAS BEEN WAIVED IN ACCORDANCE WITH A-E 5.01(b) OF THE WISCONSIN ADMINISTRATIVE CODE.

WISCONSIN
GEORGE J. APPEL
S-1612
DELAVAN, WI
LAND SURVEYOR

LEGEND

+	CHISEL CUT IN CONCRETE
∘	PK NAIL
●	FOUND IRON PIPE - 1-1/4"
◪	FOUND IRON PIPE -
○	SET IRON PIPE - 1"
⬤	FOUND BRASS CAPPED MONUMENT
⊕	FOUND CONCRETE MONUMENT
—x—x—	FENCE
( )	RECORDED AS
/	EXISTING GROUND ELEVATION

SCALE - 1" = 30'

George J. Appel
WISCONSIN REGISTERED LAND SURVEYOR

12-9-85
DATE

FIELD WORK BY GJA, RLA

DRAWN BY GJA

85226
JOB NUMBER

K&E STFV-00190

5-632-R

RD