
WALWORTH COUNTY
SURVEYING & MAPPING
LAKE GENEVA, WISCONSIN

RECEIVED
JUL 11 1986

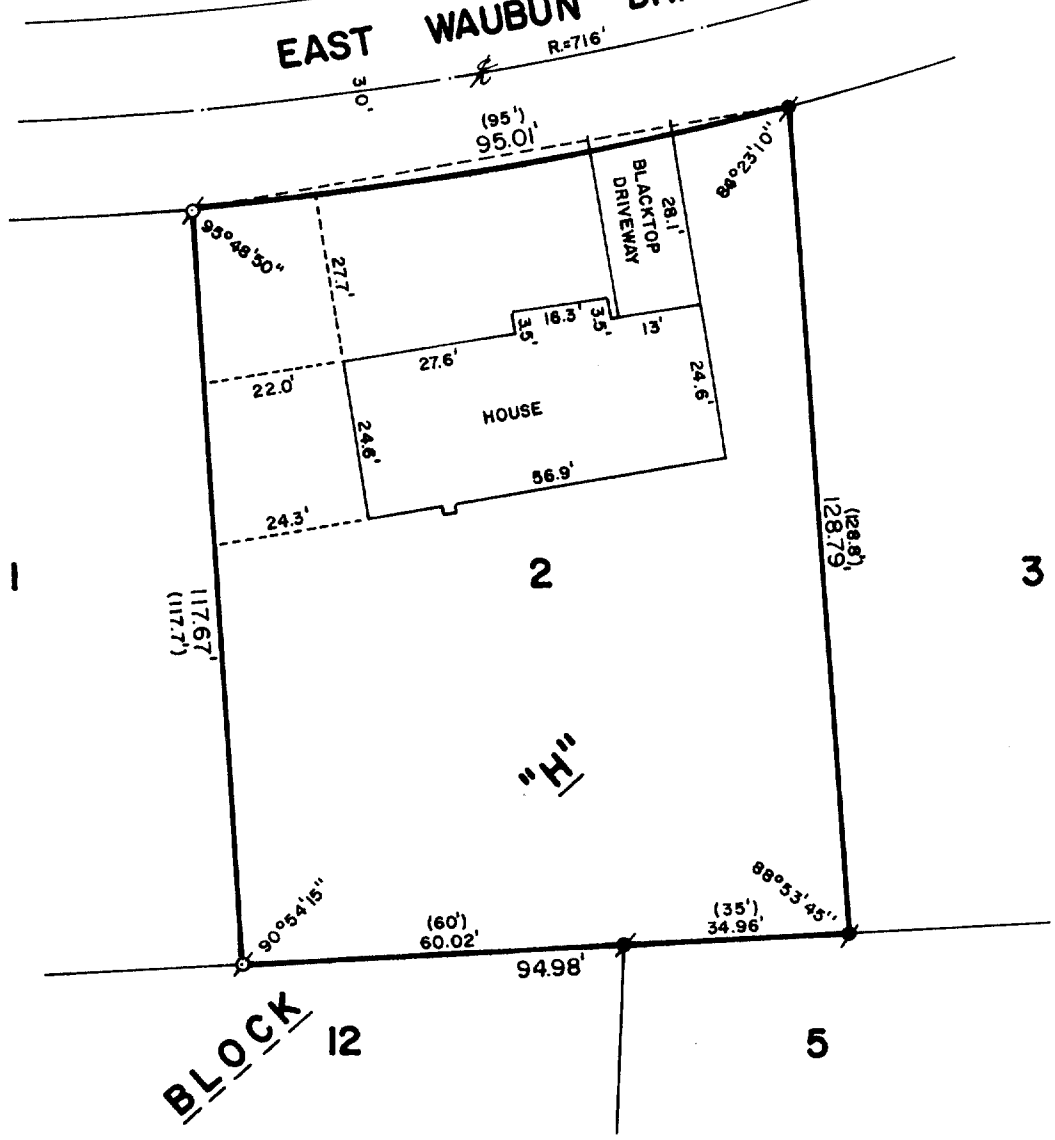

WISCONSIN
ROBERT M. BAERENWALD
Lake Geneva, WI.
S-1508
LAND SURVEYOR

PLAT OF SURVEY OF

LOT 2, BLOCK "H" OF COUNTRY CLUB ESTATES UNIT NO. 3, LOCATED IN THE VILLAGE OF FONTANA-ON-GENEVA LAKE, WALWORTH COUNTY, WISCONSIN.

ORDERED BY: LAKELAND REALTY
P. O. BOX 323
FONTANA, WISCONSIN 53125

SCALE: 1"=30'

ø-IRON PIPE FOUND
●-CONCRETE MONUMENT FOUND
()-RECORDED AS

I, ROBERT M. BAERENWALD, DO HEREBY CERTIFY THAT I HAVE SURVEYED THE PROPERTY HEREON DESCRIBED ACCORDING TO THE OFFICIAL RECORDS AND THAT THE PLAT HEREON IS A CORRECT REPRESENTATION OF THE PROPERTY LINES TO THE BEST OF MY KNOWLEDGE AND BELIEF.

Robert M. Baerenwald
ROBERT M. BAERENWALD
WISCONSIN REGISTERED LAND SURVEYOR, S-1508

June 4, 1986
DATE JOB NO. 0543

SC03-00119

5-634-B