
WALWORTH COUNTY
SURVEYING & MAPPING
LAKE GENEVA, WISCONSIN

RECEIVED
JUL 11 1986

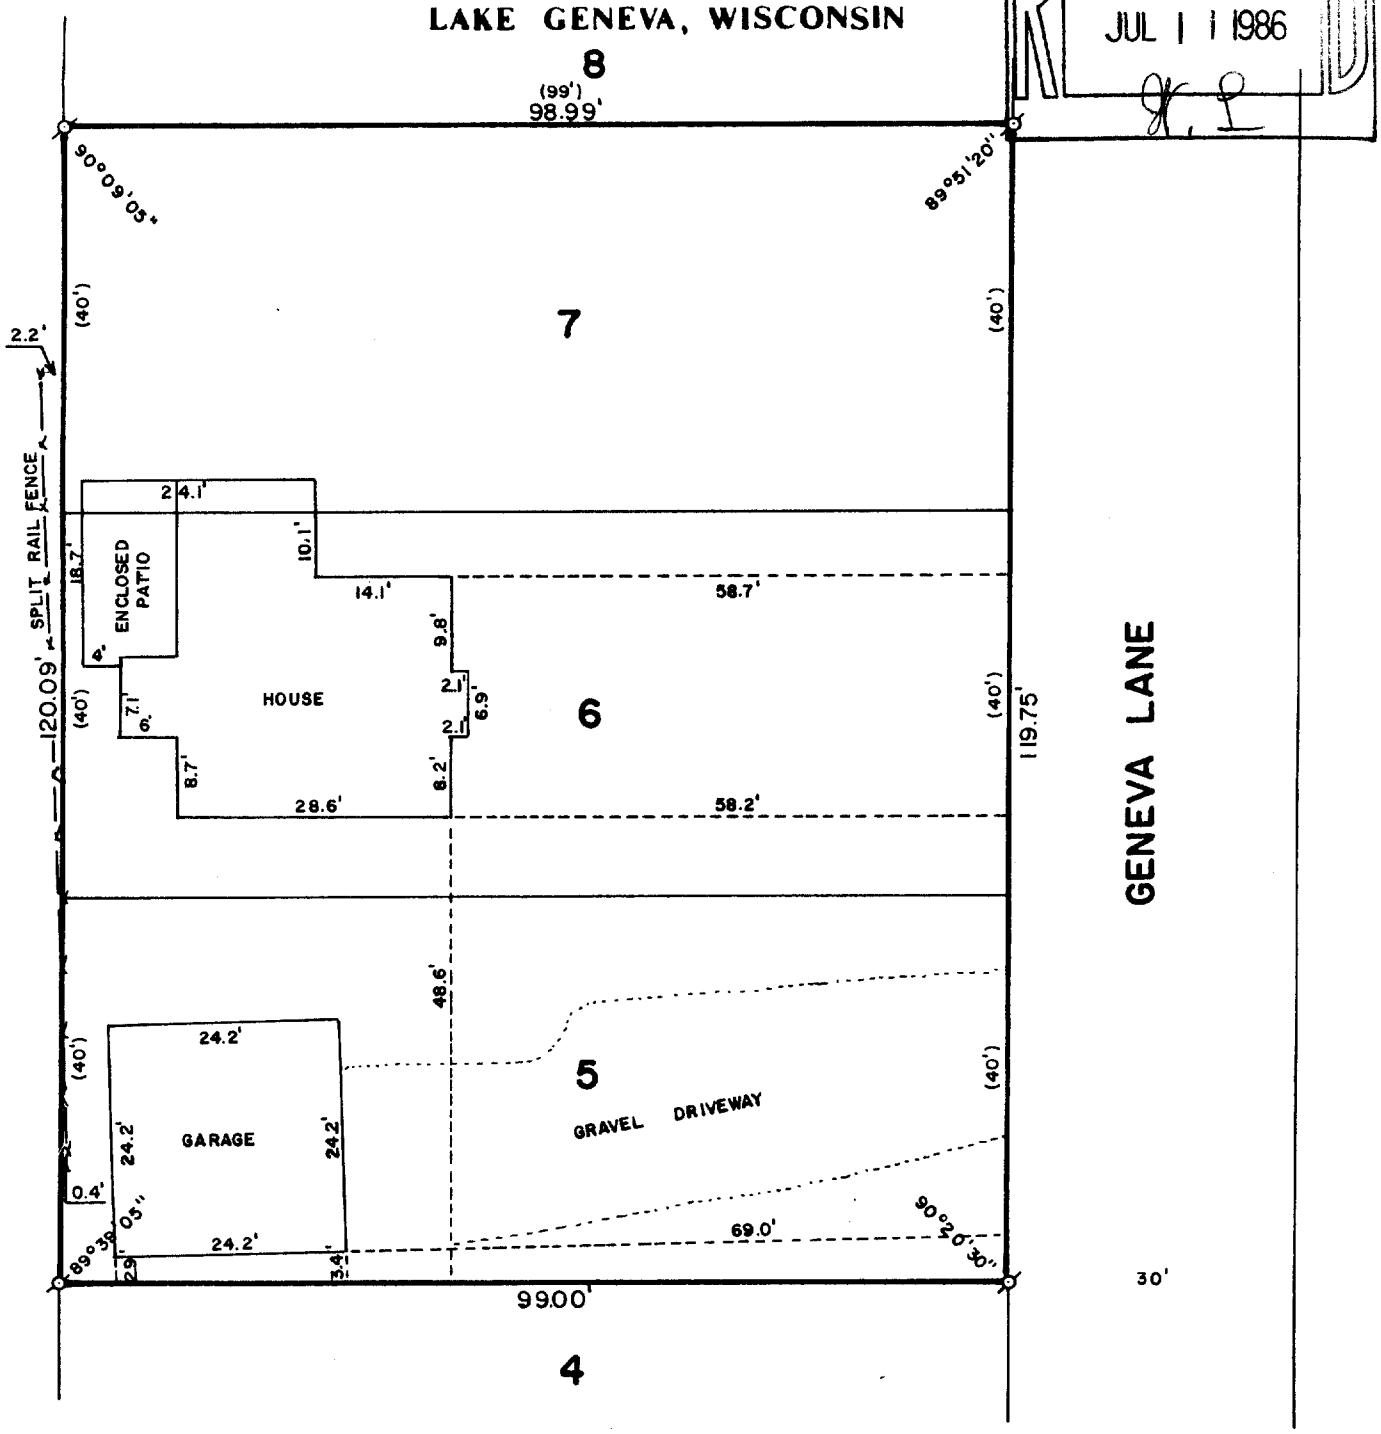

WISCONSIN
ROBERT M. BAERENWALD
Lake Geneva, WI.
S-1508
LAND SURVEYOR

PLAT OF SURVEY OF

LOTS 5, 6 AND 7 OF GENEVA LANE, A SUB-DIVISION LOCATED IN SECTION 14, T 1 N, R 16 E, VILLAGE OF FONTANA-ON-GENEVA LAKE, WALWORTH COUNTY, WISCONSIN.

ORDERED BY: KENOSHA SAVINGS & LOAN
410 BROAD STREET
LAKE GENEVA, WISCONSIN 53147

SCALE: 1"=20'

ø -IRON PIPE FOUND
() -RECORDED AS

I, ROBERT M. BAERENWALD, DO HEREBY CERTIFY THAT I HAVE SURVEYED THE PROPERTY HEREON DESCRIBED ACCORDING TO THE OFFICIAL RECORDS AND THAT THE PLAT HEREON IS A CORRECT REPRESENTATION OF THE PROPERTY LINES TO THE BEST OF MY KNOWLEDGE AND BELIEF.

Robert M. Baerenwald
ROBERT M. BAERENWALD
WISCONSIN REGISTERED LAND SURVEYOR, S-1508

June 4, 1986
DATE JOB NO. 0577

SSP 00003

5-635-B