
DUNHAM SURVEYING, S.C.
SURVEYING & SUBDIVIDING
DELAVAN, WISCONSIN 53115

RECEIVED
MAY 5 1986

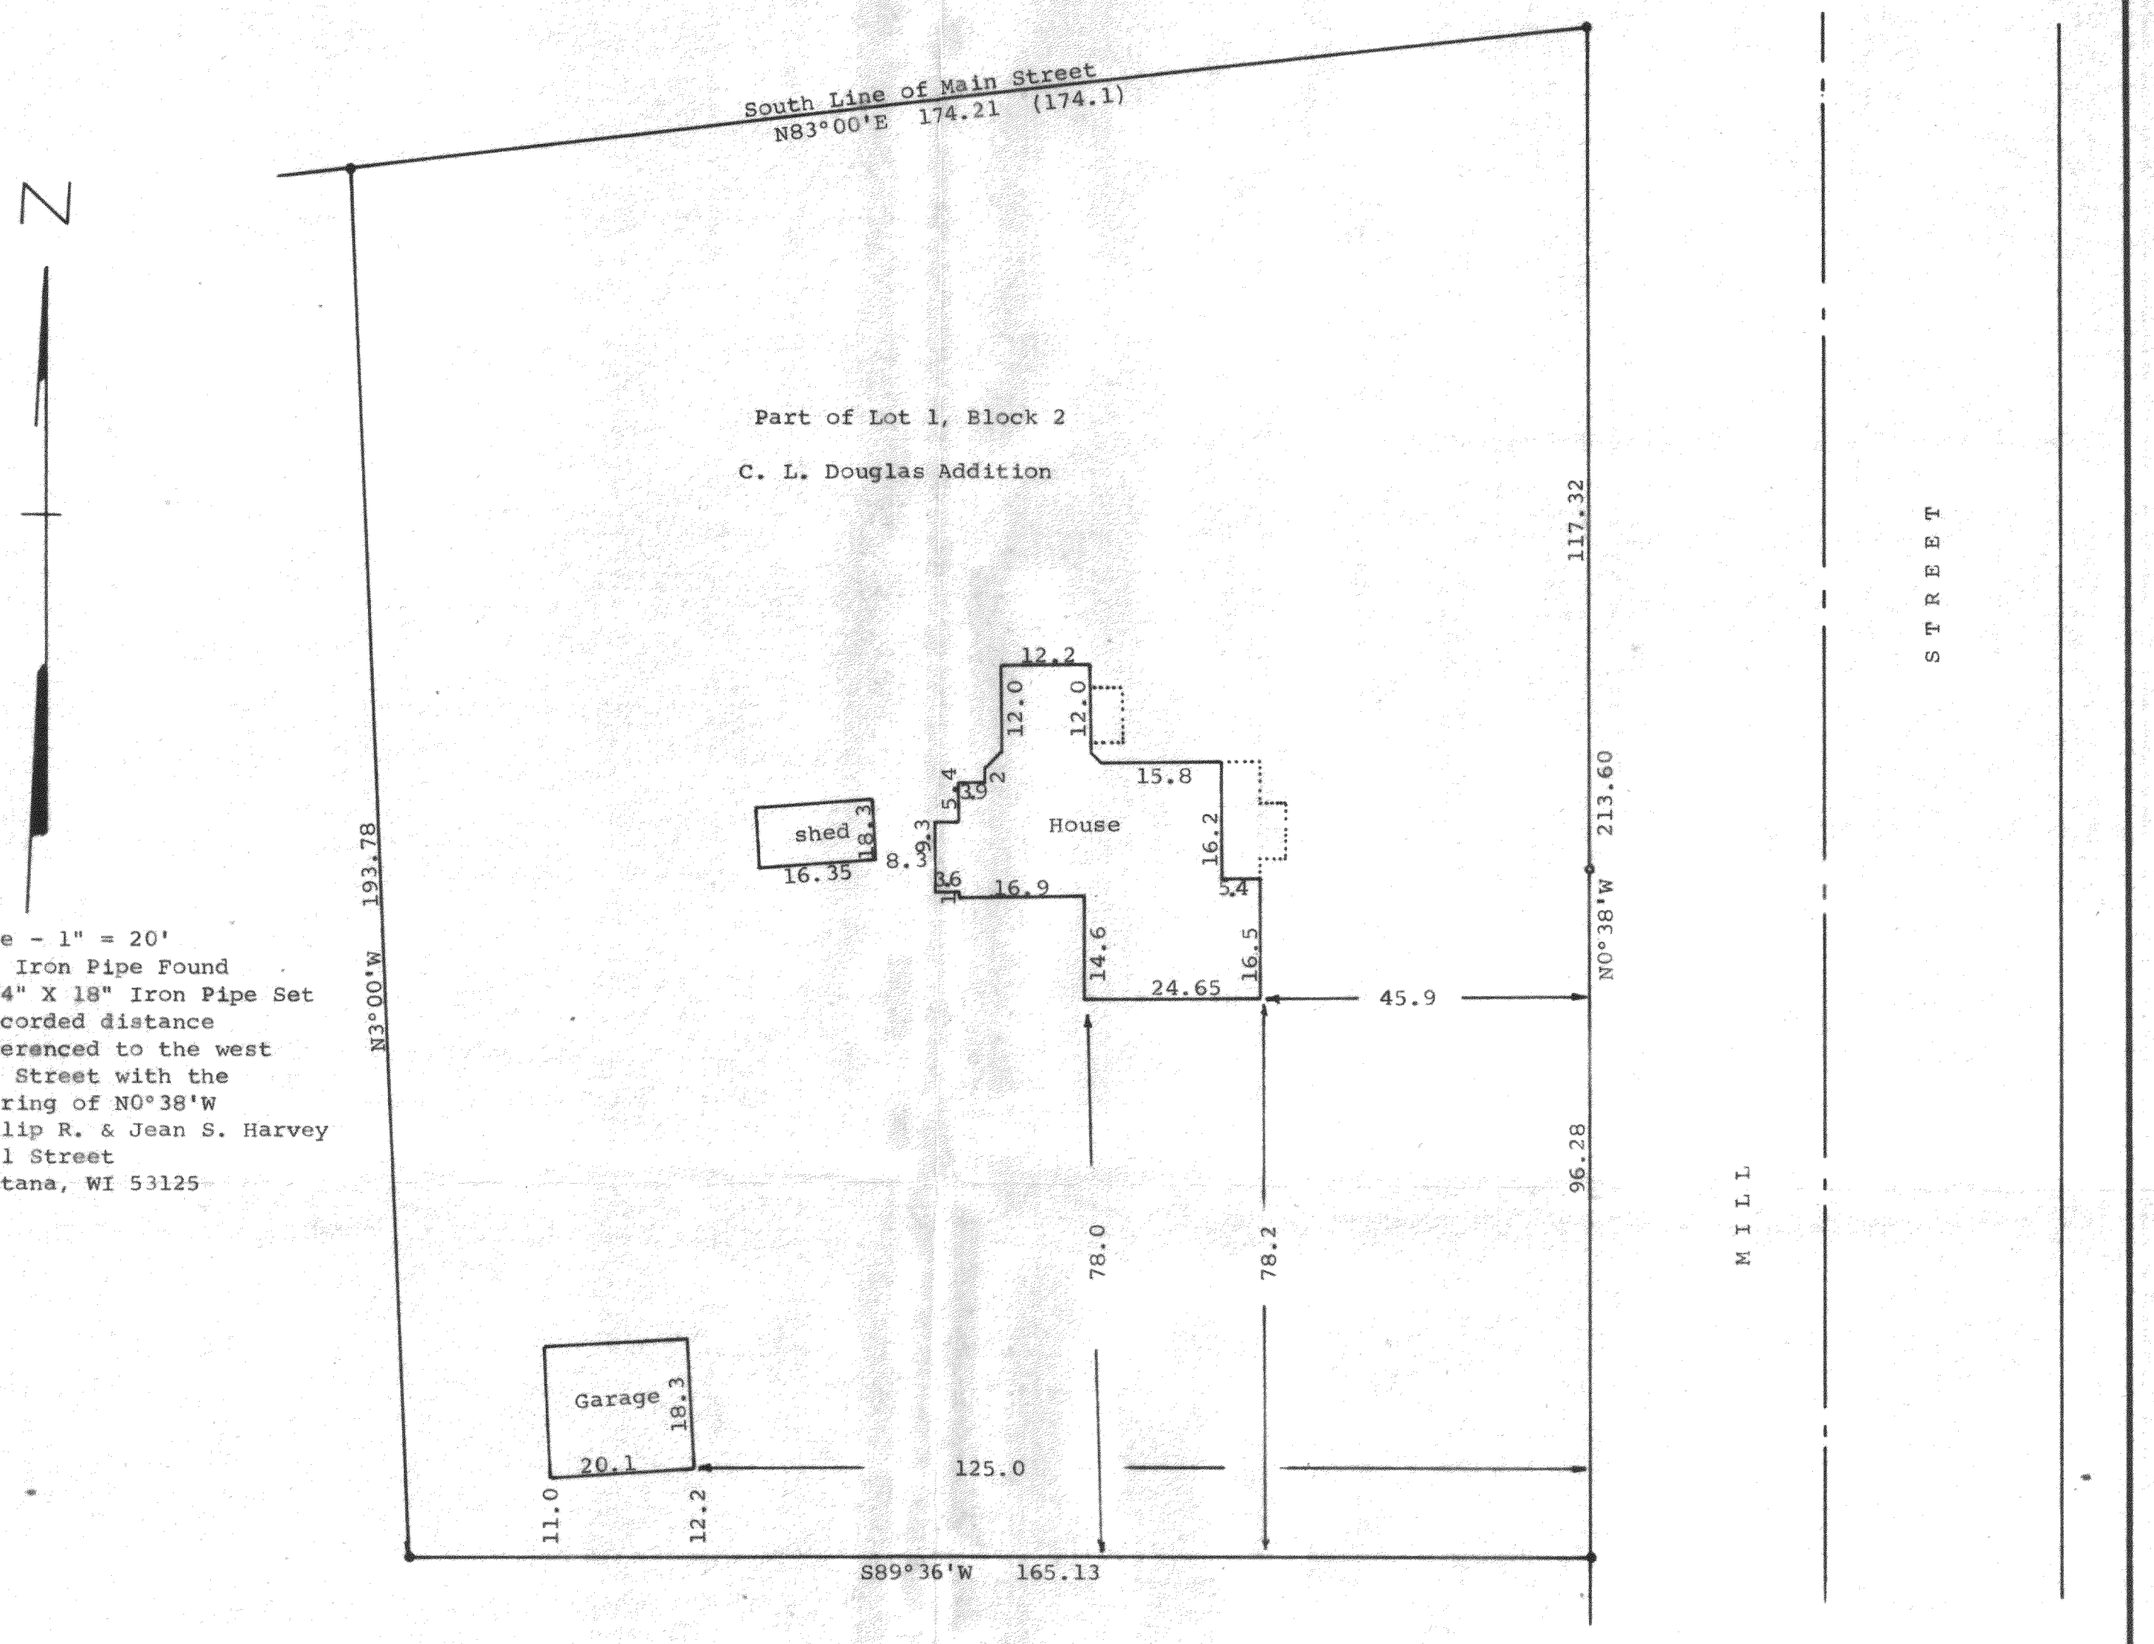

scale - 1" = 20'
● = 1" Iron Pipe Found
○ = 3/4" X 18" Iron Pipe Set
(0.00) = recorded distance
Bearings referenced to the west line of Mill Street with the recorded bearing of N0°38'W
Owners: Philip R. & Jean S. Harvey
Mill Street
Fontana, WI 53125

STATE OF WISCONSIN)
COUNTY OF WALWORTH) SS

I, George T. Dunham, Surveyor, certify that I have surveyed the property described as follows:

Lot 1, Block 2 of C. L. Douglas Subdivision, Village of Fontana, Walworth County, Wisconsin, Excepting therefrom the following described land: An area of Lot 1, Block 2, Assessor's Plat No. 1, C. L. Douglas Addition to the Village of Fontana, Walworth County, Wisconsin, described as follows: Beginning at the southeast corner of Lot 1, Block 2 Assessor's Plat No. 1, C. L. Douglas Addition to the Village of Fontana, Walworth County, Wisconsin, thence running to the north, 100 feet, along the easterly border of said lot; thence running directly west to the western border of said lot; thence running to the south along the western border of said lot, to the southwest corner of the lot; thence running to the east along the southern border of said lot to the place of beginning. (Above description is taken from the deed from Foerster to Harvey in Volume 338, Page 435, Walworth County Records.)

and that the above map is a true representation thereof and shows the size and location of the property, its exterior boundaries, the location of all visible structures and dimensions of all principal buildings thereon, boundary fences, apparent easements, roadways and visible encroachments, if any, and I have surveyed the property hereon described according to the official records, to the best of my knowledge and belief.

October 15, 1985

George T. Dunham, Surveyor

WISCONSIN
GEORGE T. DUNHAM
S-306
DELAVAN WIS.
LAND SURVEYOR

North Part Lot 1 Blk 2 C L Douglas

5-640-D