
RECEIVED
SEP 18 1995

FARRIS, HANSEN & ASSOCIATES, INC.
Engineering, Surveying and Land Planning
715 W. Walworth St. P. O. Box 487
ELKHORN, WISCONSIN 53121
Office: (414) 723-2098

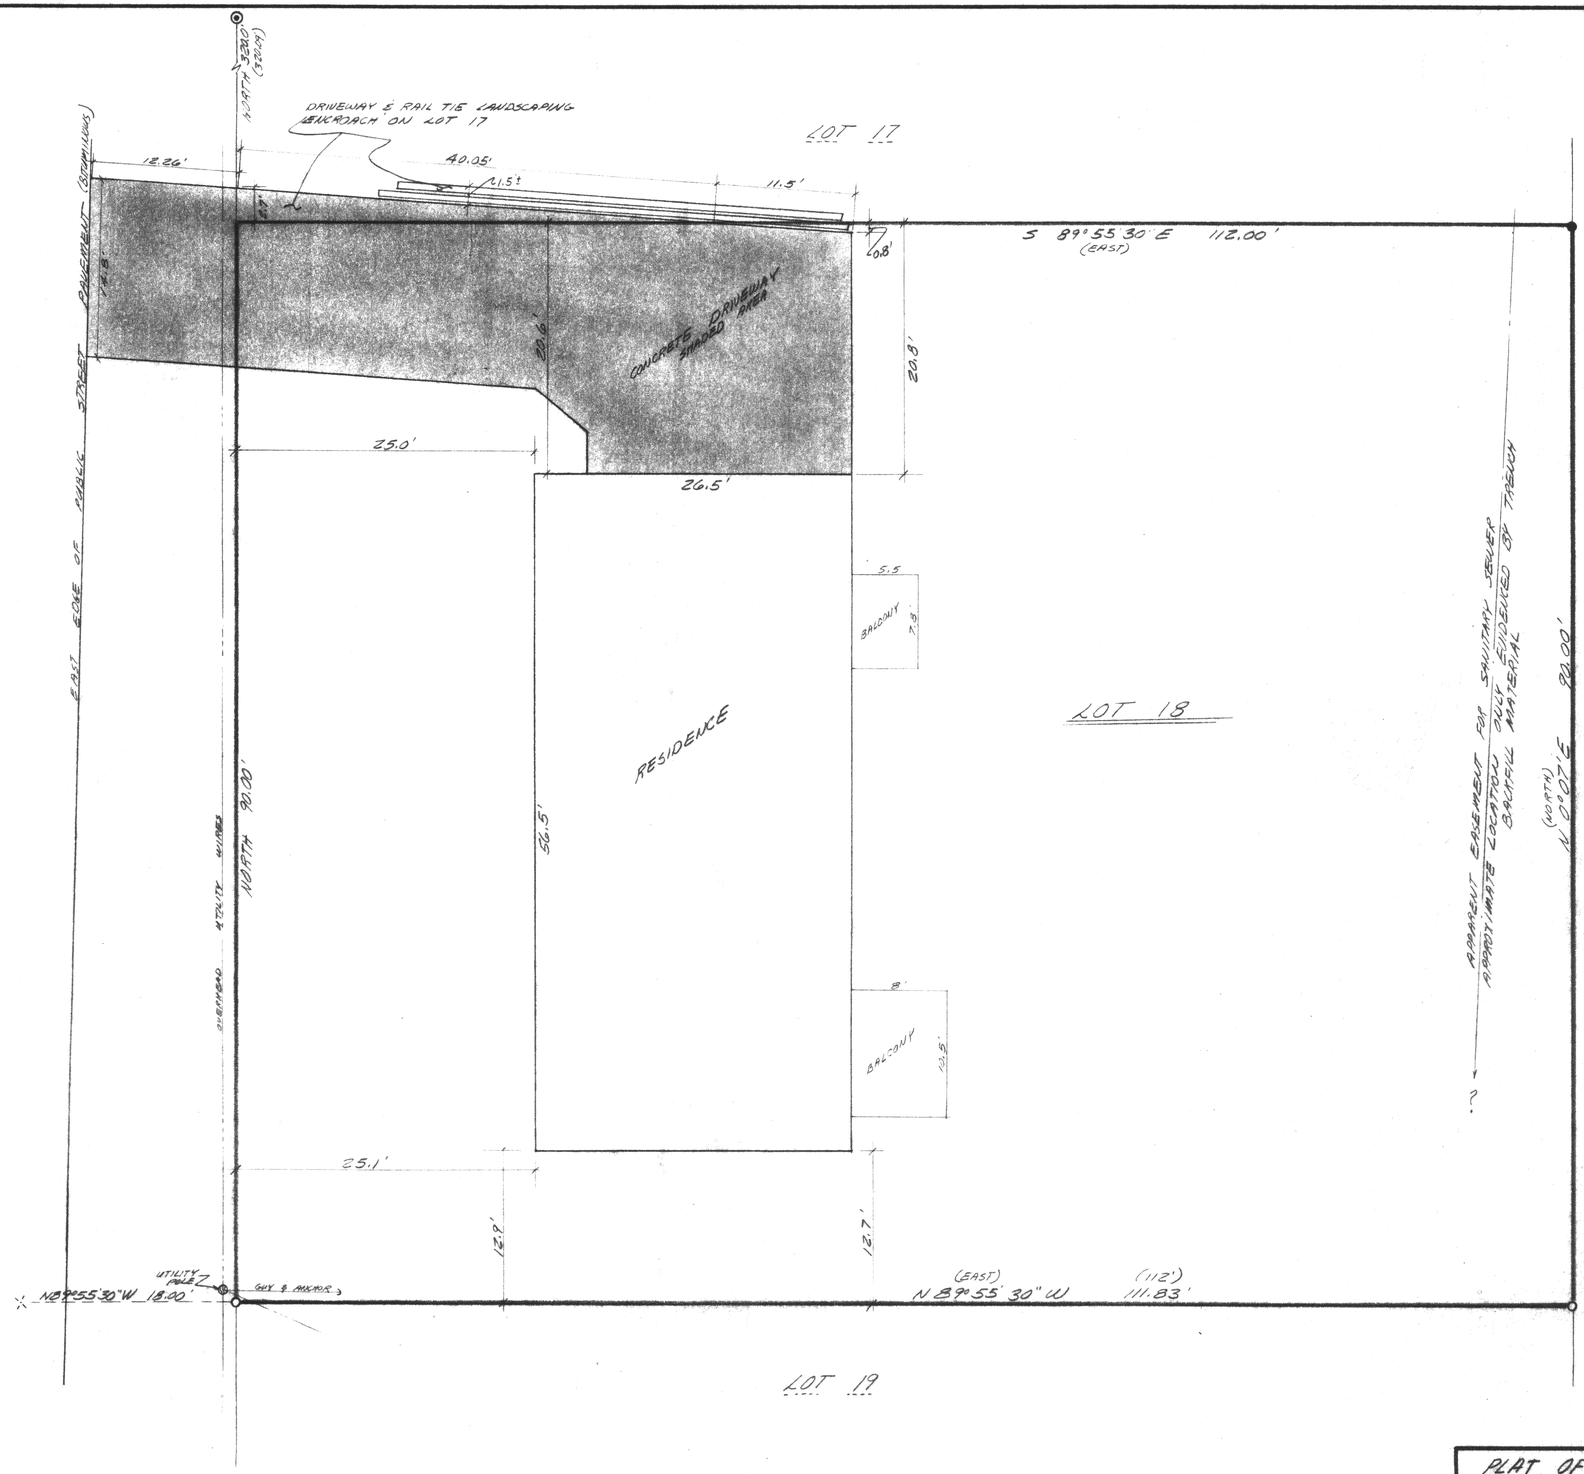

N

× = CONCRETE NAIL (PK) FOUND
○ = IRON PIPE STAKE FOUND
● = IRON ROD STAKE FOUND
⊙ = CONCRETE MONUMENT FOUND
(xxx) = RECORD DIMENSION
— ·· — = OVERHEAD WIRES

WORK ORDERED BY: MARCI RICHTER

I hereby certify that I have surveyed the above described property and that the above map is a true representation thereof and shows the size and location of the property, its exterior boundaries, the location of all visible structures and dimensions of all principal buildings thereon, boundary fences, apparent easements, roadways and visible encroachments, if any.
This survey is made for the use of the present owners of the property, and also those who purchase, mortgage, or guarantee the title thereto within one (1) year from the date hereof.

WISCONSIN
ROBERT A FARRIS
S-1297
ELKHORN WIS
REGISTERED LAND SURVEYOR

Robert A. Farris
7/26/95

10' 0 10' 20' 30' 40' 50'
SCALE IN FEET

PLAT OF SURVEY OF LOT 18 OF COUNTRY CLUB ESTATES ADD. "D" IN THE VILLAGE OF FONTANA, WALWORTH COUNTY, WISCONSIN

DATE	DRAWN BY	REVISIONS	BY	DATE	PROJECT NO.
7/26/95	RF				1879
SCALE	CHECKED BY				LAST REVISION
1"=6'					
	APPROVED BY				SHEET NO.
					1 of 1

TELEPHONE POST

5-640F