



DUNHAM SURVEYING, S.C.
SURVEYING & SUBDIVIDING
• DELAVAN, WISCONSIN 53115

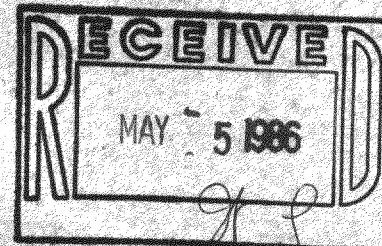

N

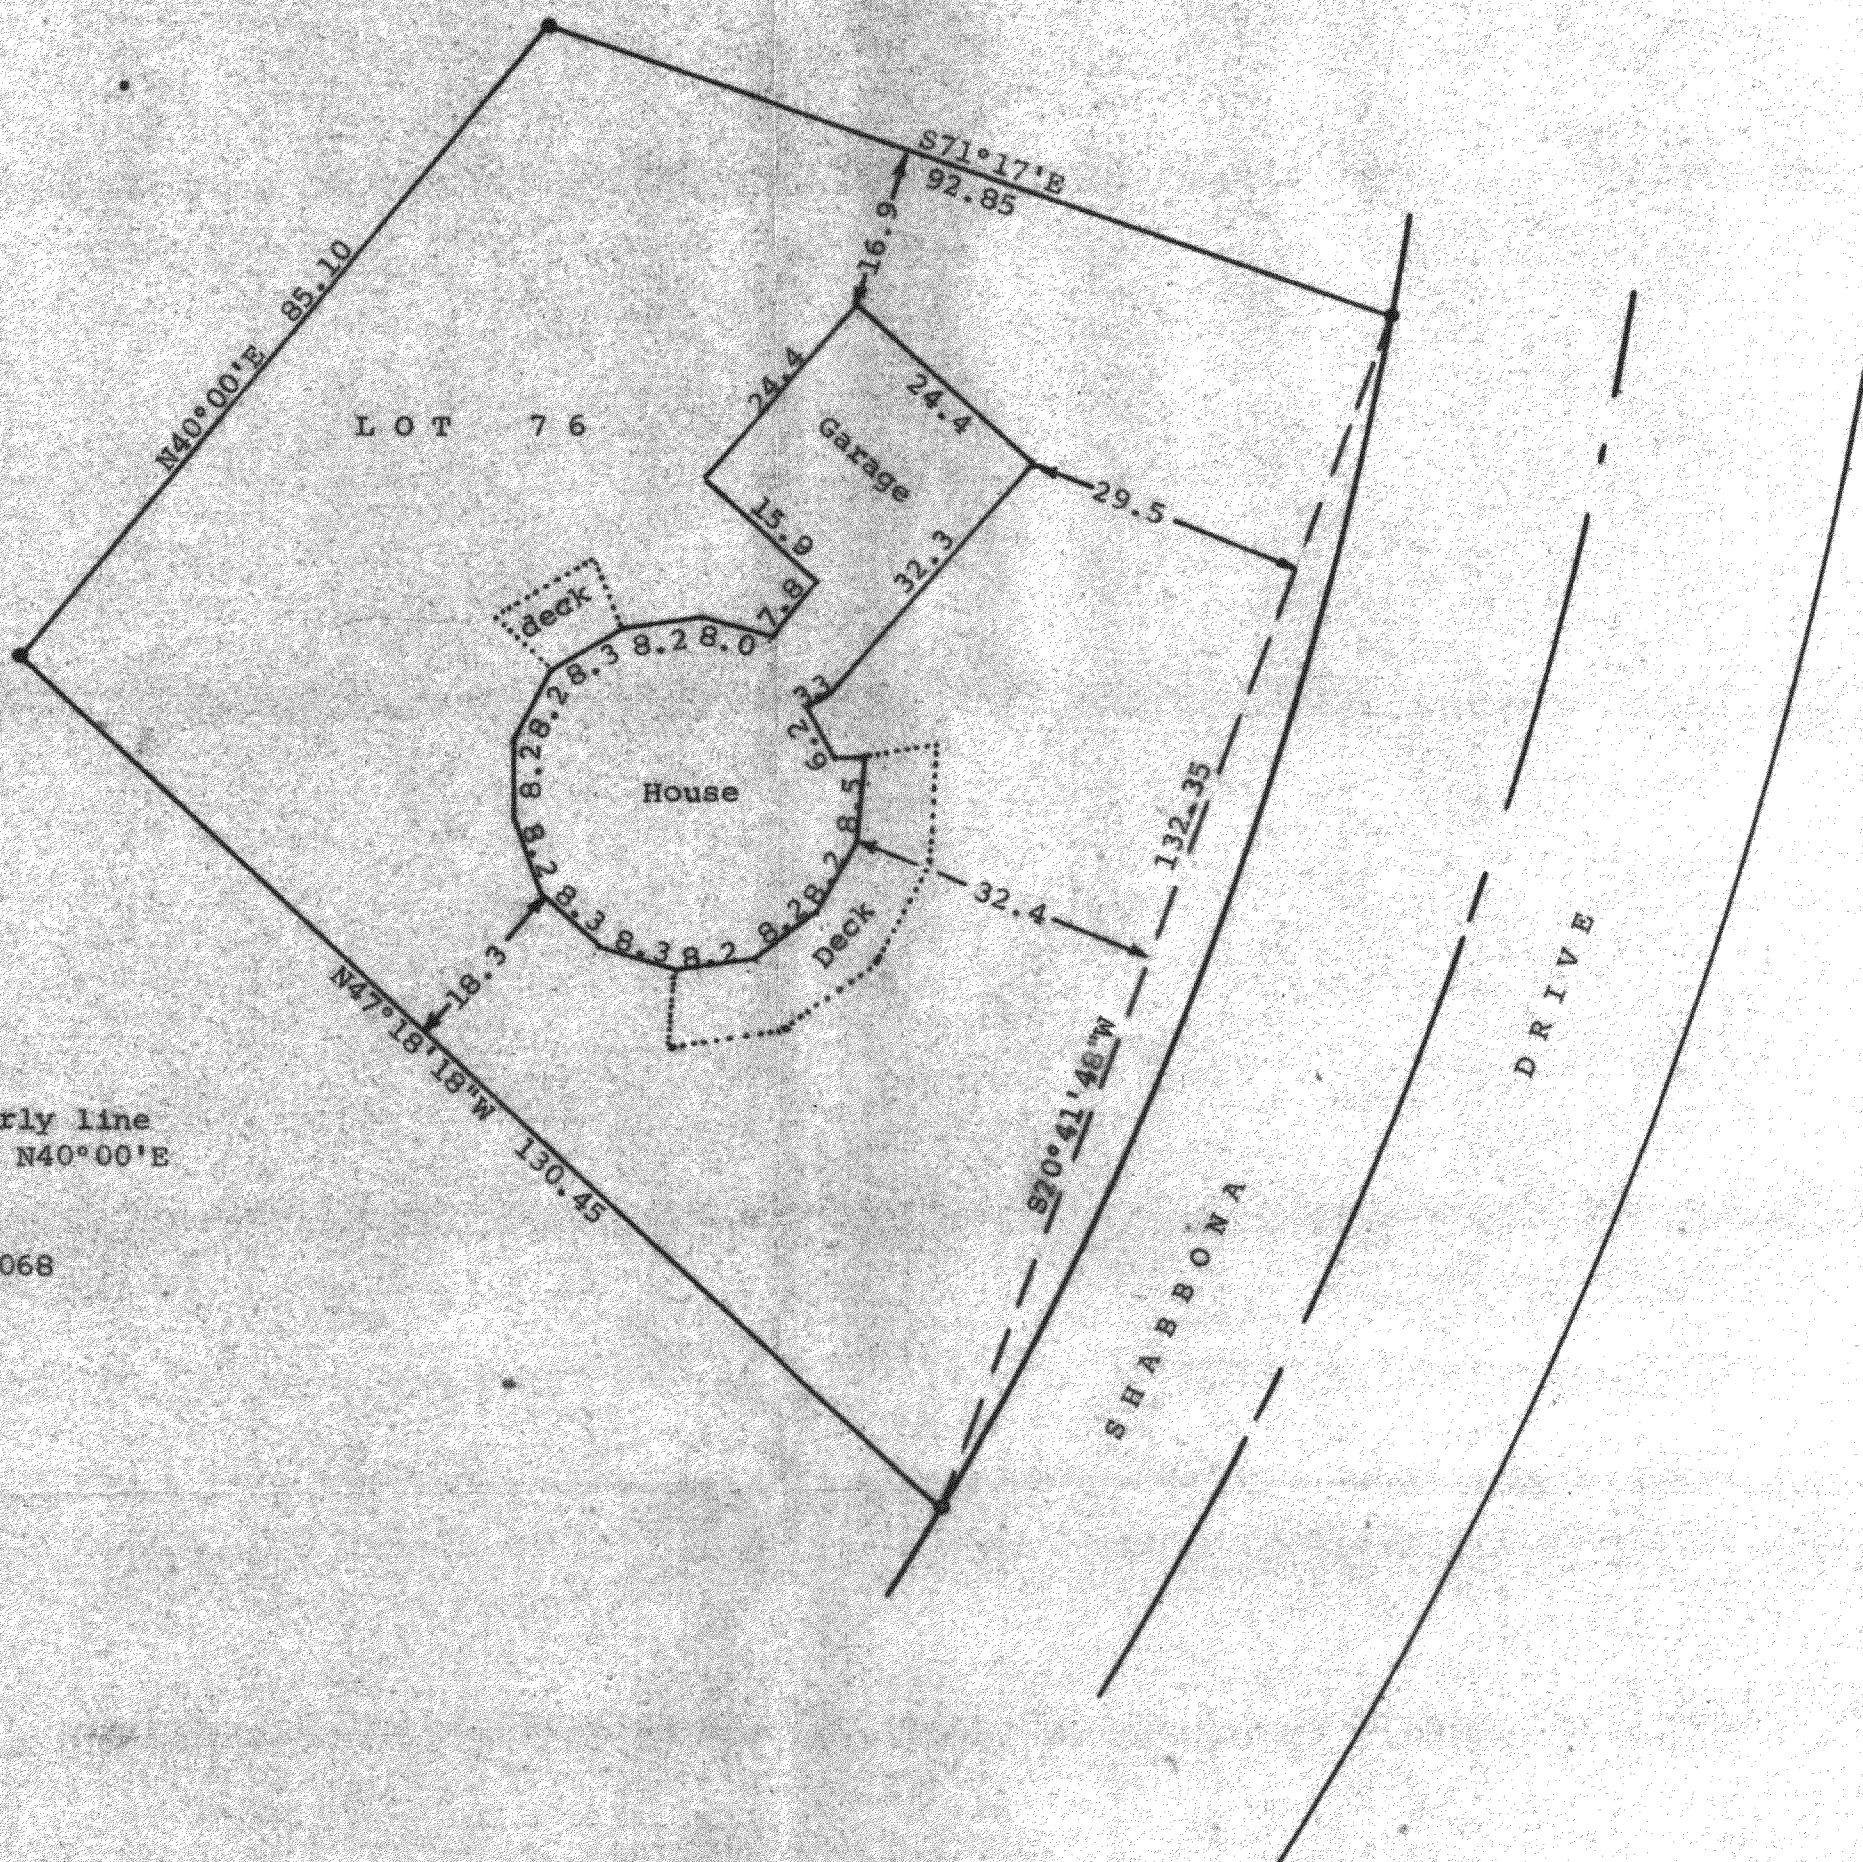

STATE OF WISCONSIN)
COUNTY OF WALWORTH)

I, George T. Dunham, Surveyor, certify that I have surveyed the property described as follows:

Lot 76 in Country Club Estates Unit No. 2 located in the Village of Fontana-on-Geneva Lake, Walworth County, Wisconsin, and that the map shown above is a true representation thereof and shows the size and location of the property, its exterior boundaries, the location of all visible structures and dimensions of all principal buildings thereon, boundary fences, apparent easements, roadways and visible encroachments, if any, and that I have surveyed the property hereon described according to the official records to the best of my knowledge and belief.

April 22, 1986

George T. Dunham
George T. Dunham, Surveyor