
RECEIVED
AUG 19 1986

DUNHAM SURVEYING, S. C.
SURVEYING & SUBDIVIDING
DELAVAN, WISCONSIN 53115

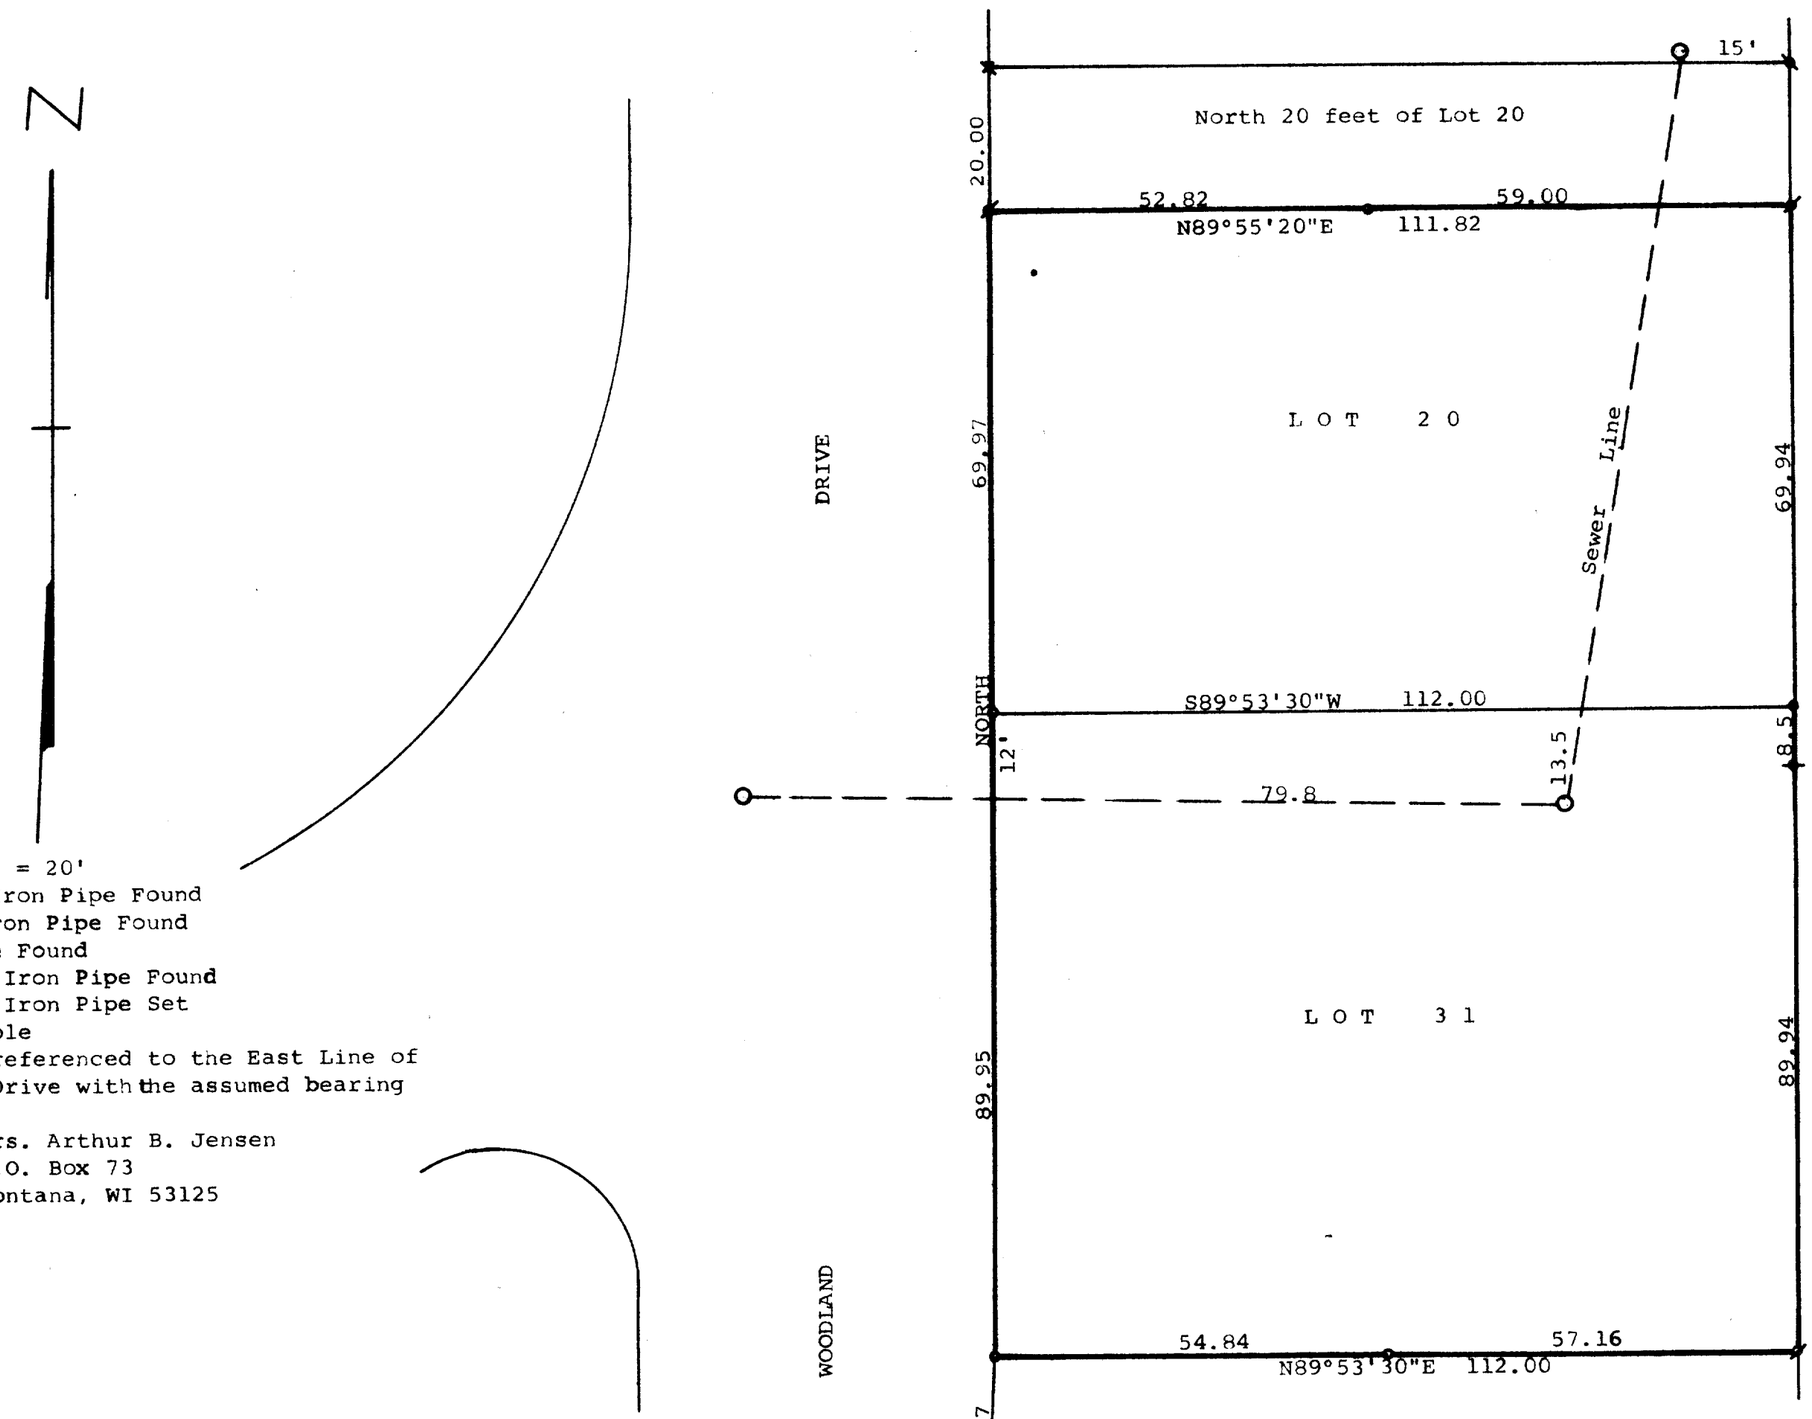

Scale - 1" = 20'
= 1¼" Iron Pipe Found
= 1" Iron Pipe Found
× = Spike Found
= 3/4" Iron Pipe Found
o = 3/4" Iron Pipe Set
O = Manhole
Bearings referenced to the East Line of Woodlawn Drive with the assumed bearing of North
Owner: Mrs. Arthur B. Jensen
P.O. Box 73
Fontana, WI 53125

STATE OF WISCONSIN)
SS
COUNTY OF WALWORTH)

I, George T. Dunham, Surveyor, certify that I have surveyed the property described as follows:

Lot 31, Addition "E" to Country Club Estates, located in the Village of Fontana-on-Geneva Lake, Walworth County, Wisconsin,
Also Lot 20, Addition "D" to Country Club Estates, located in the Village of Fontana-on-Geneva Lake, Walworth County, Wisconsin,
EXCEPTING therefrom the North 20.00 feet of said Lot 20,

and that the map shown above is a true representation thereof and shows the size and location of the property, its exterior boundaries, the location of all visible structures and dimensions of all principal buildings thereon, boundary fences, apparent easements, roadways and visible encroachments, if any, and that I have surveyed the property hereon described according to the official records, to the best of my knowledge and belief.

August 2, 1984

George T. Dunham, Surveyor

WISCONSIN
GEORGE T. DUNHAM
S-306
DELAVAN WIS.
LAND SURVEYOR

SCTE-00031

5-645-D

K & E 10-9155