
DUNHAM SURVEYING, S.C.
SURVEYING & SUBDIVIDING
DELAVAN, WISCONSIN 53115

RECEIVED
AUG 19 1986



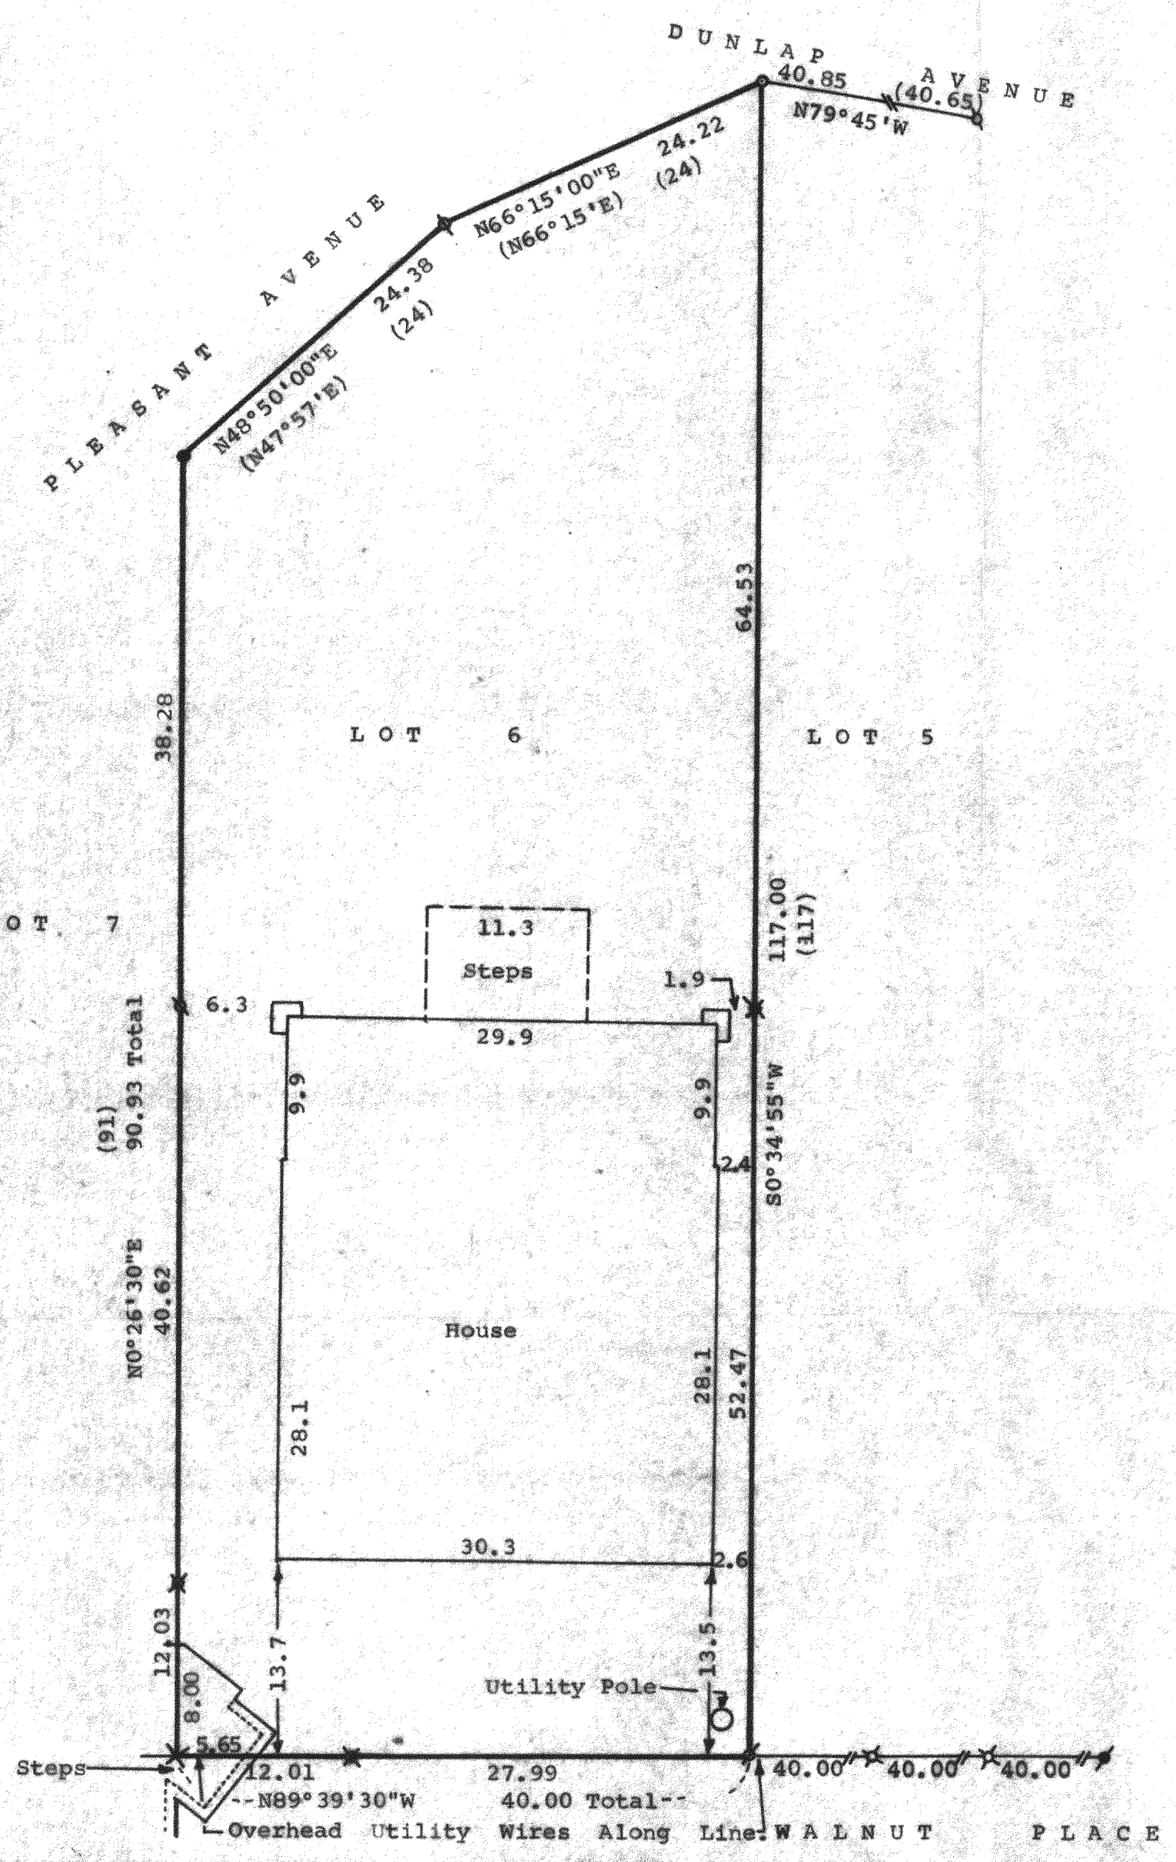

Scale - 1" = 10'
⌀ = Concrete Monument Found
● = ¼" Dia. Iron Rod Found
⌀ = ½" Dia. Iron Pipe Found
⌀ =3/4" Dia. Iron Pipe Found
⌀ = 1¼" Iron Pipe Set
⌀ = 3/4"x24" Iron Pipe Set
o = 1"x24" Iron Pipe Set
✗ = 60 Penny Spike Set
(0.00) = Recorded Distance
(N00°00'E) = Recorded Bearing
✗ = ½"x24" Iron Pipe Set
Bearings are referenced to the Northerly line of Lot 5, recorded bearing of N79°45'E.
Owner: William Gamen
3907 West 60th Street
Chicago, Ill. 60629

STATE OF WISCONSIN)
COUNTY OF WALWORTH) SS

I, George T. Dunham, Surveyor, certify that I have surveyed the property described as follows,

Lot 6, Block 12 of Glenwood Springs, a subdivision located in the Village of Fontana, Walworth County, Wisconsin,

and that the map shown above is a true representation thereof and shows the size and location of the property, its exterior boundaries, the location of all visible structures and dimensions of all principal buildings thereon, boundary fences, apparent easements, roadways and visible encroachments, if any, and that I have surveyed the property hereon described according to the official records, to the best of my knowledge and belief.
July 20, 1984.

George T. Dunham
George T. Dunham, Surveyor

WISCONSIN
GEORGE T. DUNHAM
S-306
DELAVAN WIS.
LAND SURVEYOR

SGS-00064

5-649-D

K & E 10-9155