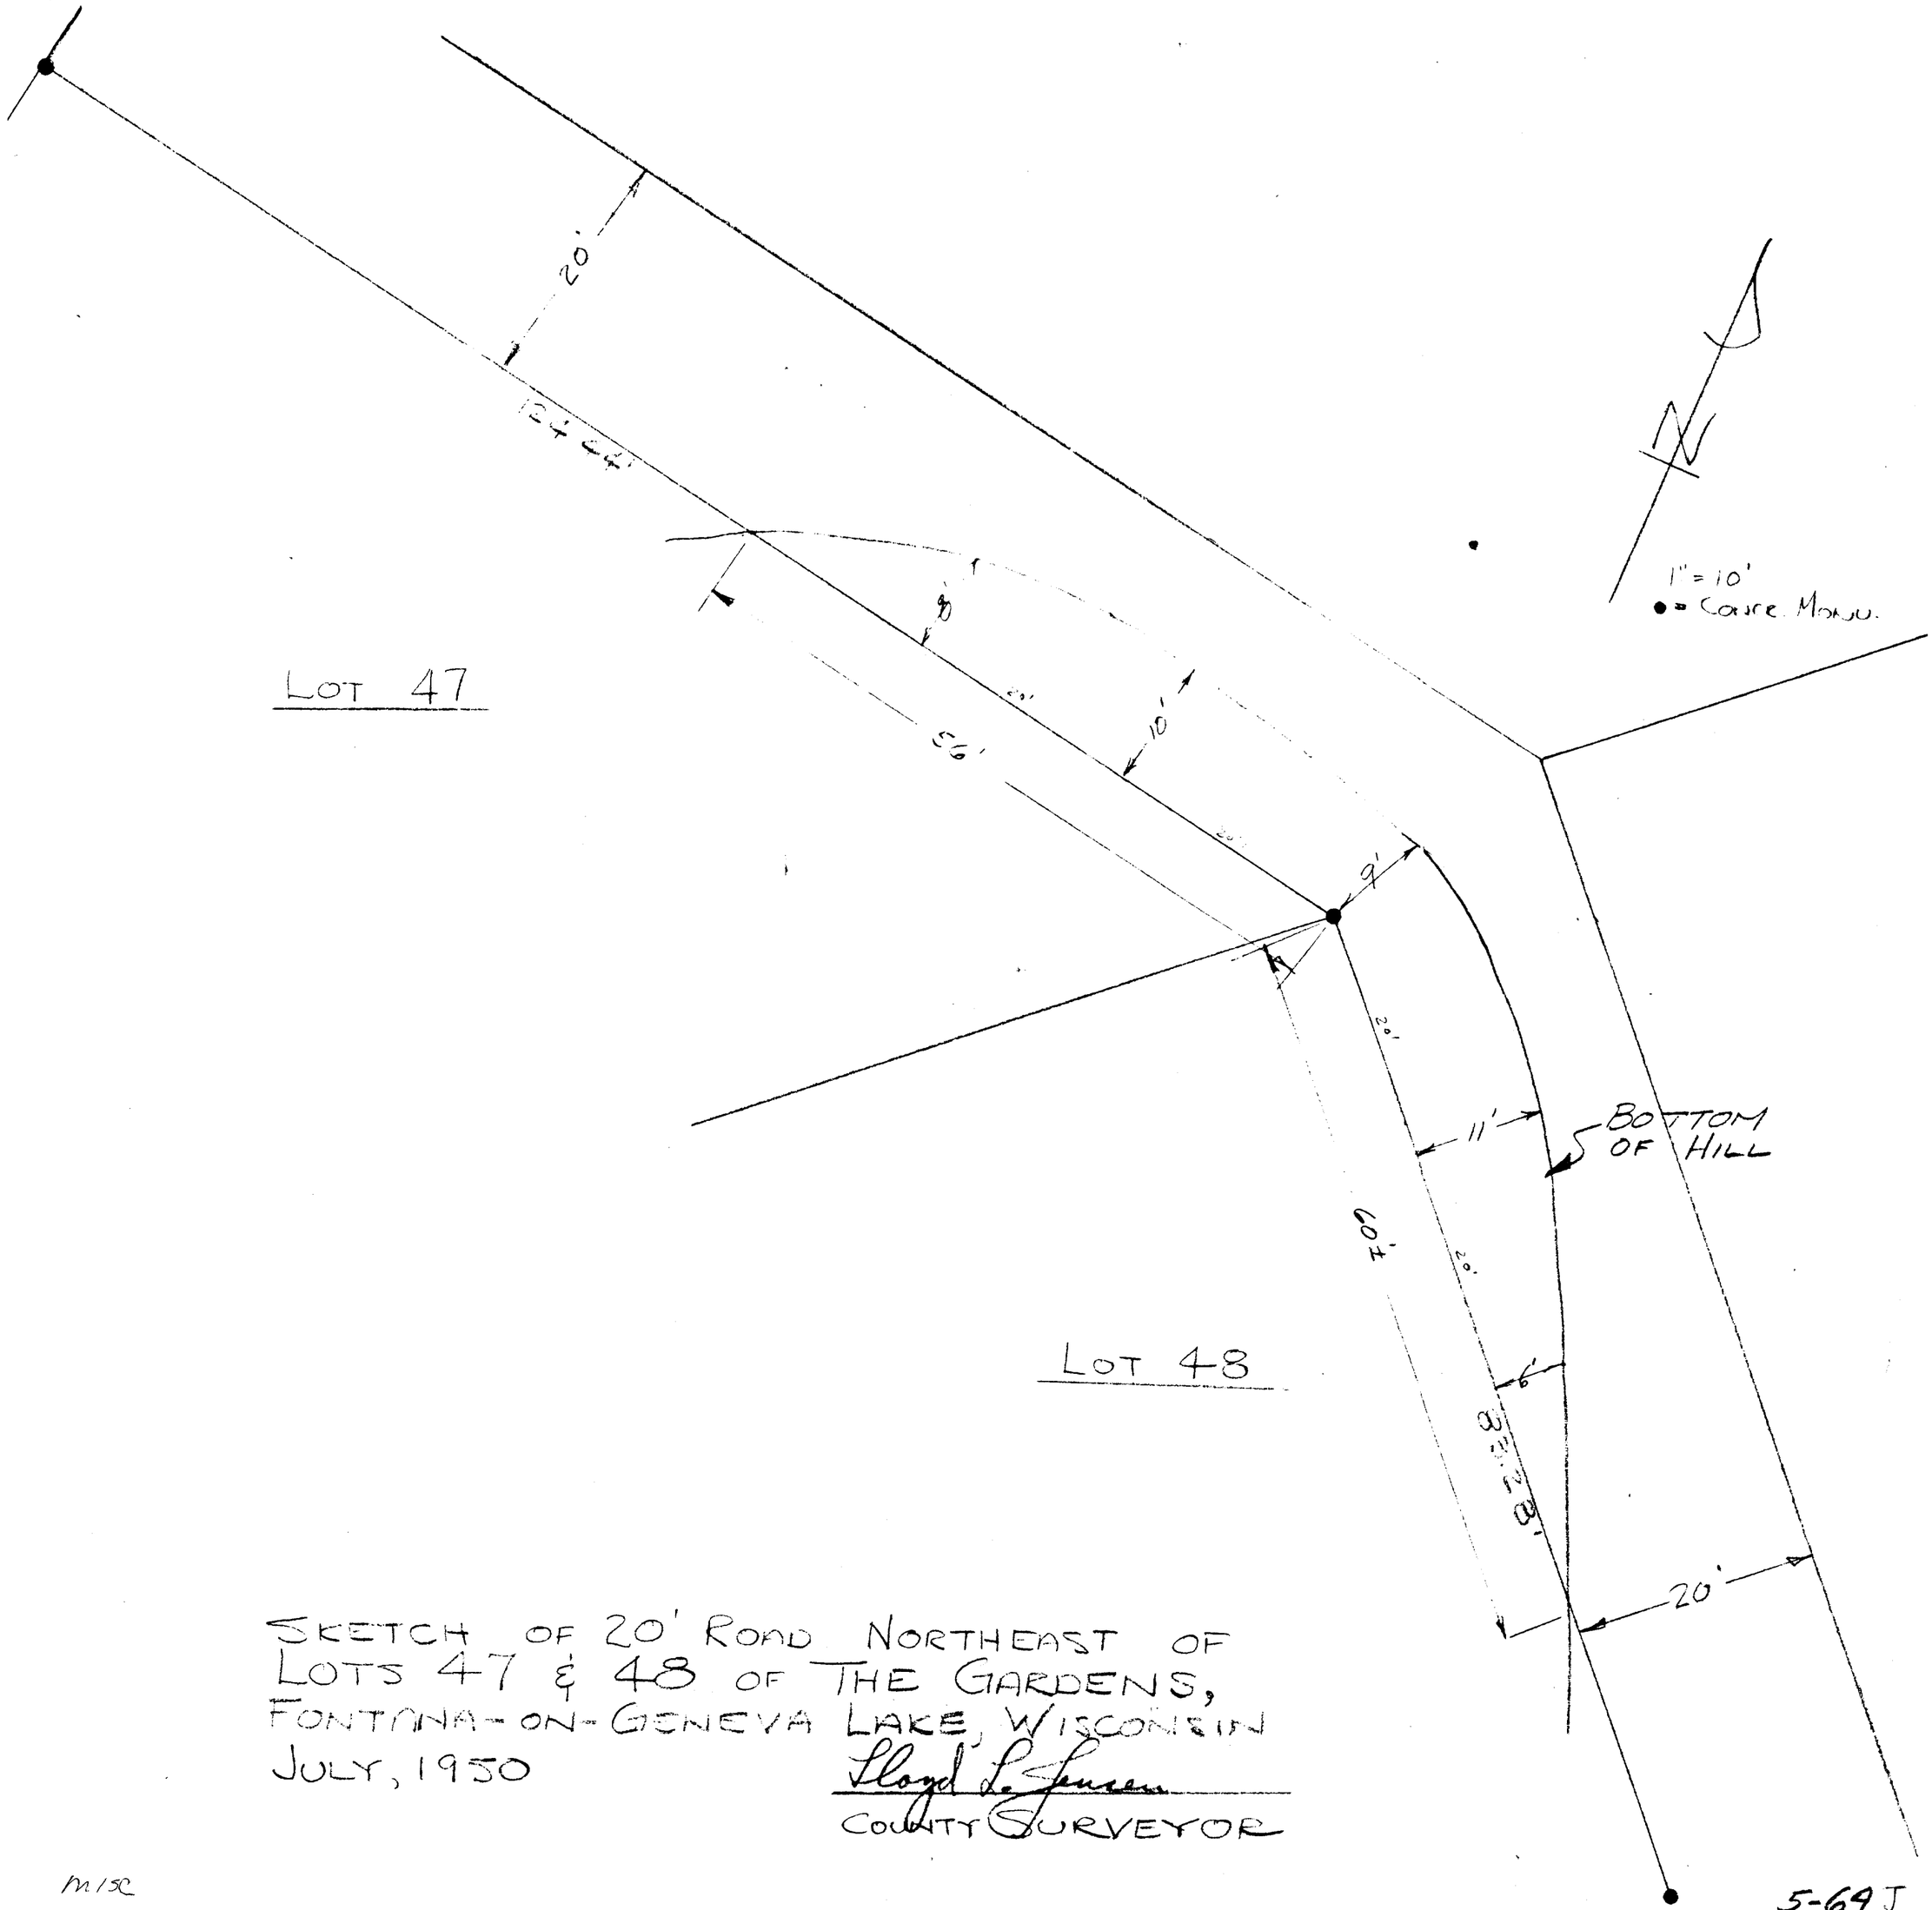


SKETCH OF 20' ROAD NORTHEAST OF LOTS 47 & 48 OF THE GARDENS, FONTANA-ON-GENEVA LAKE, WISCONSIN
JULY, 1950

Lloyd L. Jensen
COUNTY SURVEYOR

MISC

5-69 J