
KOLB LAND CONSULTING, INC.

LAND SURVEYING · SUBDIVIDING · LAND PLANNING

LAKE GENEVA, WISCONSIN 53147

RECEIVED
NOV 13 1986

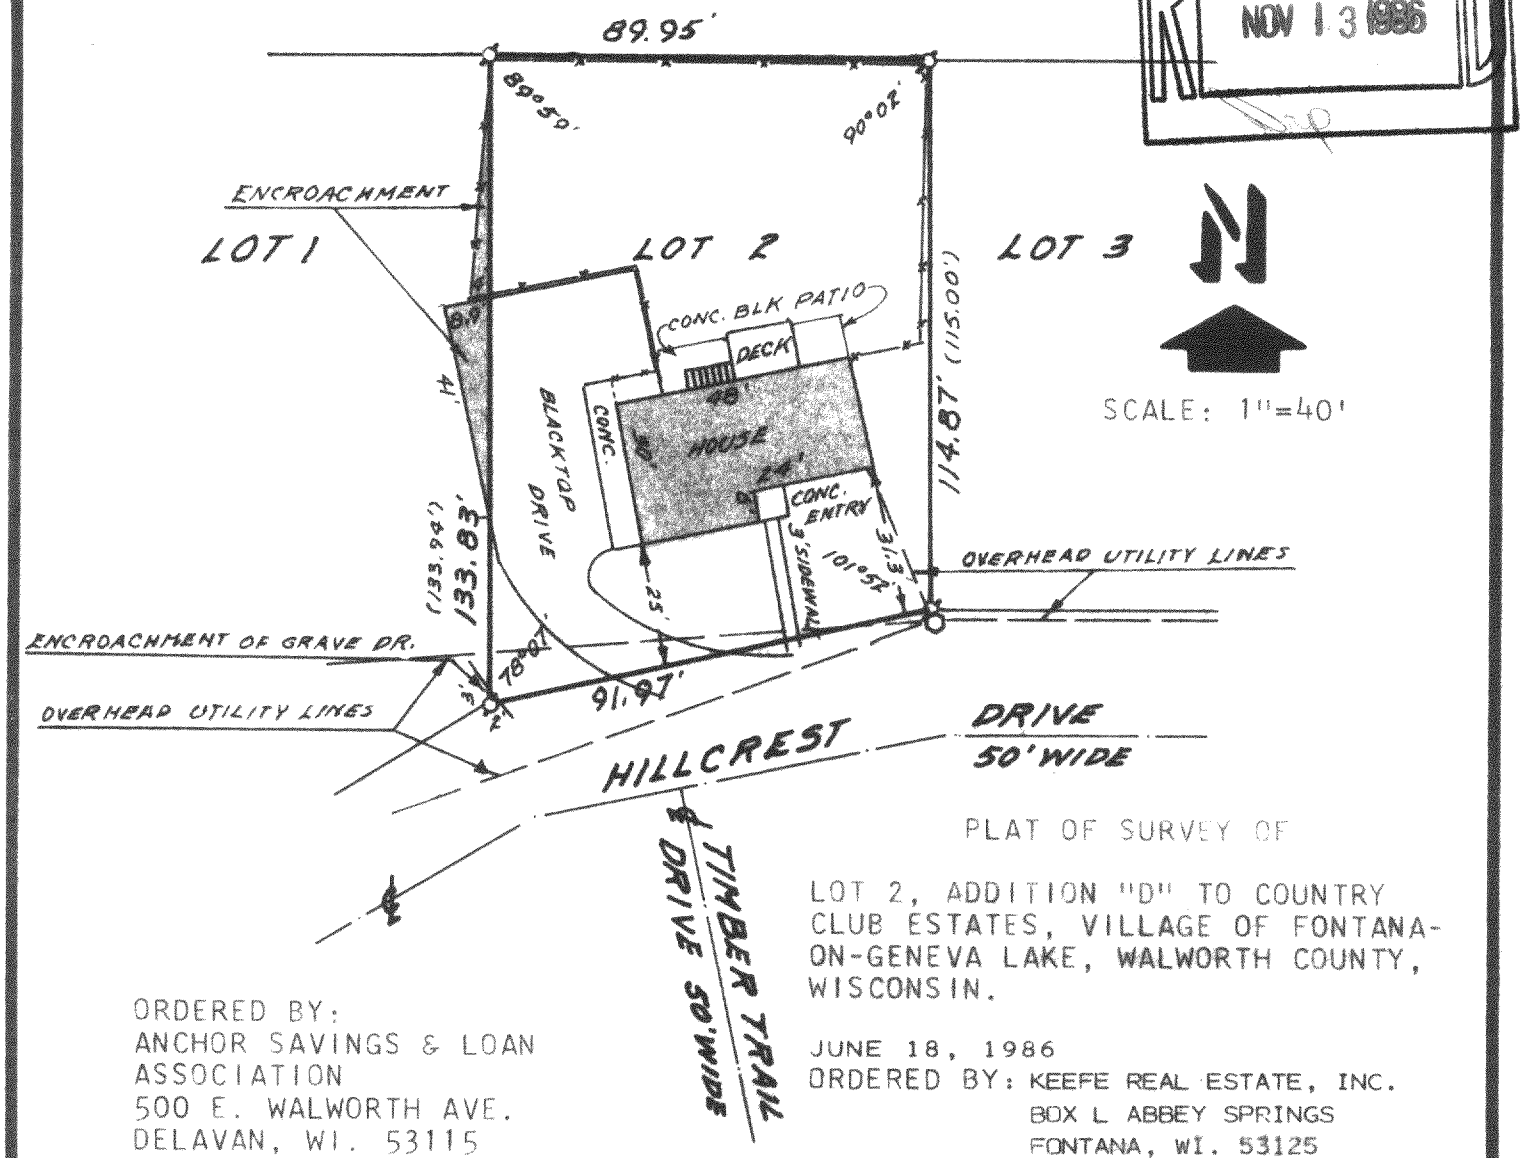

PLAT OF SURVEY OF

LOT 2, ADDITION "D" TO COUNTRY CLUB ESTATES, VILLAGE OF FONTANA-ON-GENEVA LAKE, WALWORTH COUNTY, WISCONSIN.

JUNE 18, 1986
ORDERED BY: KEEFE REAL ESTATE, INC.
BOX L ABBEY SPRINGS
FONTANA, WI. 53125
RELOCATED ALL CORNERS.

Harold H. Kolb
HAROLD H. KOLB

ORDERED BY:
ANCHOR SAVINGS & LOAN ASSOCIATION
500 E. WALWORTH AVE.
DELAVAN, WI. 53115

OWNER:
JEFFERY BAKER
ROUTE 3, BOX 150C
FONTANA, WI. 53125

LEGEND

ø	IRON PIPE FOUND
—x—	FENCE
(72')	AS RECORDED

I HEREBY CERTIFY THAT I HAVE SURVEYED THE ABOVE DESCRIBED PROPERTY AND THAT THE ABOVE MAP IS A TRUE REPRESENTATION THEREOF AND SHOWS THE SIZE AND LOCATION OF THE PROPERTY, ITS EXTERIOR BOUNDARIES, THE LOCATION OF ALL VISIBLE STRUCTURES AND DIMENSIONS OF ALL PRINCIPAL BUILDINGS THEREON, BOUNDARY FENCES APPARENT EASEMENTS, ROADWAYS AND VISIBLE ENCROACHMENTS, IF ANY.

THIS SURVEY IS MADE FOR THE USE OF THE PRESENT OWNERS OF THE PROPERTY, AND ALSO THOSE WHO PURCHASE, MORTGAGE, OR GUARANTEE THE TITLE THERETO WITHIN ONE (1) YEAR FROM THE DATE HEREOF.

WISCONSIN HAROLD H. KOLB S-187 LAND SURVEYOR

Harold H. Kolb
HAROLD H. KOLB
WISCONSIN REGISTERED LAND SURVEYOR, S- 187
DATE MARCH 30, 1984

REVISED: JUNE 18, 1986

SCT D-2

FONT-212

5-67/K