
KOLB LAND CONSULTING, INC.
LAND SURVEYING · SUBDIVIDING · LAND PLANNING

LAKE GENEVA, WISCONSIN 53147

RECEIVED
NOV 13 1986

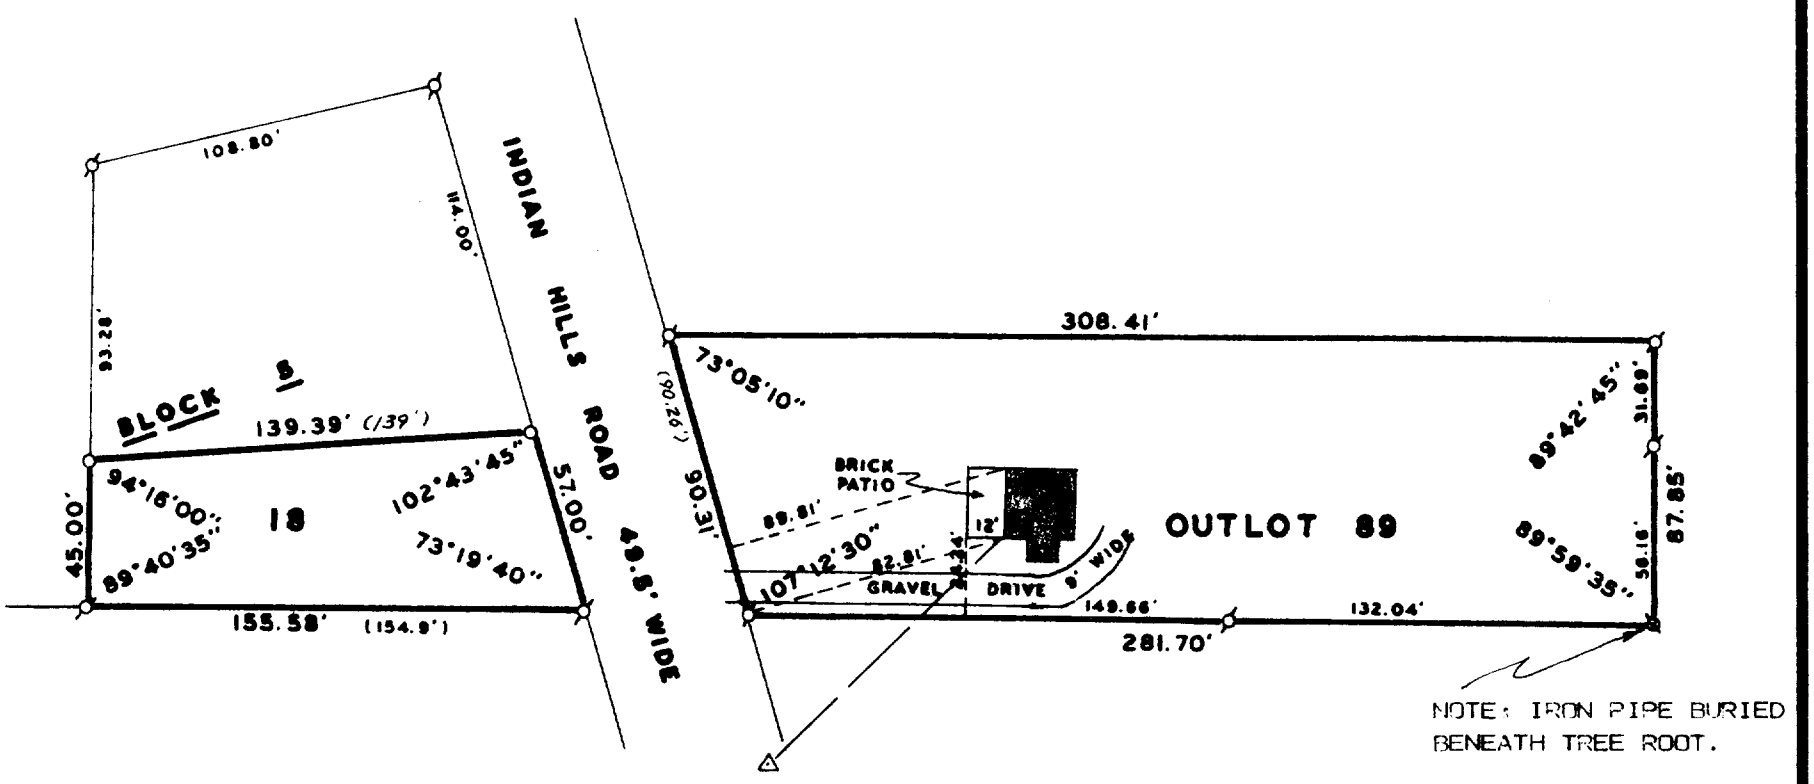

SCALE 1" = 60'

LEGEND

- ø - IRON PIPE FOUND
- ø - SPIKE FOUND
- o - 1" X 24" IRON PIPE SET
- △ - UTILITY POLE
- ——— ——— - OVERHEAD UTILITY LINE
- ( ) - AS RECORDED
- H - HOUSE

ORDERED BY: COLDWELL BANKERS
333 MAIN
LAKE GENEVA, WI. 53147

PLAT OF SURVEY OF

LOT 18, BLOCK 5 OF INDIAN HILLS SUBDIVISION AND OUTLOT 89 OF ASSESSORS PLAT NUMBER 1, AMENDED, BOTH LOCATED IN SECTION 14, T1N, R16E, VILLAGE OF FONTANA-ON-GENEVA LAKE, WALWORTH COUNTY, WISCONSIN.

WISCONSIN REGISTERED LAND SURVEYOR
HAROLD H. KOLB
S-187
LAKE GENEVA
WI

I HEREBY CERTIFY THAT I HAVE SURVEYED THE ABOVE DESCRIBED PROPERTY AND THAT THE ABOVE MAP IS A TRUE REPRESENTATION THEREOF AND SHOWS THE SIZE AND LOCATION OF THE PROPERTY, ITS EXTERIOR BOUNDARIES, THE LOCATION OF ALL VISIBLE STRUCTURES AND DIMENSIONS OF ALL PRINCIPAL BUILDINGS THEREON, BOUNDARY FENCES, APPARENT EASEMENTS, ROADWAYS AND VISIBLE ENCROACHMENTS, IF ANY, TO THE BEST OF MY KNOWLEDGE AND BELIEF.
THIS SURVEY IS MADE FOR THE USE OF THE PRESENT OWNERS OF THE PROPERTY AND ALSO THOSE WHO PURCHASE, MORTGAGE OR GUARANTEE THE TITLE THERETO WITHIN ONE (1) YEAR FROM DATE HEREOF.

Harold H. Kolb
HAROLD H. KOLB
WISCONSIN REGISTERED LAND SURVEYOR, S-187
DATE OCTOBER 8, 1986

S1H-79A + STFU-136

5-70

5-673K