
FARRIS, HANSEN & ASSOCIATES, INC.
7 RIDGEWAY COURT ELKHORN, WI
414-723-2098

SURVEY

Plat of Survey of UNIT 411 OF ABBEY SPRINGS CONDOMINIUM NO. 14 VILLAGE OF FONTANA, WIS.

WORK ORDERED BY: VISNER CONSTRUCTION

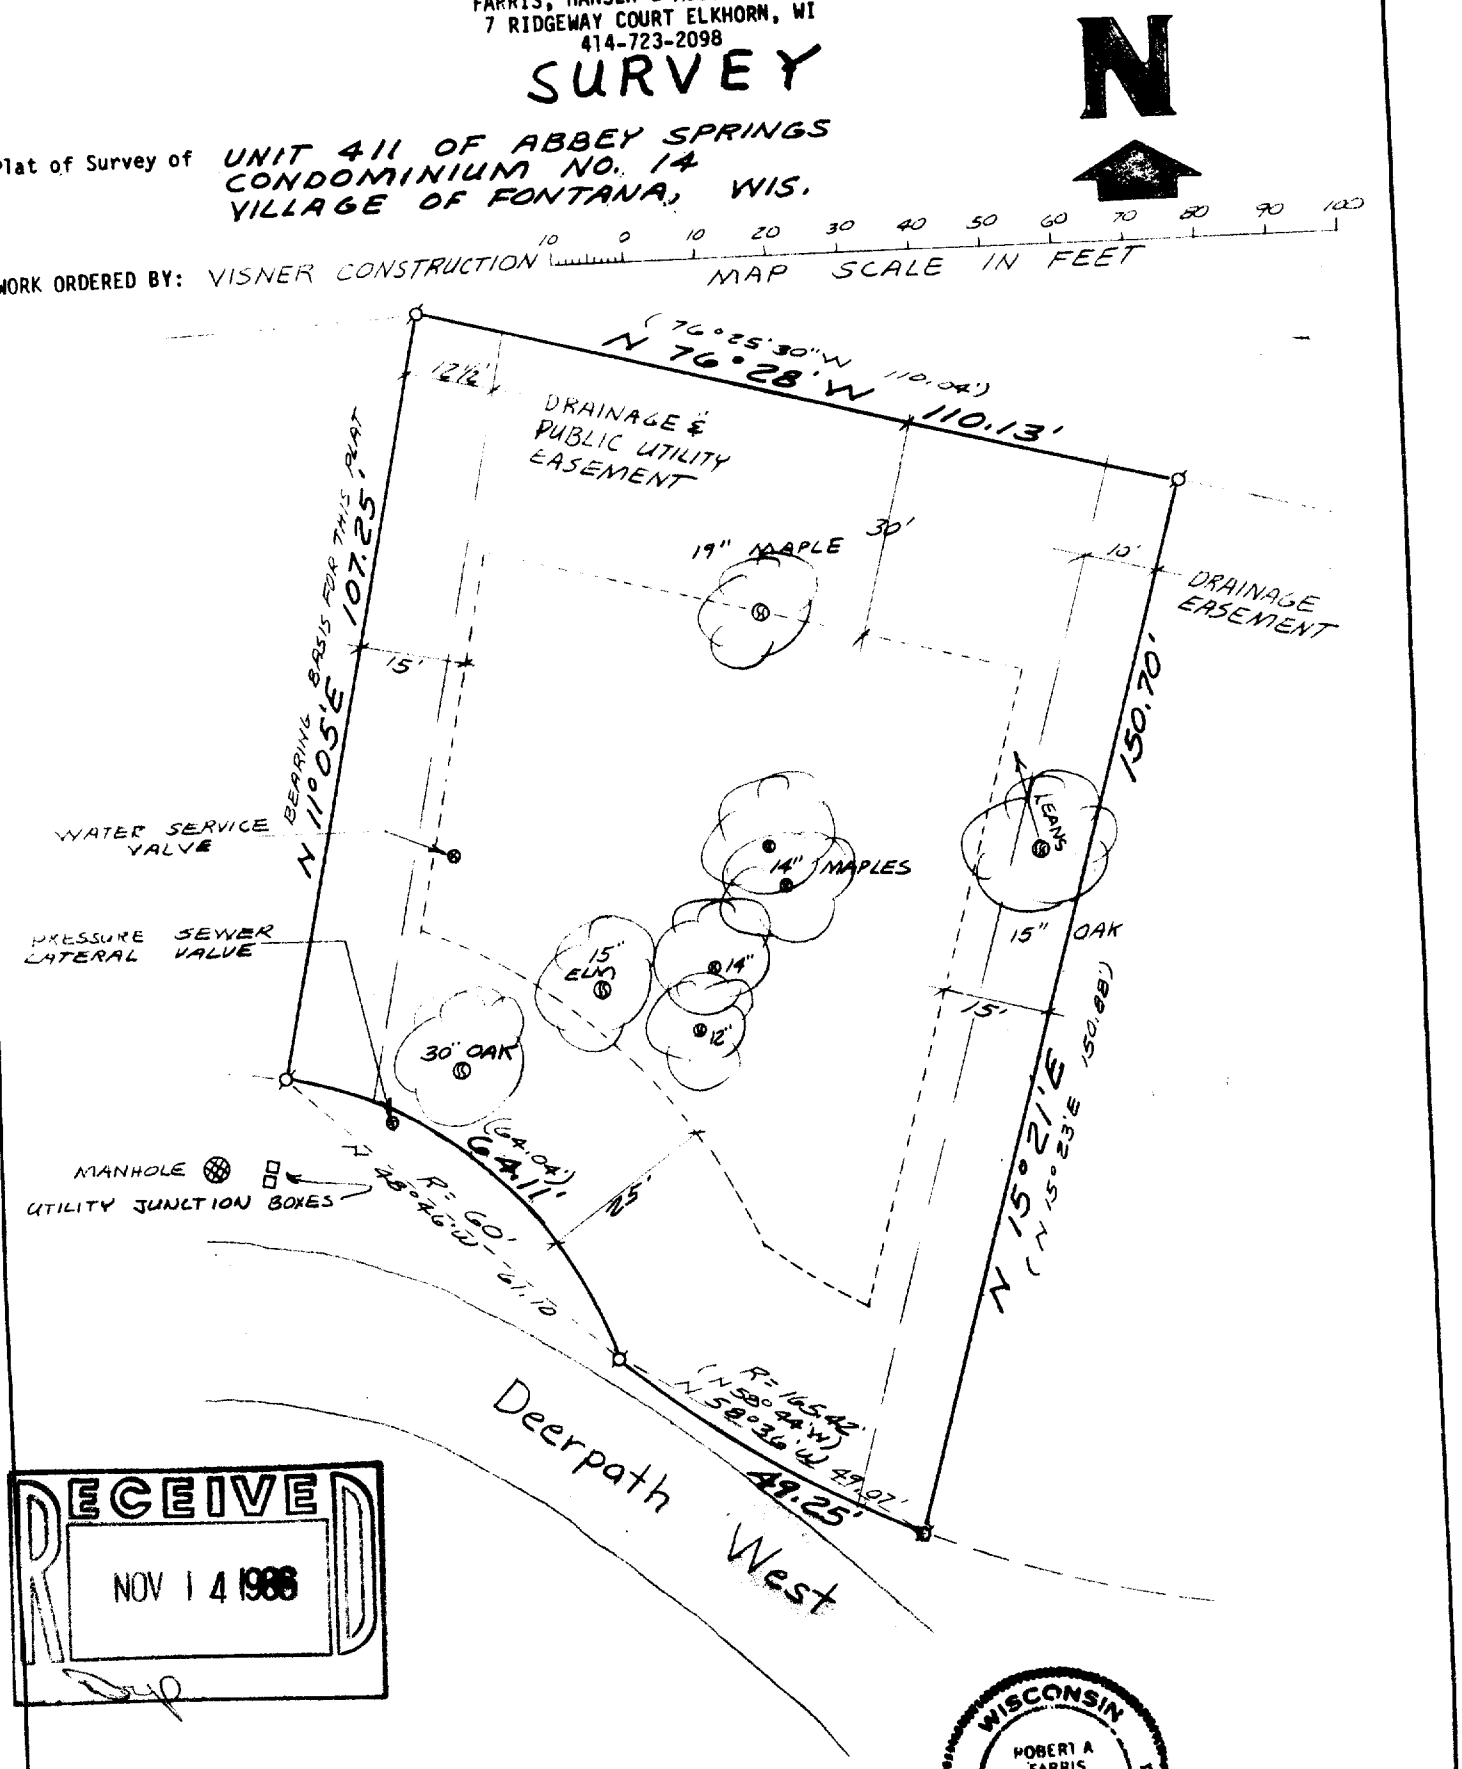

RECEIVED
NOV 14 1986

WISCONSIN
ROBERT A FARRIS
S-1291
ELKHORN WIS
LAND SURVEYOR

LEGEND

Ø = Iron Pipe Survey Stake Found
O = Iron Pipe Survey Stake Set
(XXX)= Record Dimension
- - - - - - - - : Building Limits
TREES OVER 6" DIA. LOCATED

CERTIFICATE

I hereby certify that the above described property has been surveyed under my direction and that the above map is a true representation thereof and shows the size and location of the property, its exterior boundaries, the location of all visible structures and dimensions of all principal buildings thereon, boundary fences, apparent easements, roadways and visible encroachments, if any.
This survey is made for the use of the present owners of the property, and also for those who purchase, mortgage, or guarantee the title thereto within one (1) year from the date hereof.

Robert A. Farris

Robert A. Farris, R.L.S.

Dated this 17th day of OCTOBER 1986

PROJECT NO. 2678

5-615F

SCDBI4-411