
ABELL
SURVEYING & MAPPING
DELAVAN, WISCONSIN 53115
414-728-6737

RECEIVED
JAN 7

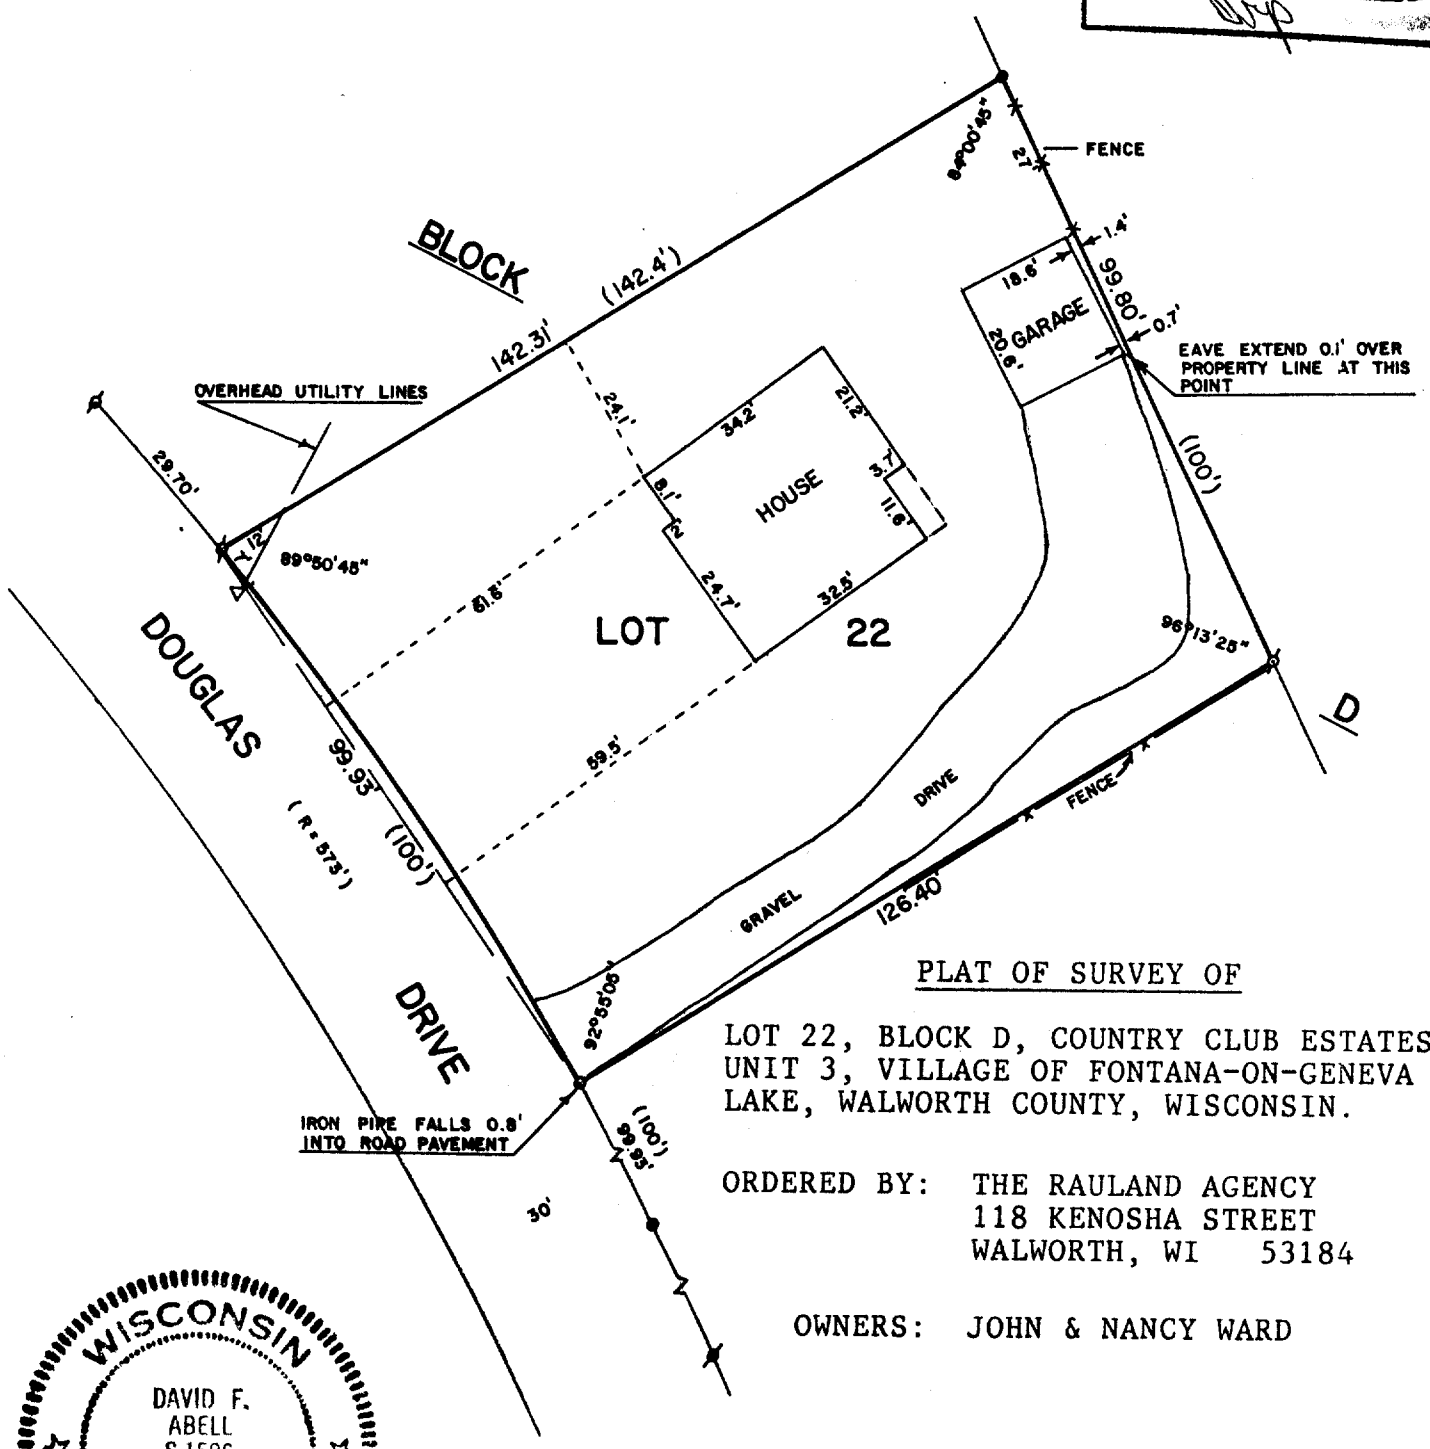

PLAT OF SURVEY OF

LOT 22, BLOCK D, COUNTRY CLUB ESTATES-UNIT 3, VILLAGE OF FONTANA-ON-GENEVA LAKE, WALWORTH COUNTY, WISCONSIN.

ORDERED BY: THE RAULAND AGENCY
118 KENOSHA STREET
WALWORTH, WI 53184

OWNERS: JOHN & NANCY WARD

WISCONSIN
DAVID F. ABELL
S-1596
Delavan, Wis.
LAND SURVEYOR

SCALE - 1"=30'

LEGEND
- ⌀ - IRON PIPE FOUND
- ● - IRON ROD FOUND
- ⌀ - CONCRETE MONUMENT FOUND
- ○ - IRON PIPE SET
- ◁ - UTILITY POLE
- ( )- RECORDED AS

I HEREBY CERTIFY THAT I HAVE SURVEYED THE ABOVE DESCRIBED PROPERTY AND THAT THE ABOVE MAP IS A TRUE REPRESENTATION THEREOF AND SHOWS THE SIZE AND LOCATION OF THE PROPERTY, ITS EXTERIOR BOUNDARIES, AND LOCATION OF ALL PRINCIPAL BUILDINGS THEREON, BOUNDARY FENCES, APPARENT EASEMENTS, ROADWAYS, AND VISIBLE ENCROACHMENTS, IF ANY, TO THE BEST OF MY KNOWLEDGE AND BELIEF.

THIS SURVEY IS MADE FOR THE USE OF THE PRESENT OWNERS OF THE PROPERTY, AND ALSO THOSE WHO PURCHASE, MORTGAGE, OR GUARANTEE THE TITLE THERETO WITH ONE (1) YEAR FROM DATE HEREOF.

David F. Abell
DAVID F. ABELL
WISCONSIN REGISTERED LAND SURVEYOR, S-1596

December 9, 1986
DATE JOB NUMBER -86081

5-680