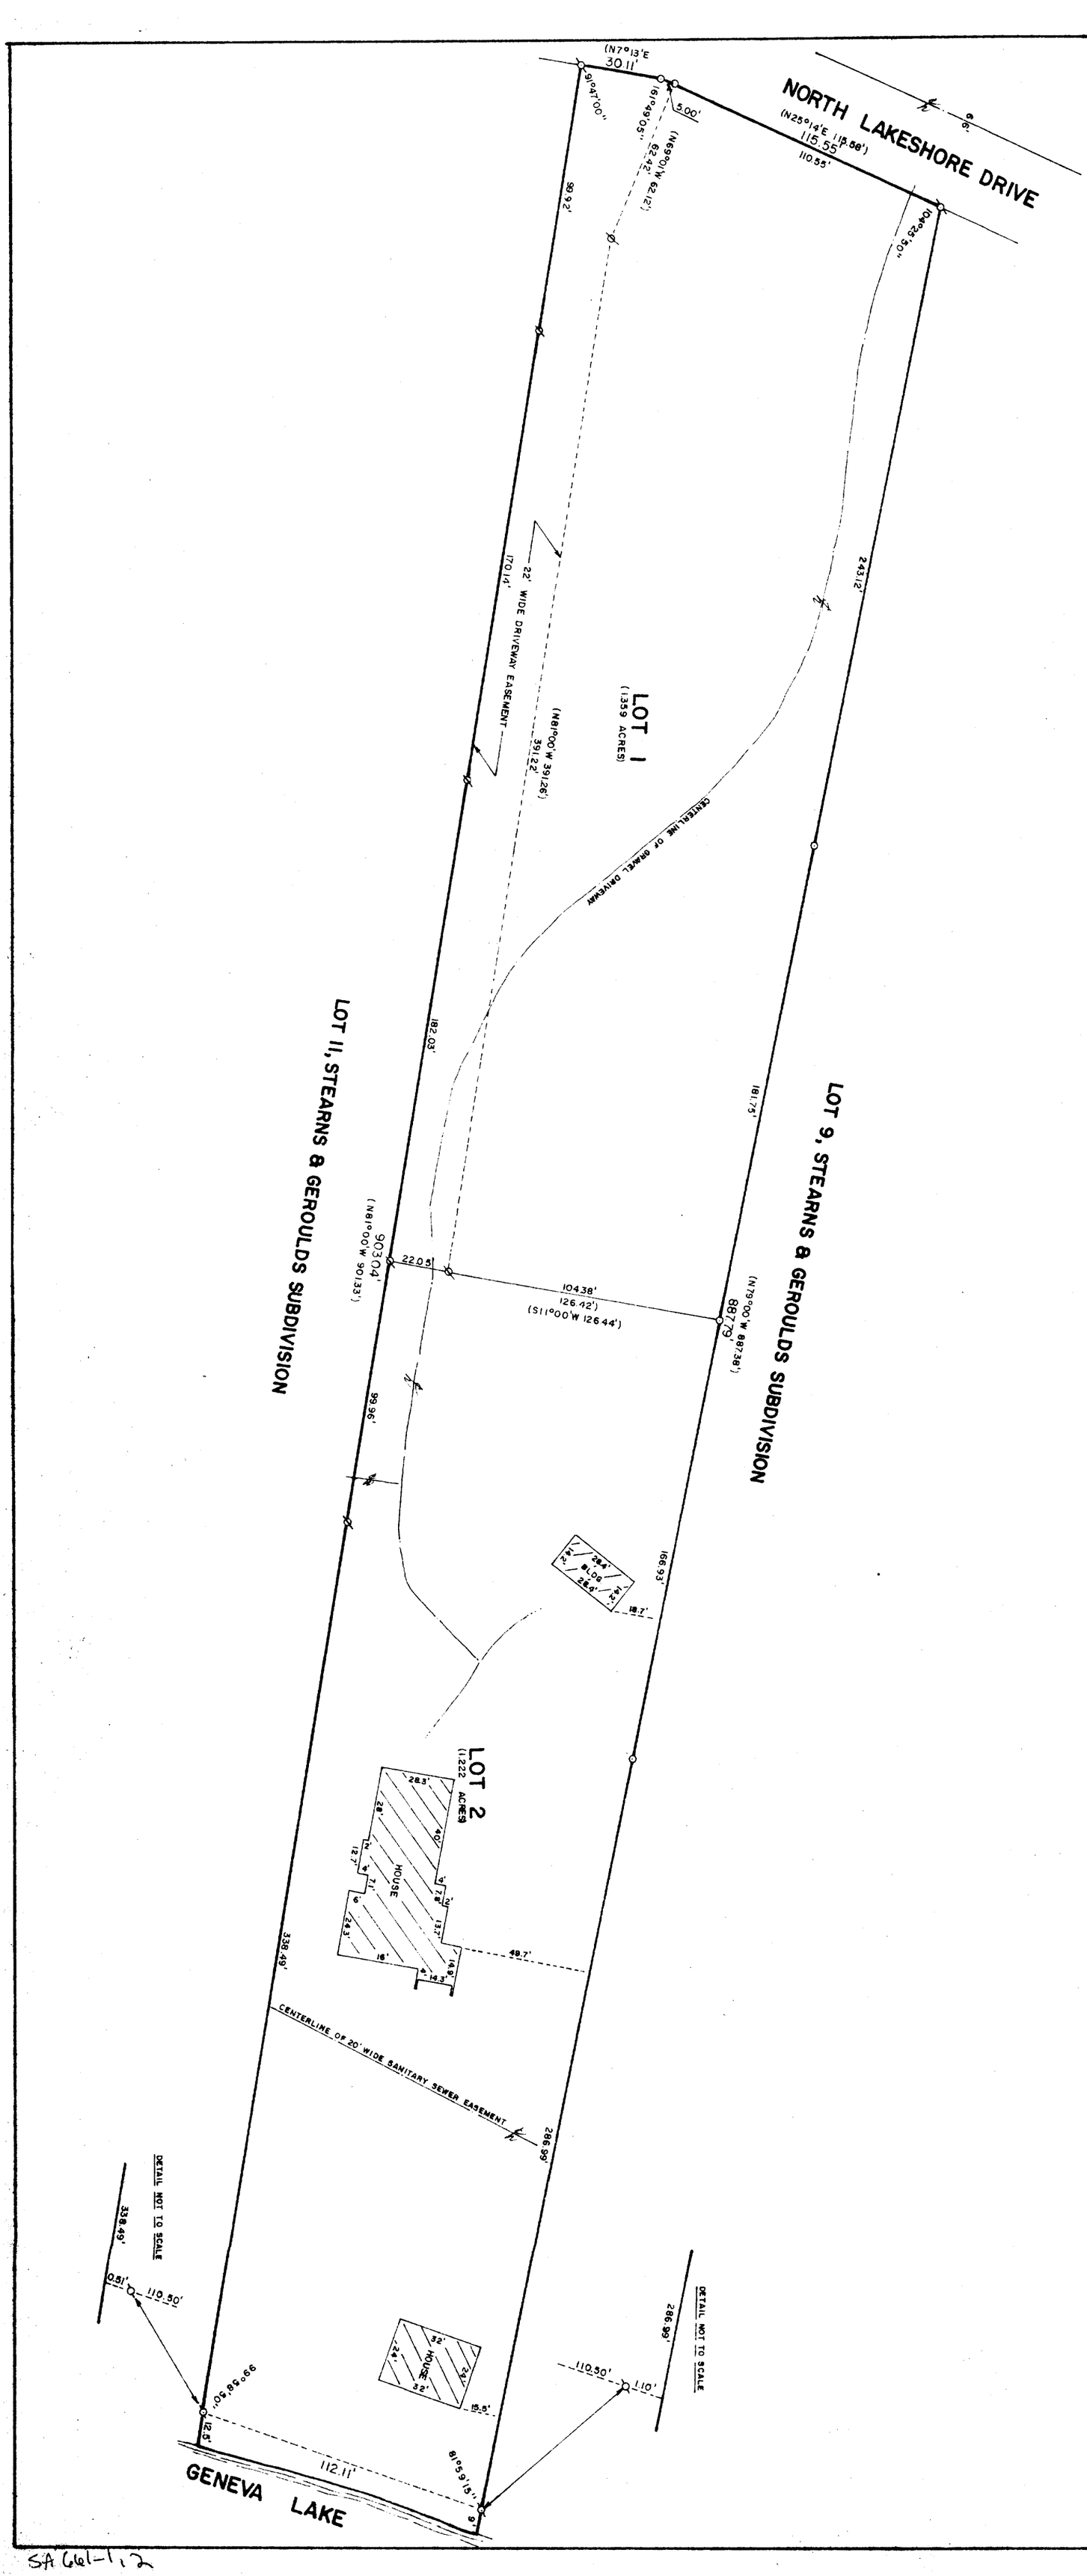


WALWORTH COUNTY
SURVEYING & MAPPING DEPT.
LAKE GENEVA, WISCONSIN

RECEIVED
FEB 4
Drp

PLAT OF SURVEY OF

LOTS 1 AND 2 OF CERTIFIED SURVEY MAP NO. 661, LOCATED IN THE SOUTHWEST 1/4 OF SECTION 11, T 1 N, R 16 E, VILLAGE OF FONTANA-ON-GENEVA LAKE, WALWORTH COUNTY, WISCONSIN.

ORDERED BY: KEEFE REAL ESTATE
724 MAIN STREET
LAKE GENEVA, WISCONSIN 53147

NOTE: THERE ARE NO VISIBLE ENCROACHMENTS.

SCALE: 1"=40'

ø - IRON PIPE FOUND
ø - IRON ROD FOUND
o - IRON ROD PLACED
( ) - RECORDED AS

I, ROBERT M. BAERENWALD, DO HEREBY CERTIFY THAT I HAVE SURVEYED THE PROPERTY HEREON DESCRIBED ACCORDING TO THE OFFICIAL RECORDS AND THAT THE PLAT HEREON IS A CORRECT REPRESENTATION OF THE PROPERTY LINES TO THE BEST OF MY KNOWLEDGE AND BELIEF.

Robert M. Baerenwald
ROBERT M. BAERENWALD
WISCONSIN REGISTERED LAND SURVEYOR, S-1570

Nov. 13, 1986
DATE JOB NO. 5778

SA 661-1, 2

5-6818