I, ROBERT M. BAERENWALD, DO HEREBY CERTIFY THAT I HAVE SURVEYED THE PROPERTY HEREON DESCRIBED ACCORDING TO THE OFFICIAL RECORDS AND THAT THE PLAT HEREON IS A CORRECT REPRESENTATION OF THE PROPERTY LINES TO THE BEST OF MY KNOWLEDGE AND BELIEF.

Robert M. Baerenwald

ROBERT M. BAERENWALD
WISCONSIN REGISTERED LAND SURVEYOR, S-1508

Dec. 15, 1986

DATE JOB NO. 0775

PLAT OF SURVEY OF

LOTS 17, 18, 19 AND THE WESTERLY 15 FEET OF LOT 20, BLOCK 1 OF INDIAN HILLS, LOCATED IN THE VILLAGE OF FONTANA-ON-GENEVA LAKE, WALWORTH COUNTY, WISCONSIN.

ORDERED BY: KEEFE REAL ESTATE
704 MAIN STREET
LAKE GENEVA, WISCONSIN 53147

SCALE: 1"=30'

ø-IRON PIPE FOUND
()-RECORDED AS

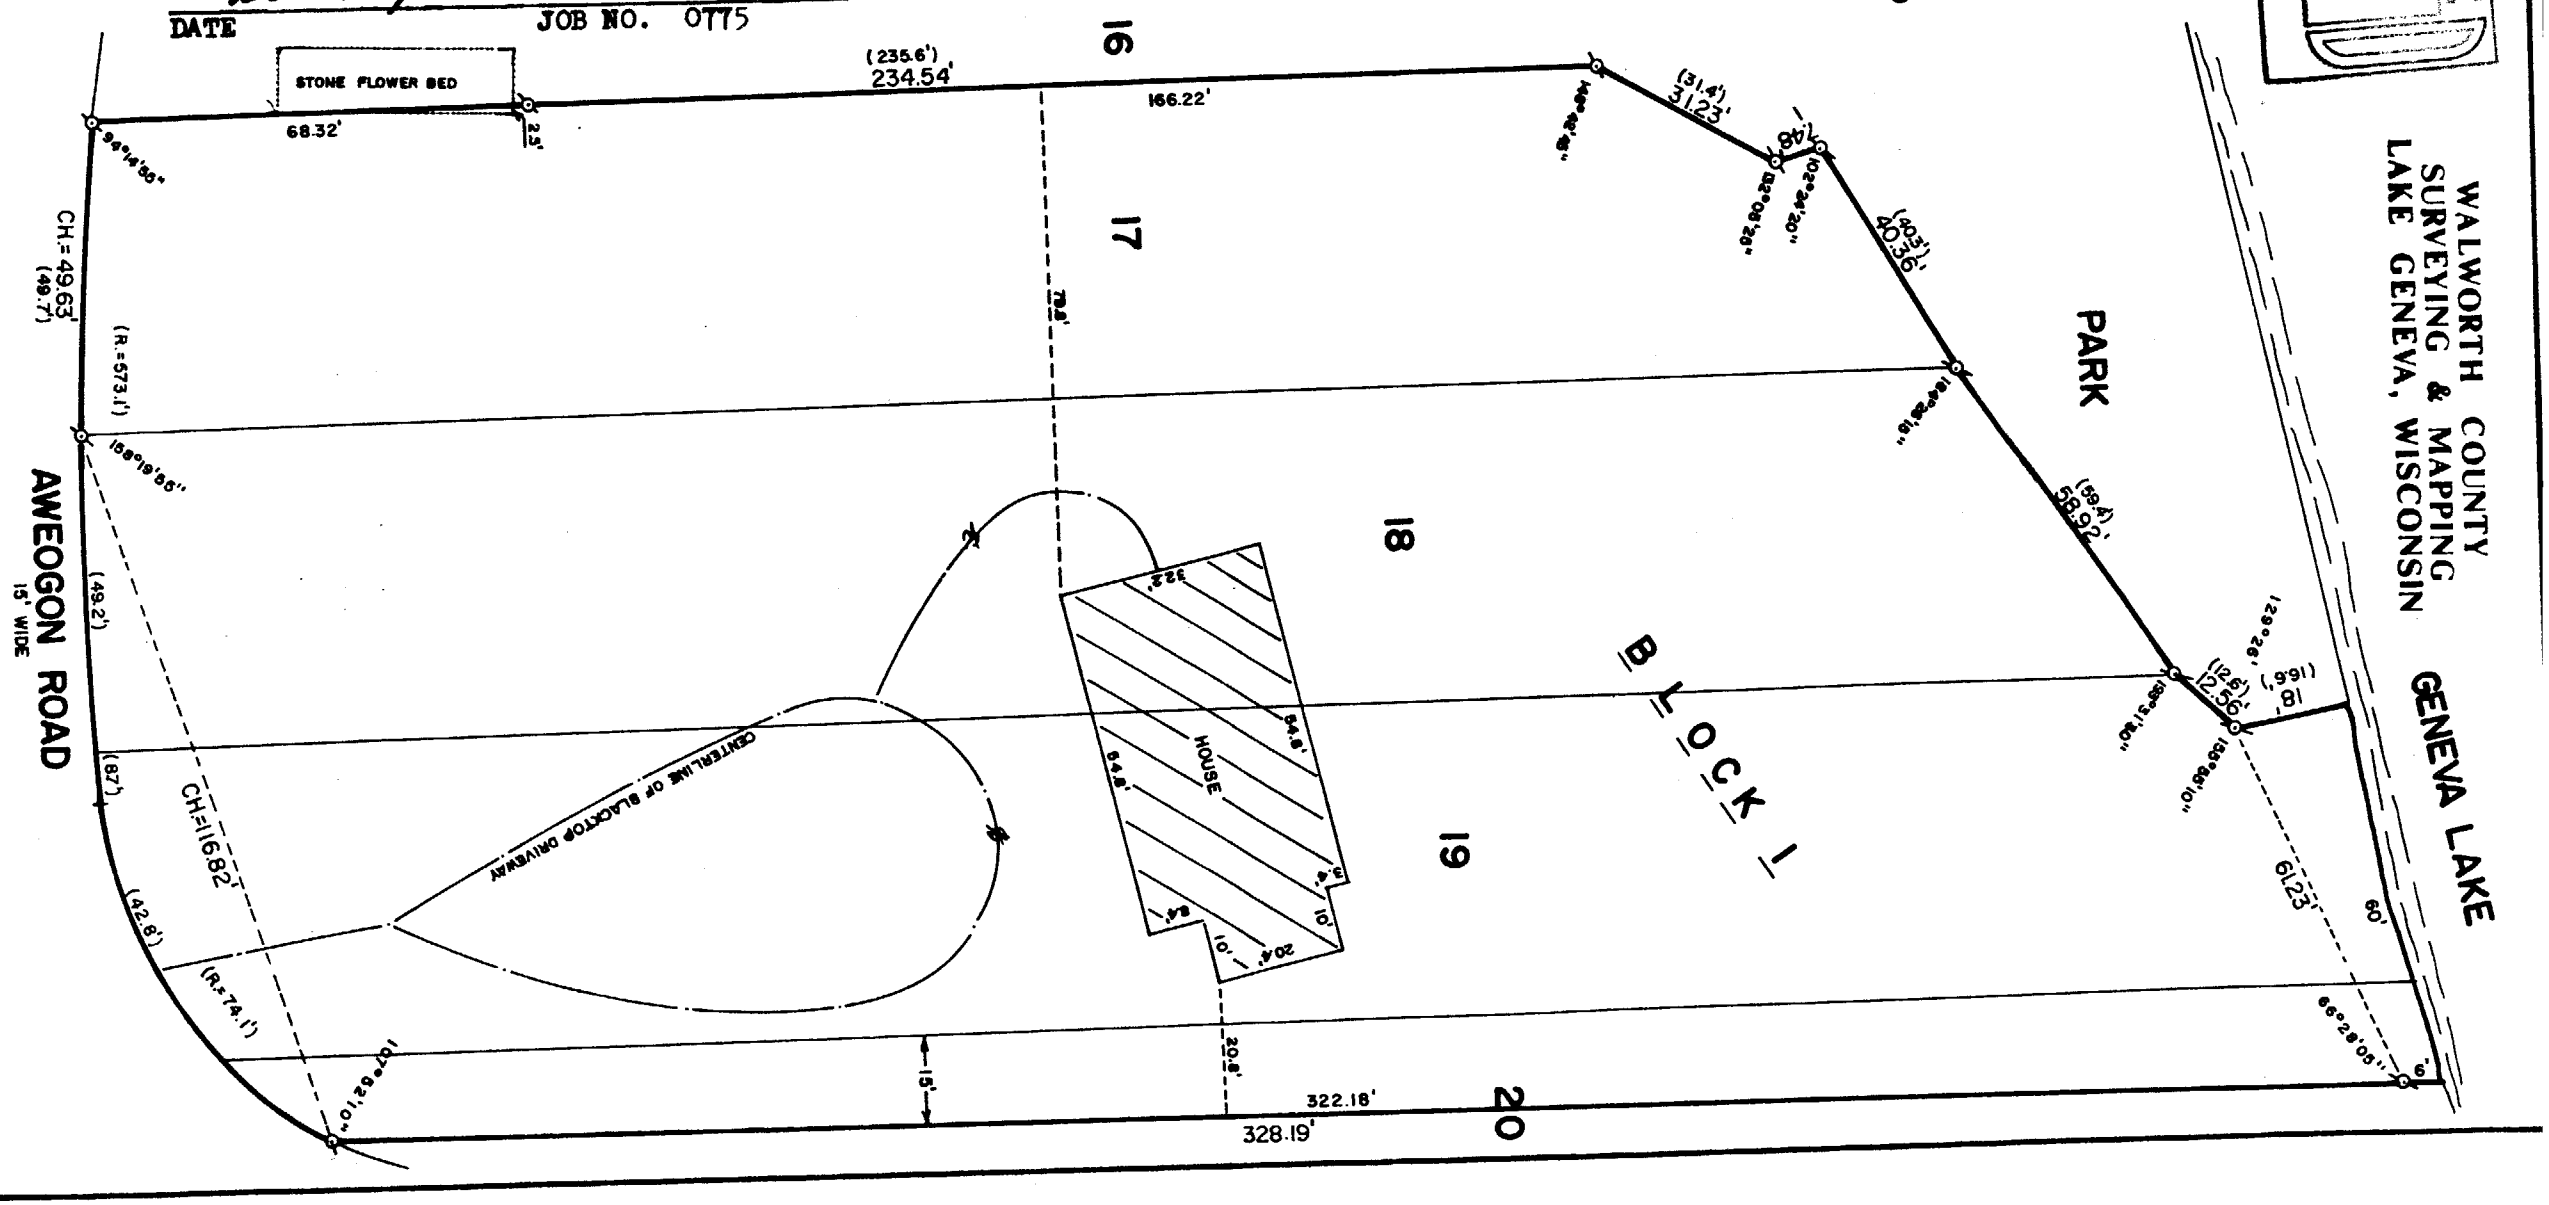

RECEIVED

S14-18

5-689