
WALWORTH COUNTY
SURVEYING & MAPPING
LAKE GENEVA, WISCONSIN

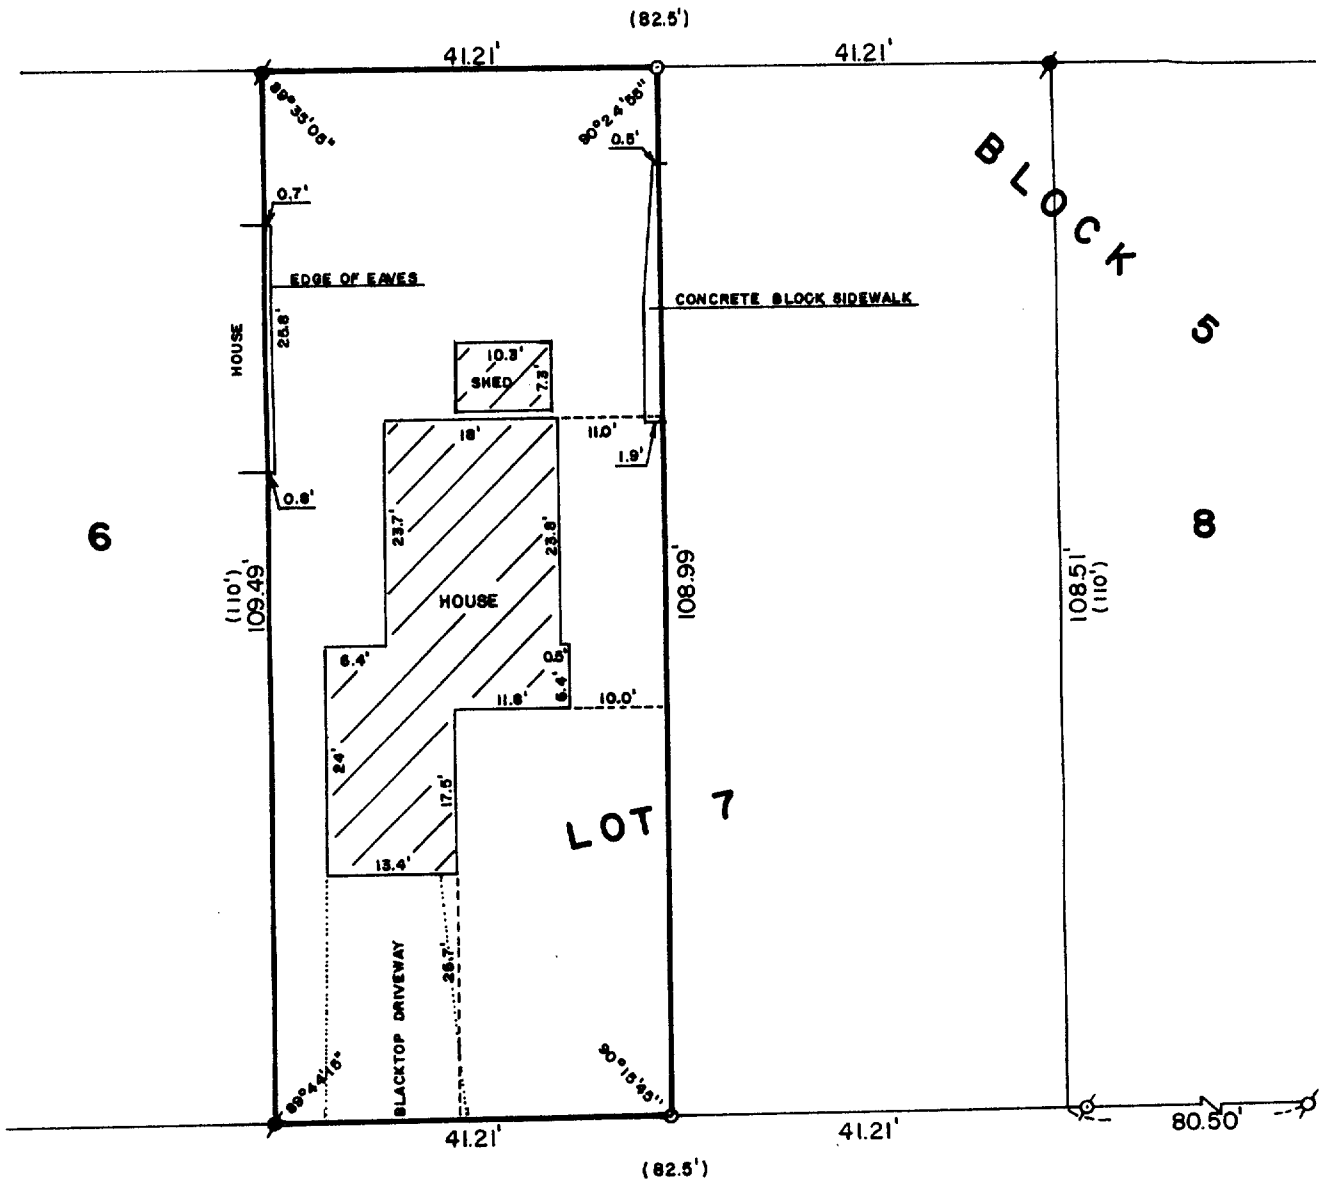

THIRD AVENUE

RECEIVED

PLAT OF SURVEY OF

THE WEST 1/2 OF LOT 7, BLOCK 5 OF THE ORIGINAL PLAT OF THE VILLAGE OF FONTANA-ON-GENEVA LAKE, WALWORTH COUNTY, WISCONSIN.

ORDERED BY: LAKELAND REALTY
BOX 323
FONTANA, WISCONSIN 53125

SCALE: 1"=20'

ø -IRON PIPE FOUND
● -CONCRETE MONUMENT FOUND
o -IRON ROD PLACED
( ) -RECORDED AS

I, ROBERT M. BAERENWALD, DO HEREBY CERTIFY THAT I HAVE SURVEYED THE PROPERTY HEREON DESCRIBED ACCORDING TO THE OFFICIAL RECORDS AND THAT THE PLAT HEREON IS A CORRECT REPRESENTATION OF THE PROPERTY LINES TO THE BEST OF MY KNOWLEDGE AND BELIEF.

Robert M. Baerenwald
ROBERT M. BAERENWALD
WISCONSIN REGISTERED LAND SURVEYOR, S-1508

Nov. 10, 1986
DATE JOB NO. 0831

NOTE: THIS IS NOT A CERTIFIED COPY UNLESS SEALED.

SOP-33

5-689B